

7.5.09


PROFILE & DECK PLAN

N^o 455


Scale $\frac{1}{4} = 1$ FOOT

PLAN No 2562
FOR ENGINEERS
Lloyd Register
Hull FROM
COCHRANE & SONS
SHIPBUILDERS SE
DATE 2/5/09 RR

NOTE. PILLARS THROUGHOUT TO SURVEYORS SATISFACTION.

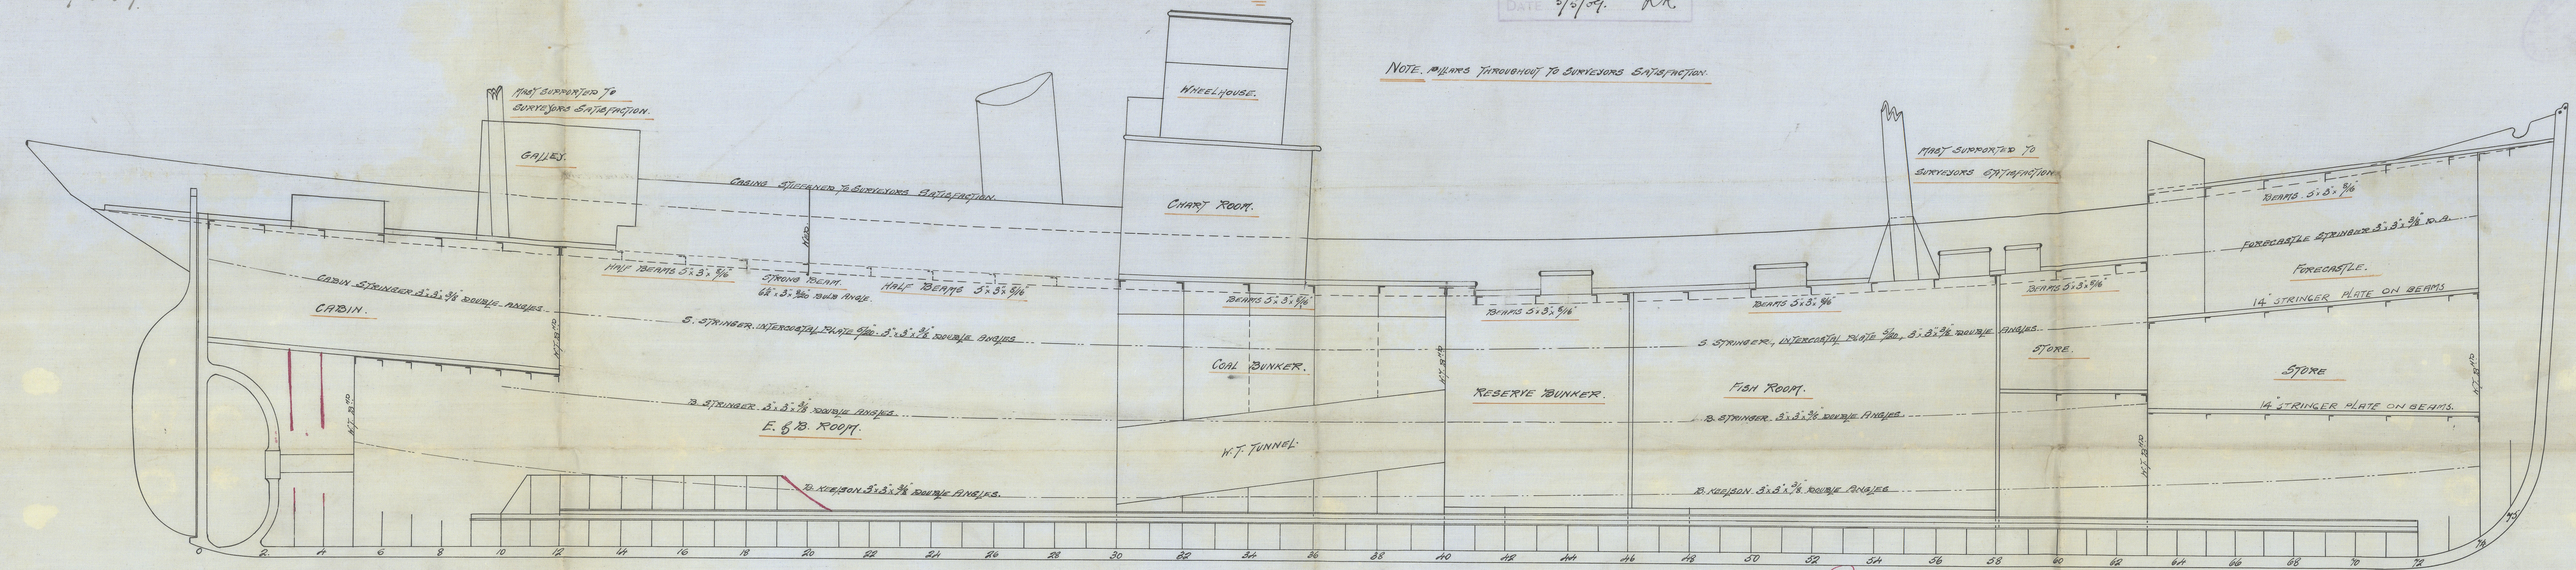

Pillars throughout to Surveyors Satisfaction

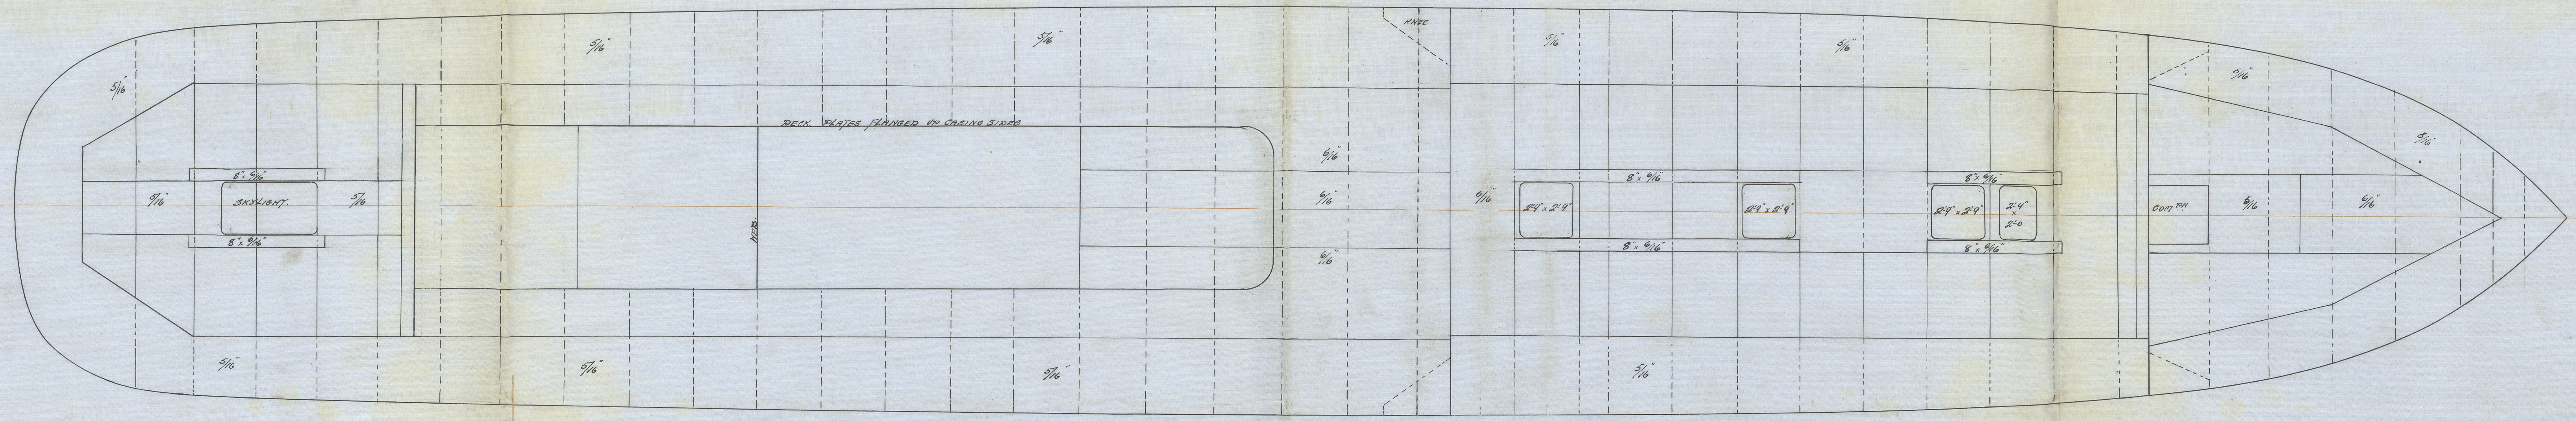

Drawn
7.5.09

2115. at 1000 ft
mod 9. 1000 ft 1000 ft
22. 1000 ft
22. 1000 ft

