

# MIDSHIP SECTION

Nº 455

DIM. 128'-0" x 22'-0" EX x 13'-4" MLD

SCALE  $\frac{1}{2}'' = 1 \text{ FOOT}$ .

TO CLASS 100.A.1. FOR FISHING PURPOSES.

ENGINE & BOILER CASING AS PREVIOUSLY APPROVED

DECK PLATED IN WAY OF ENGINE + BOILER SPACE.

# NUMERALS

✓  $\frac{1}{2}$  GIRTH 20.5

✓  $\frac{1}{2}$  BREADTH 10.95

✓ DEPTH 13.75

✓ 45.85 <sup>1ST NO</sup>

✓ LENGTH PER ROLL 126.87

5734.55 <sup>2ND NO</sup>

## PROPORTIONS


$$\begin{array}{r} 9.2 \\ 5.8 \\ \hline \end{array}$$

## EQUIPMENT.

EQUIPMENT			
✓ 1ST BOWER	5 $\frac{3}{4}$	CWTs EX STOCK OR $\frac{7}{4}$ CWTs STOCKLESS.	
✓ 2ND "	5 $\frac{1}{4}$	"	"
✓ 3RD "	3	"	"
✓ 105 FATHOMS	1 $\frac{1}{2}$	CABLE	
✓ 60 "	6"	HAWSER	
✓ 60 "	5"	WARP	

# RIVETING

- ✓ BUTTS OF SHELL PLATING LAPPED
- ✓ DOUBLE RIVETED. EXCEPT GARBOARD
- ✓ SHEERSTAKE WHICH ARE TO BE STRAPPED.
- ✓ LANDINGS DOUBLE RIVETED. BULWARKS SINGLE RIV.
- ✓ BUTTS OF STRINGER & TIE PLATES OVERLAPPED
- ✓ DOUBLE RIVETED.

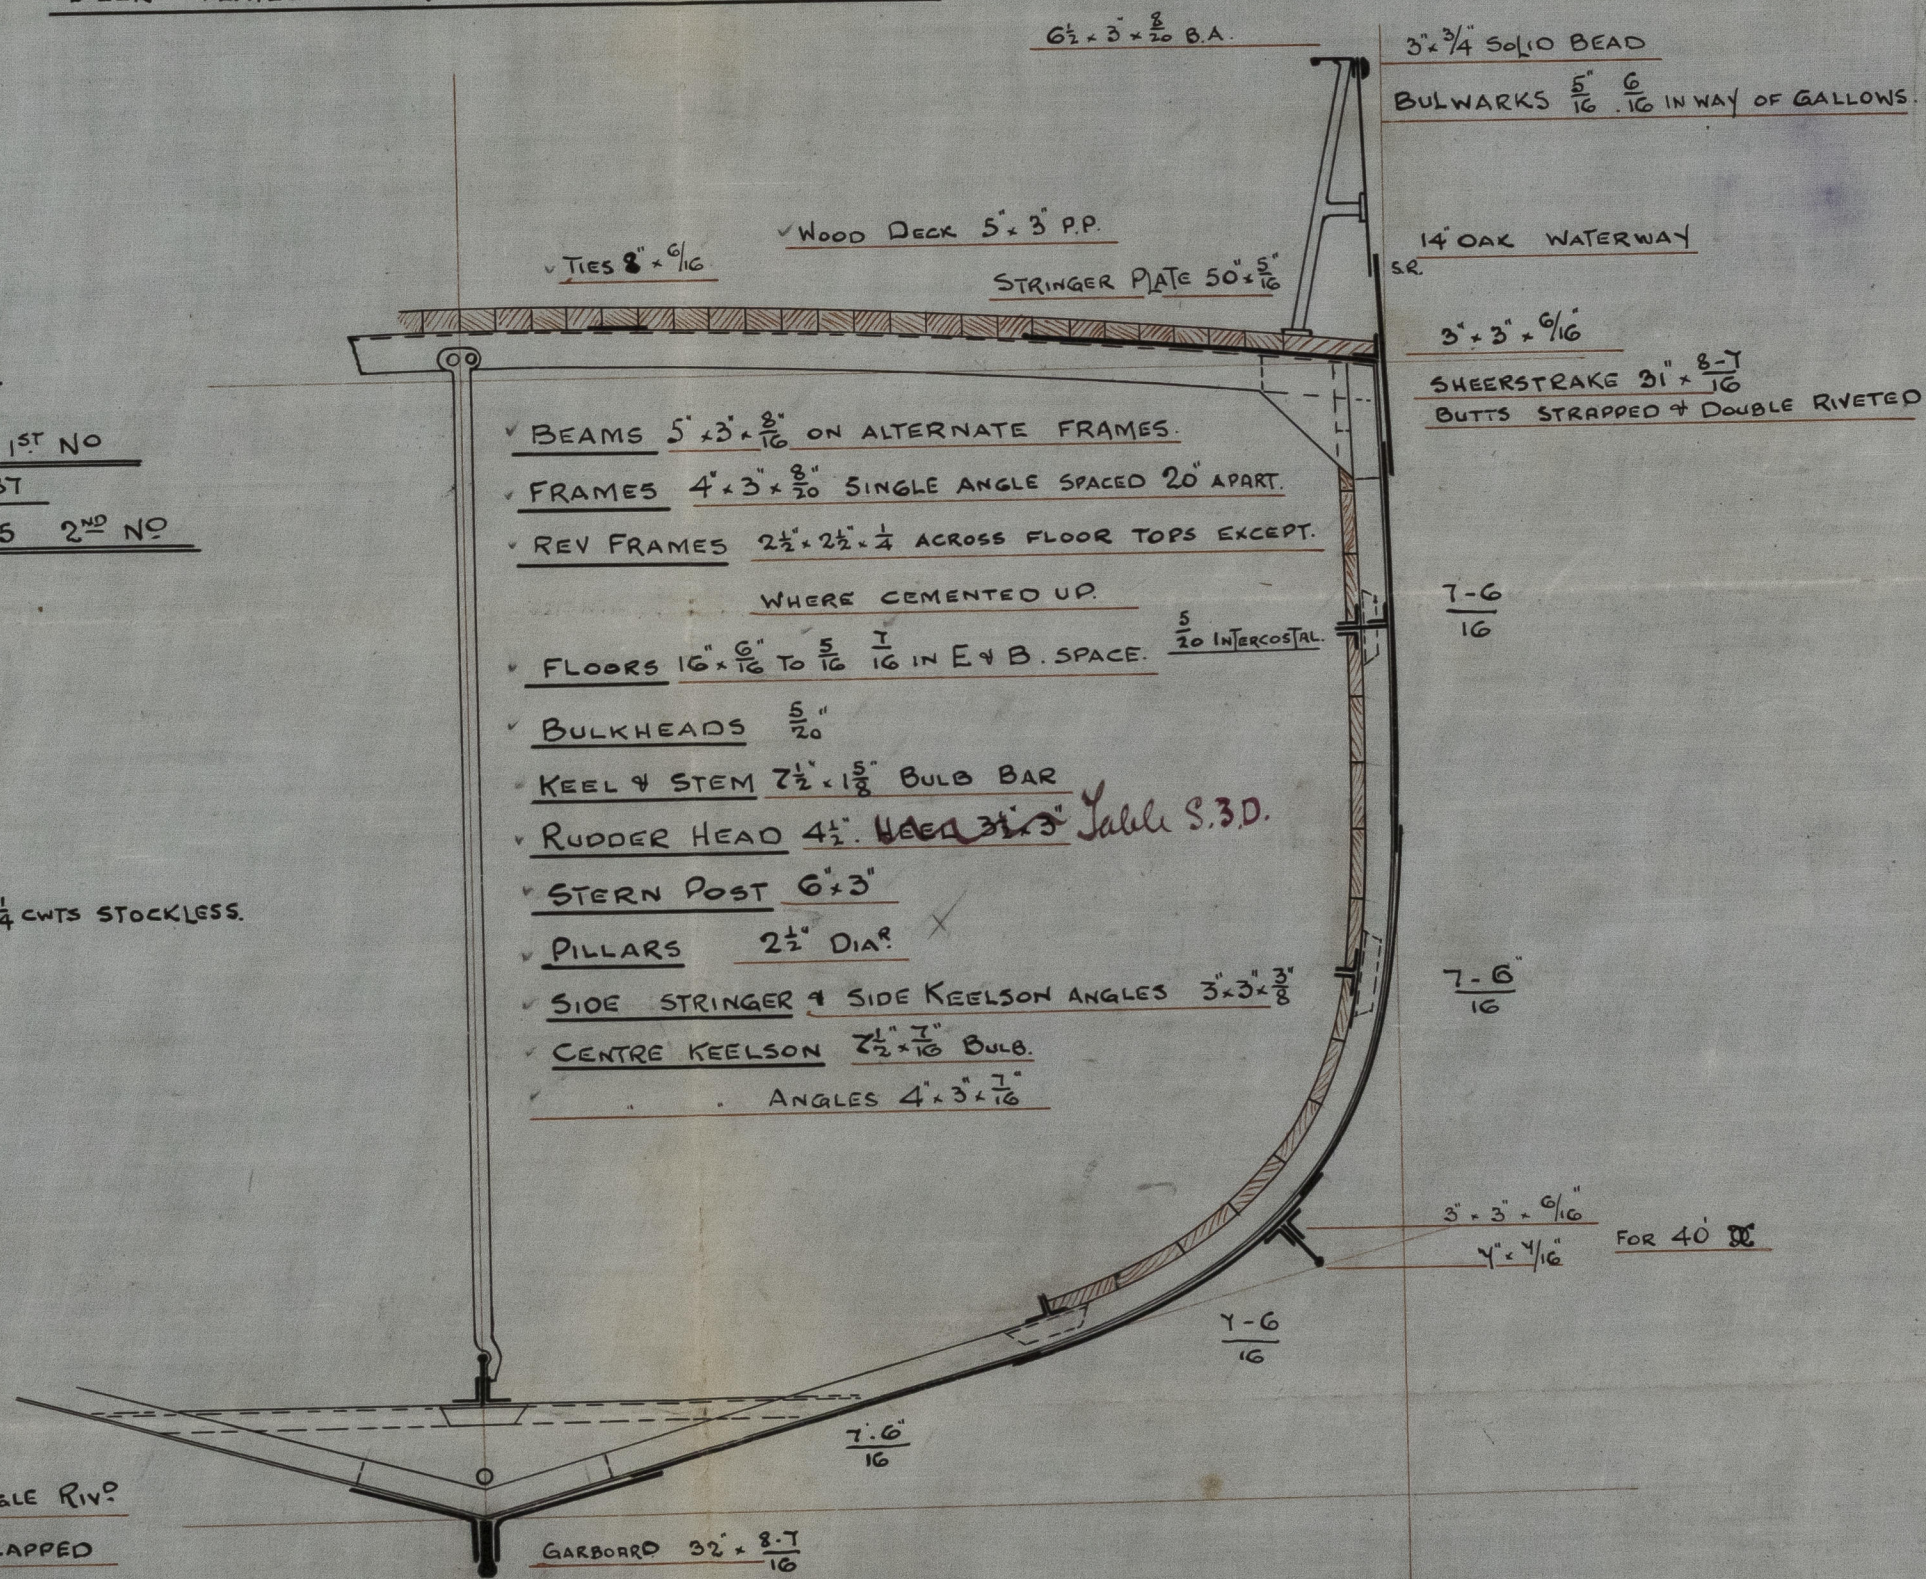

ans  
6-5-00



