MIDSHIP SECTION No 251 P/TUG

Also No 252
app. 7/1/05

DIMENSIONS 100' × 20' × 10'-4" M.A.

CLASS 100 A. LLOYDS FOR TOWING PURPOSES

SCALE 3/4" = 1 FOOT

N. 10.04
(No 252) 7.1.05

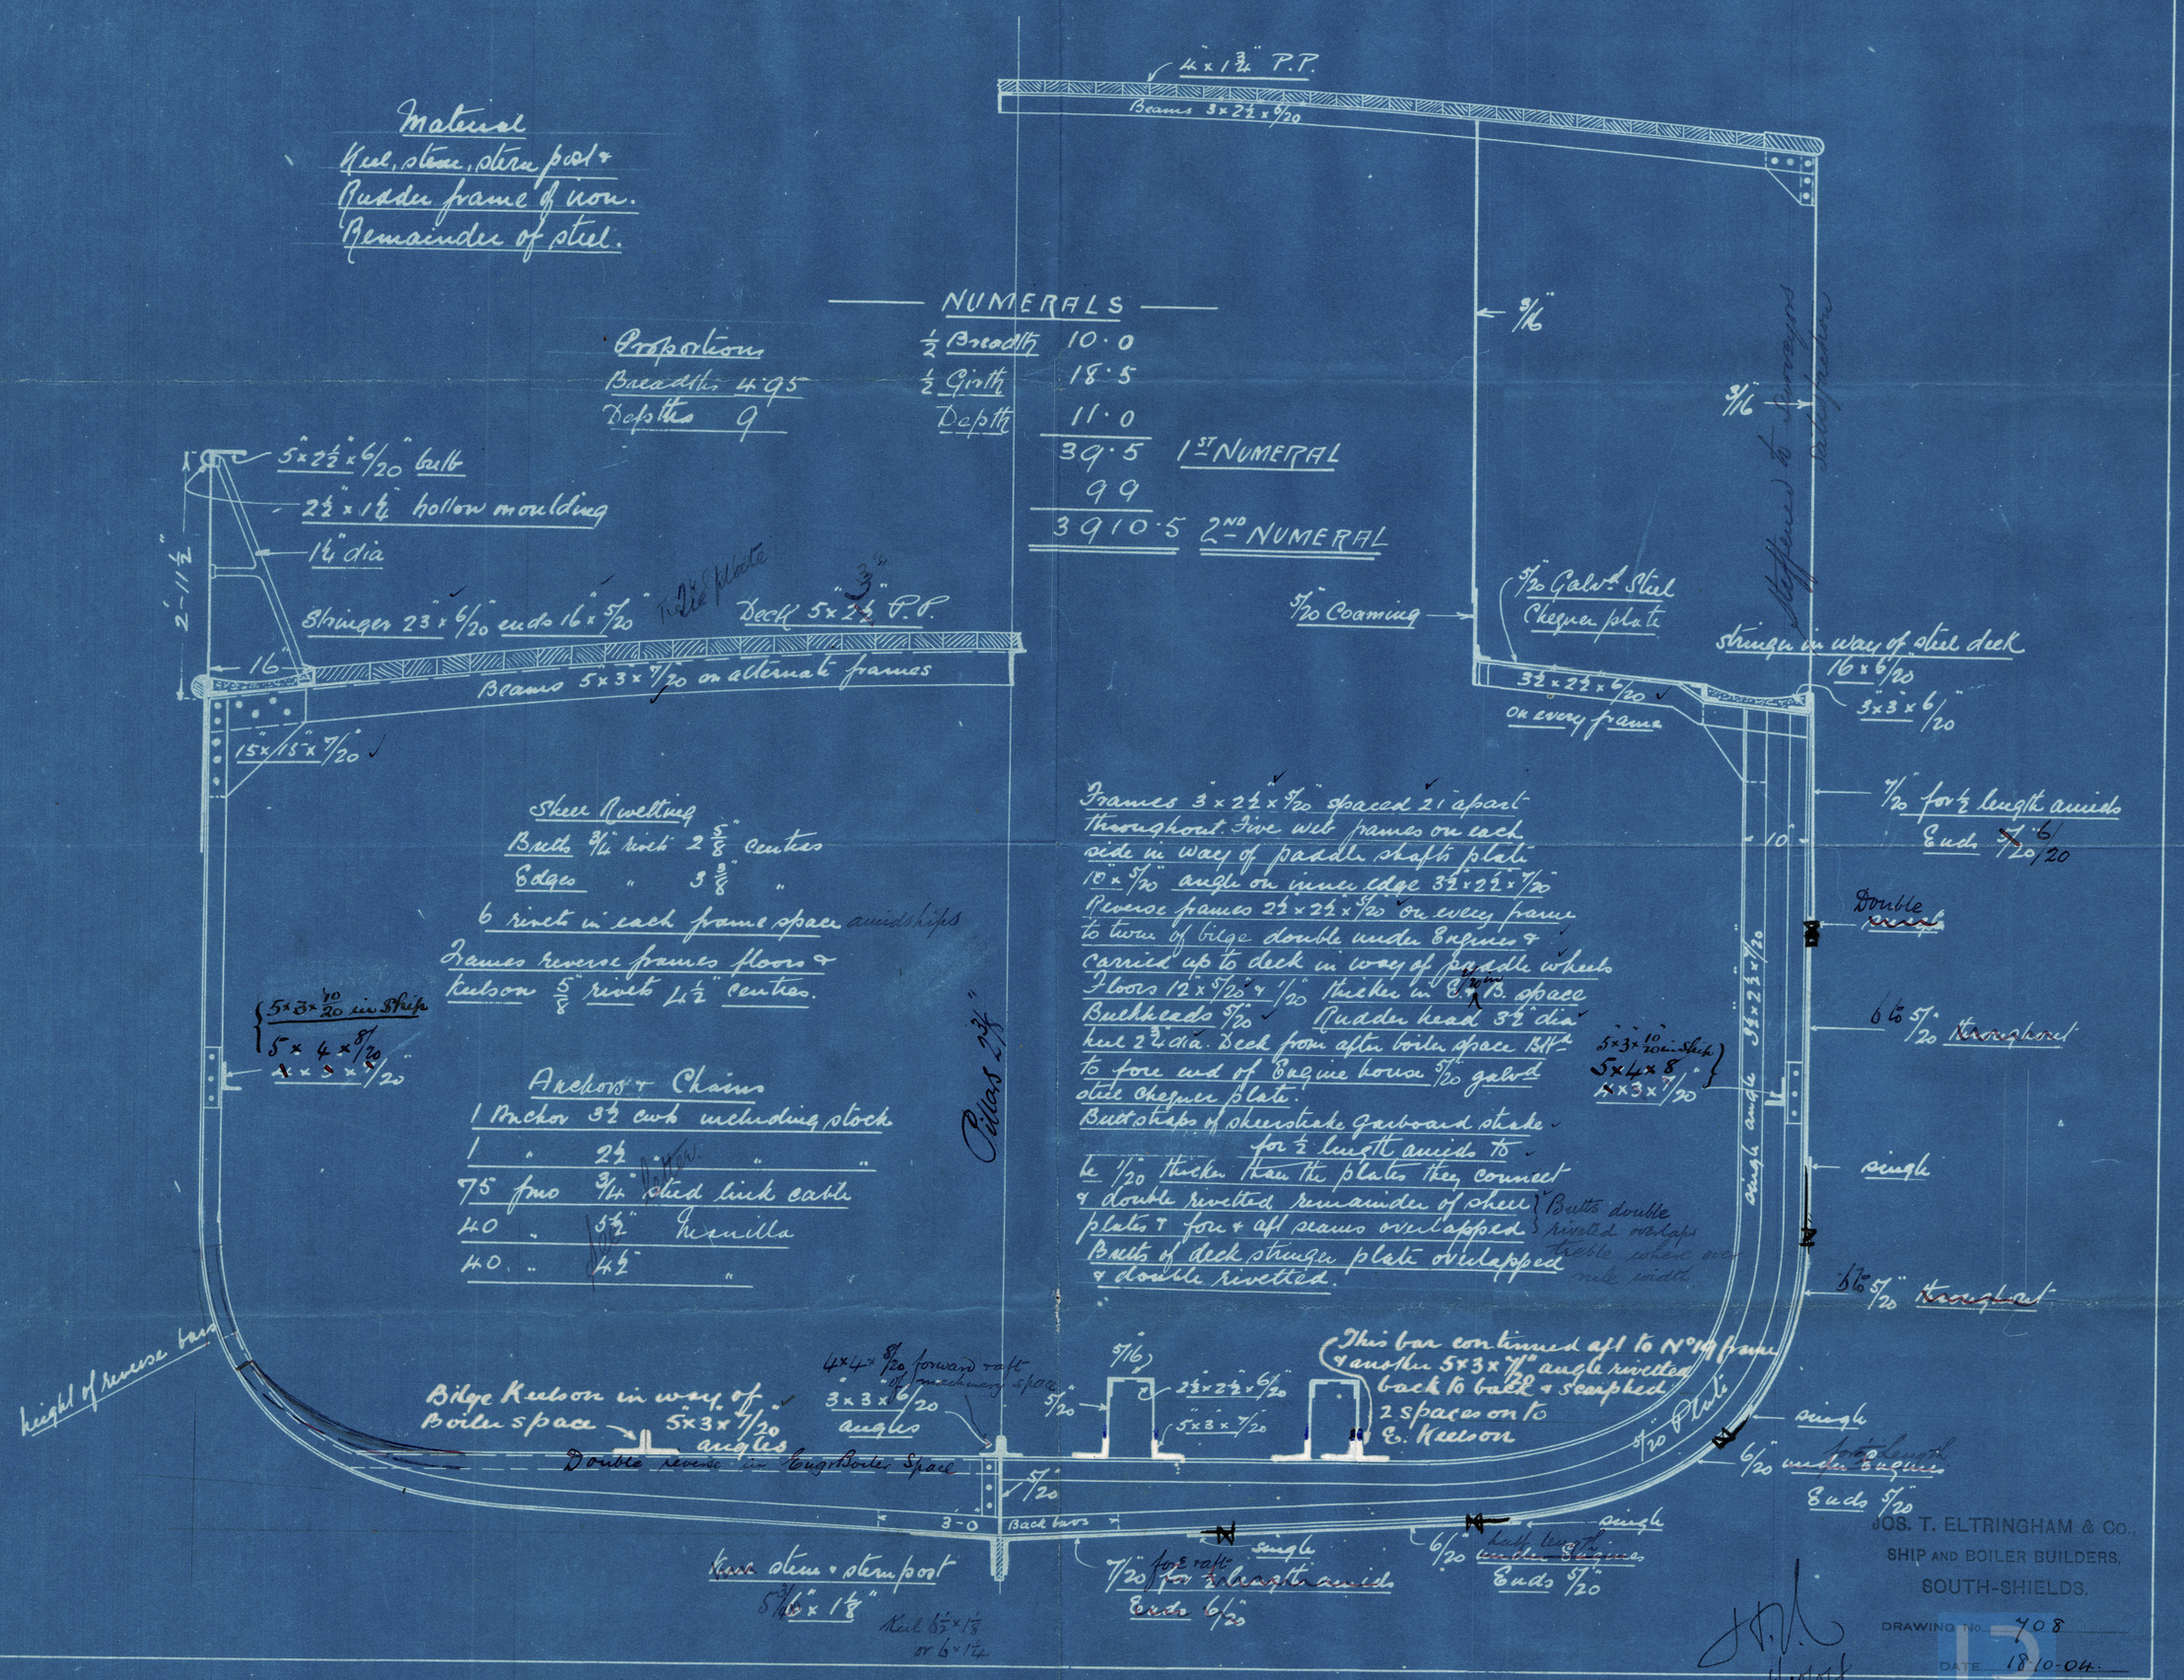

JOS. T. ELTRINGHAM & Co.,
SHIP AND BOILER BUILDERS,
SOUTH-SHIELDS.

DRAWING No. 708

DATE 18-10-04.

24/10/04

Lloyd's Register Library
005918 005942 0103

Newcastle on-Tyne

Midship Section of

Messrs J T Eltringham & Co's

Yard No 251 & 252

Steel Paddle Tug

LLOYD'S REGISTER OF SHIPPING
22 OCT. 1904
LONDON

LLOYD'S REGISTER OF SHIPPING
RECEIVED
7 - JAN 1905
LONDON

S. No 251 "RIXTON"

LLOYD'S REGISTER OF SHIPPING
RECEIVED
7 - FEB. 1905
LONDON

Newcastle Report

No 48689

© 2020
Lloyd's Register Foundation

005929 - 005942 - 0103