


CLASS 100A.1.
STEAM TRAWLER
STEEL

EQUIPMENT			
1	ANCHOR	64 LBS	EX STOCK
1	"	53/4	" "
1	"	3/4	" "
120	FT HWS	1/8"	CHAIN
60	"	6	HAWSER
150	"	5	WARP

1/2 GIRTH 21.41
1/2 BREAOTH 11.98
DEPTH 13.06
 47.00
1/2 DS LENGTH 133.82
 6289.54
 $\frac{L}{B} = 5.06$ $\frac{L}{D} = 9.07$

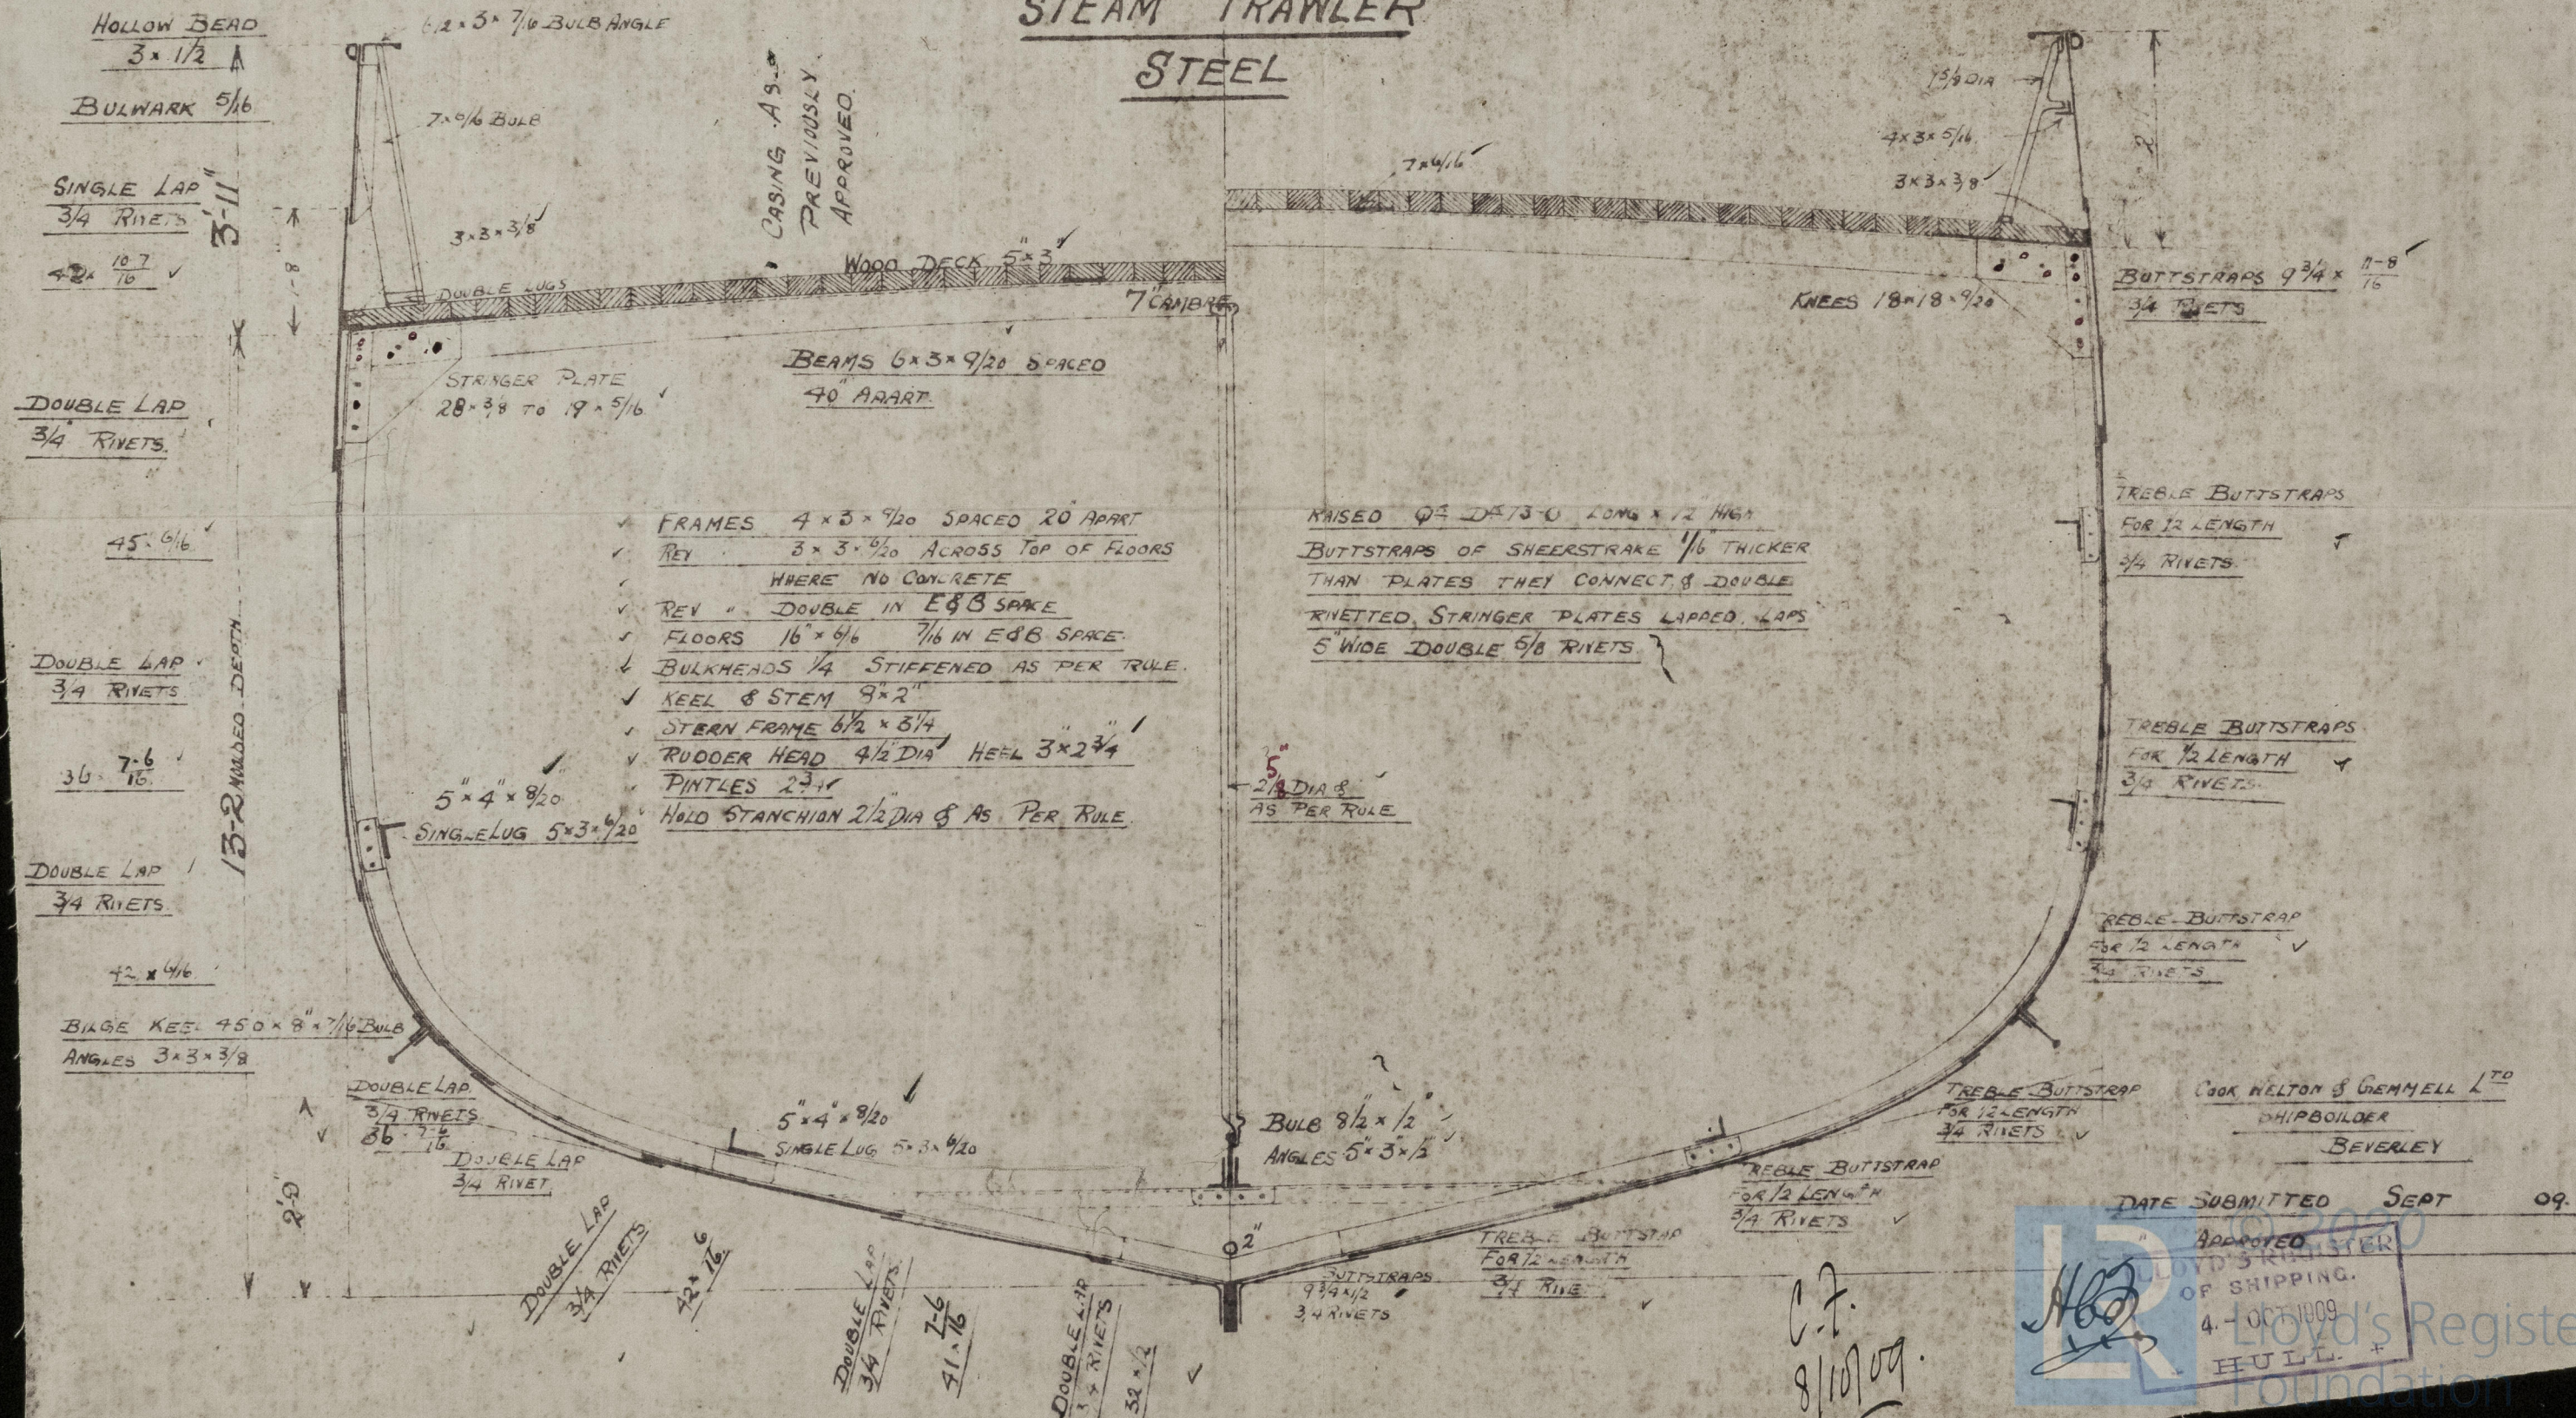


- Midship Section-
book Welton Lemmick

No 192

s/ 'Alberca'

Hull Report No. 22273

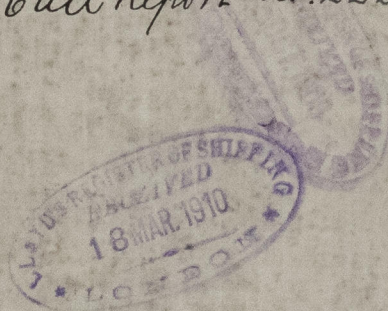

© 2020

Lloyd's Register
Foundation

005929-005942-0108

005929-005942-0108