


8.10.09

*Modifications
Running for Anticipation*

*Supports & Runways
Anticipation*

— WHALE BACK —
PLATING 5/16
BEAMS 3 1/2 x 3 x 3/8 SPACED 2'-9" APART

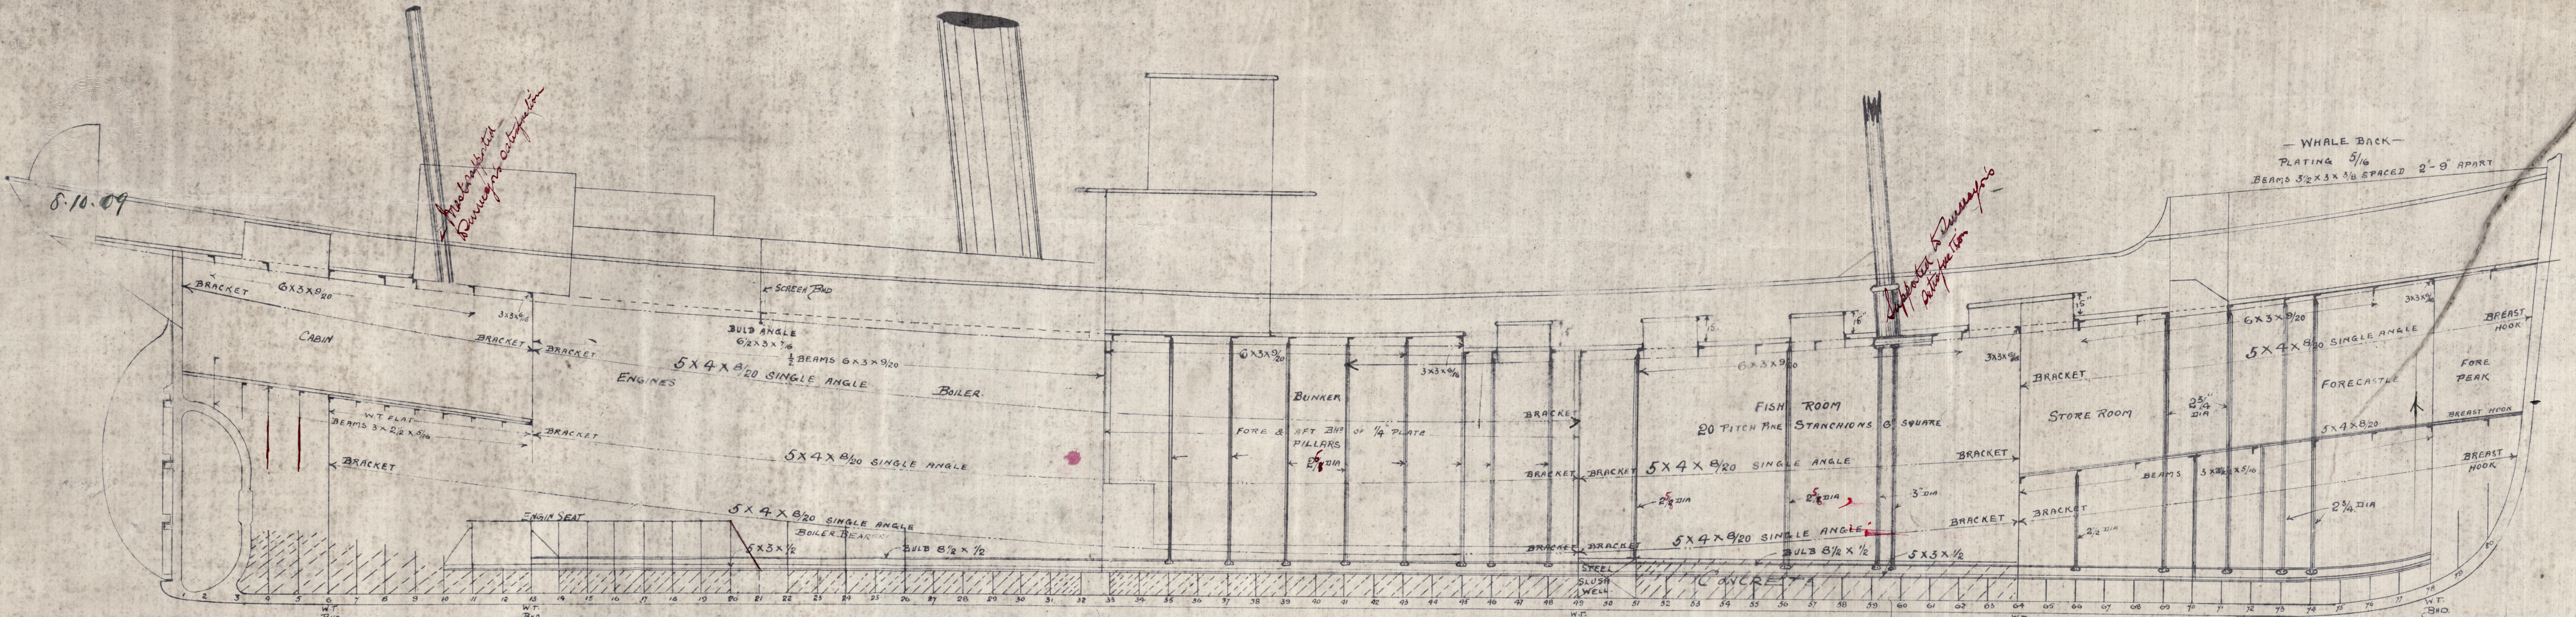


BEAM ARRANGEMENT

PILLARS TO SURVEYORS SATISFACTION THROUGHOUT
— SCALE 1/4" = 1 FOOT —

Nº192

COOK WELTON & GEMMELL LTD
SHIPBUILDERS
BEVERLEY
DATE SUBMITTED OCT
APPROVED "

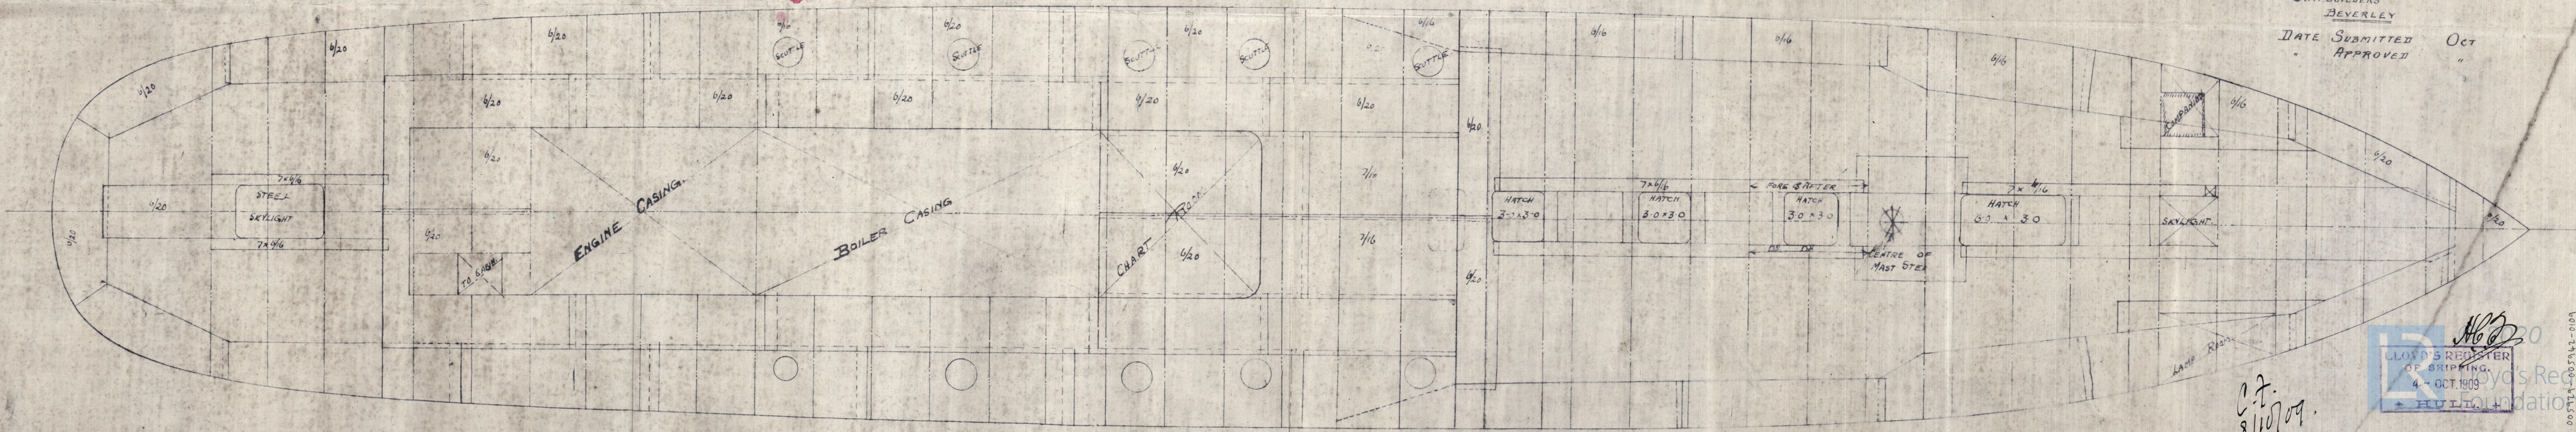

Profile & Deck Plan -
book Welton Gemmell & Co

No 192

of alberia

Hull Report No. 22273



005929-005942-0109

© 2020

Lloyd's Register
Foundation