


21.5.10.
3.6.10

13/5/10
S. S. Nos 135 & 136.

S. S. Nos 135 & 136.
— LONGITUDINAL SECTION. —

DIMS: 126'-8" B.P. x 23'-0" EX. x 12'-6" M.H.
SCALE 1/4" IN. = 1 FT.

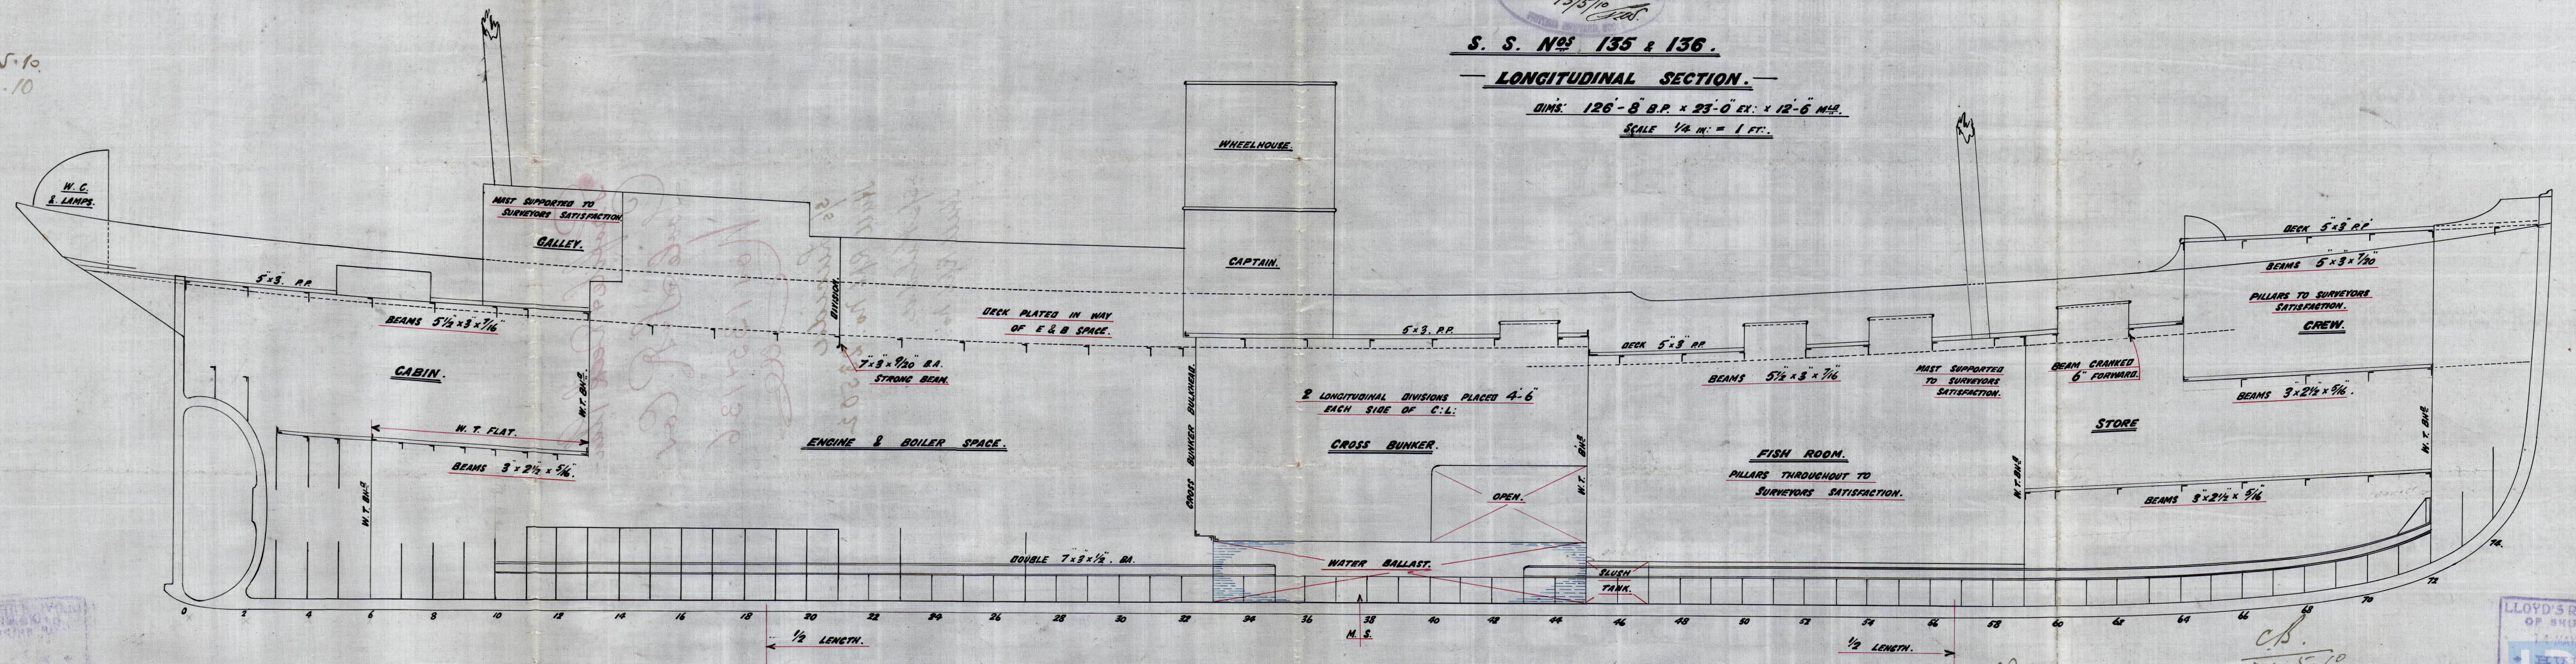

LLOYD'S REGISTER
OF SHIPPING
12 MAY 1910
HULL

Profile & Deck Plan-
Look S & R. Cos
Nos 135 & 136

s/s Lucida
Hull Rpt No. 23502

s/s Hilda
Hull Rpt No.



© 2020

Lloyd's Register
Foundation