


## ***RUDDER & STERNFRAME.***

SCALE  $\frac{3}{4}$  IN. = 1 FOOT.

RUDDER FRAME: RIVET HOLES  $\frac{13}{16}$ " DIA. SPACED  $3\frac{3}{4}$ " APART C. TO C.  
STERN FRAME: " "  $1\frac{1}{16}$ " " 5" " " " "

TO PASS LLOYDS.

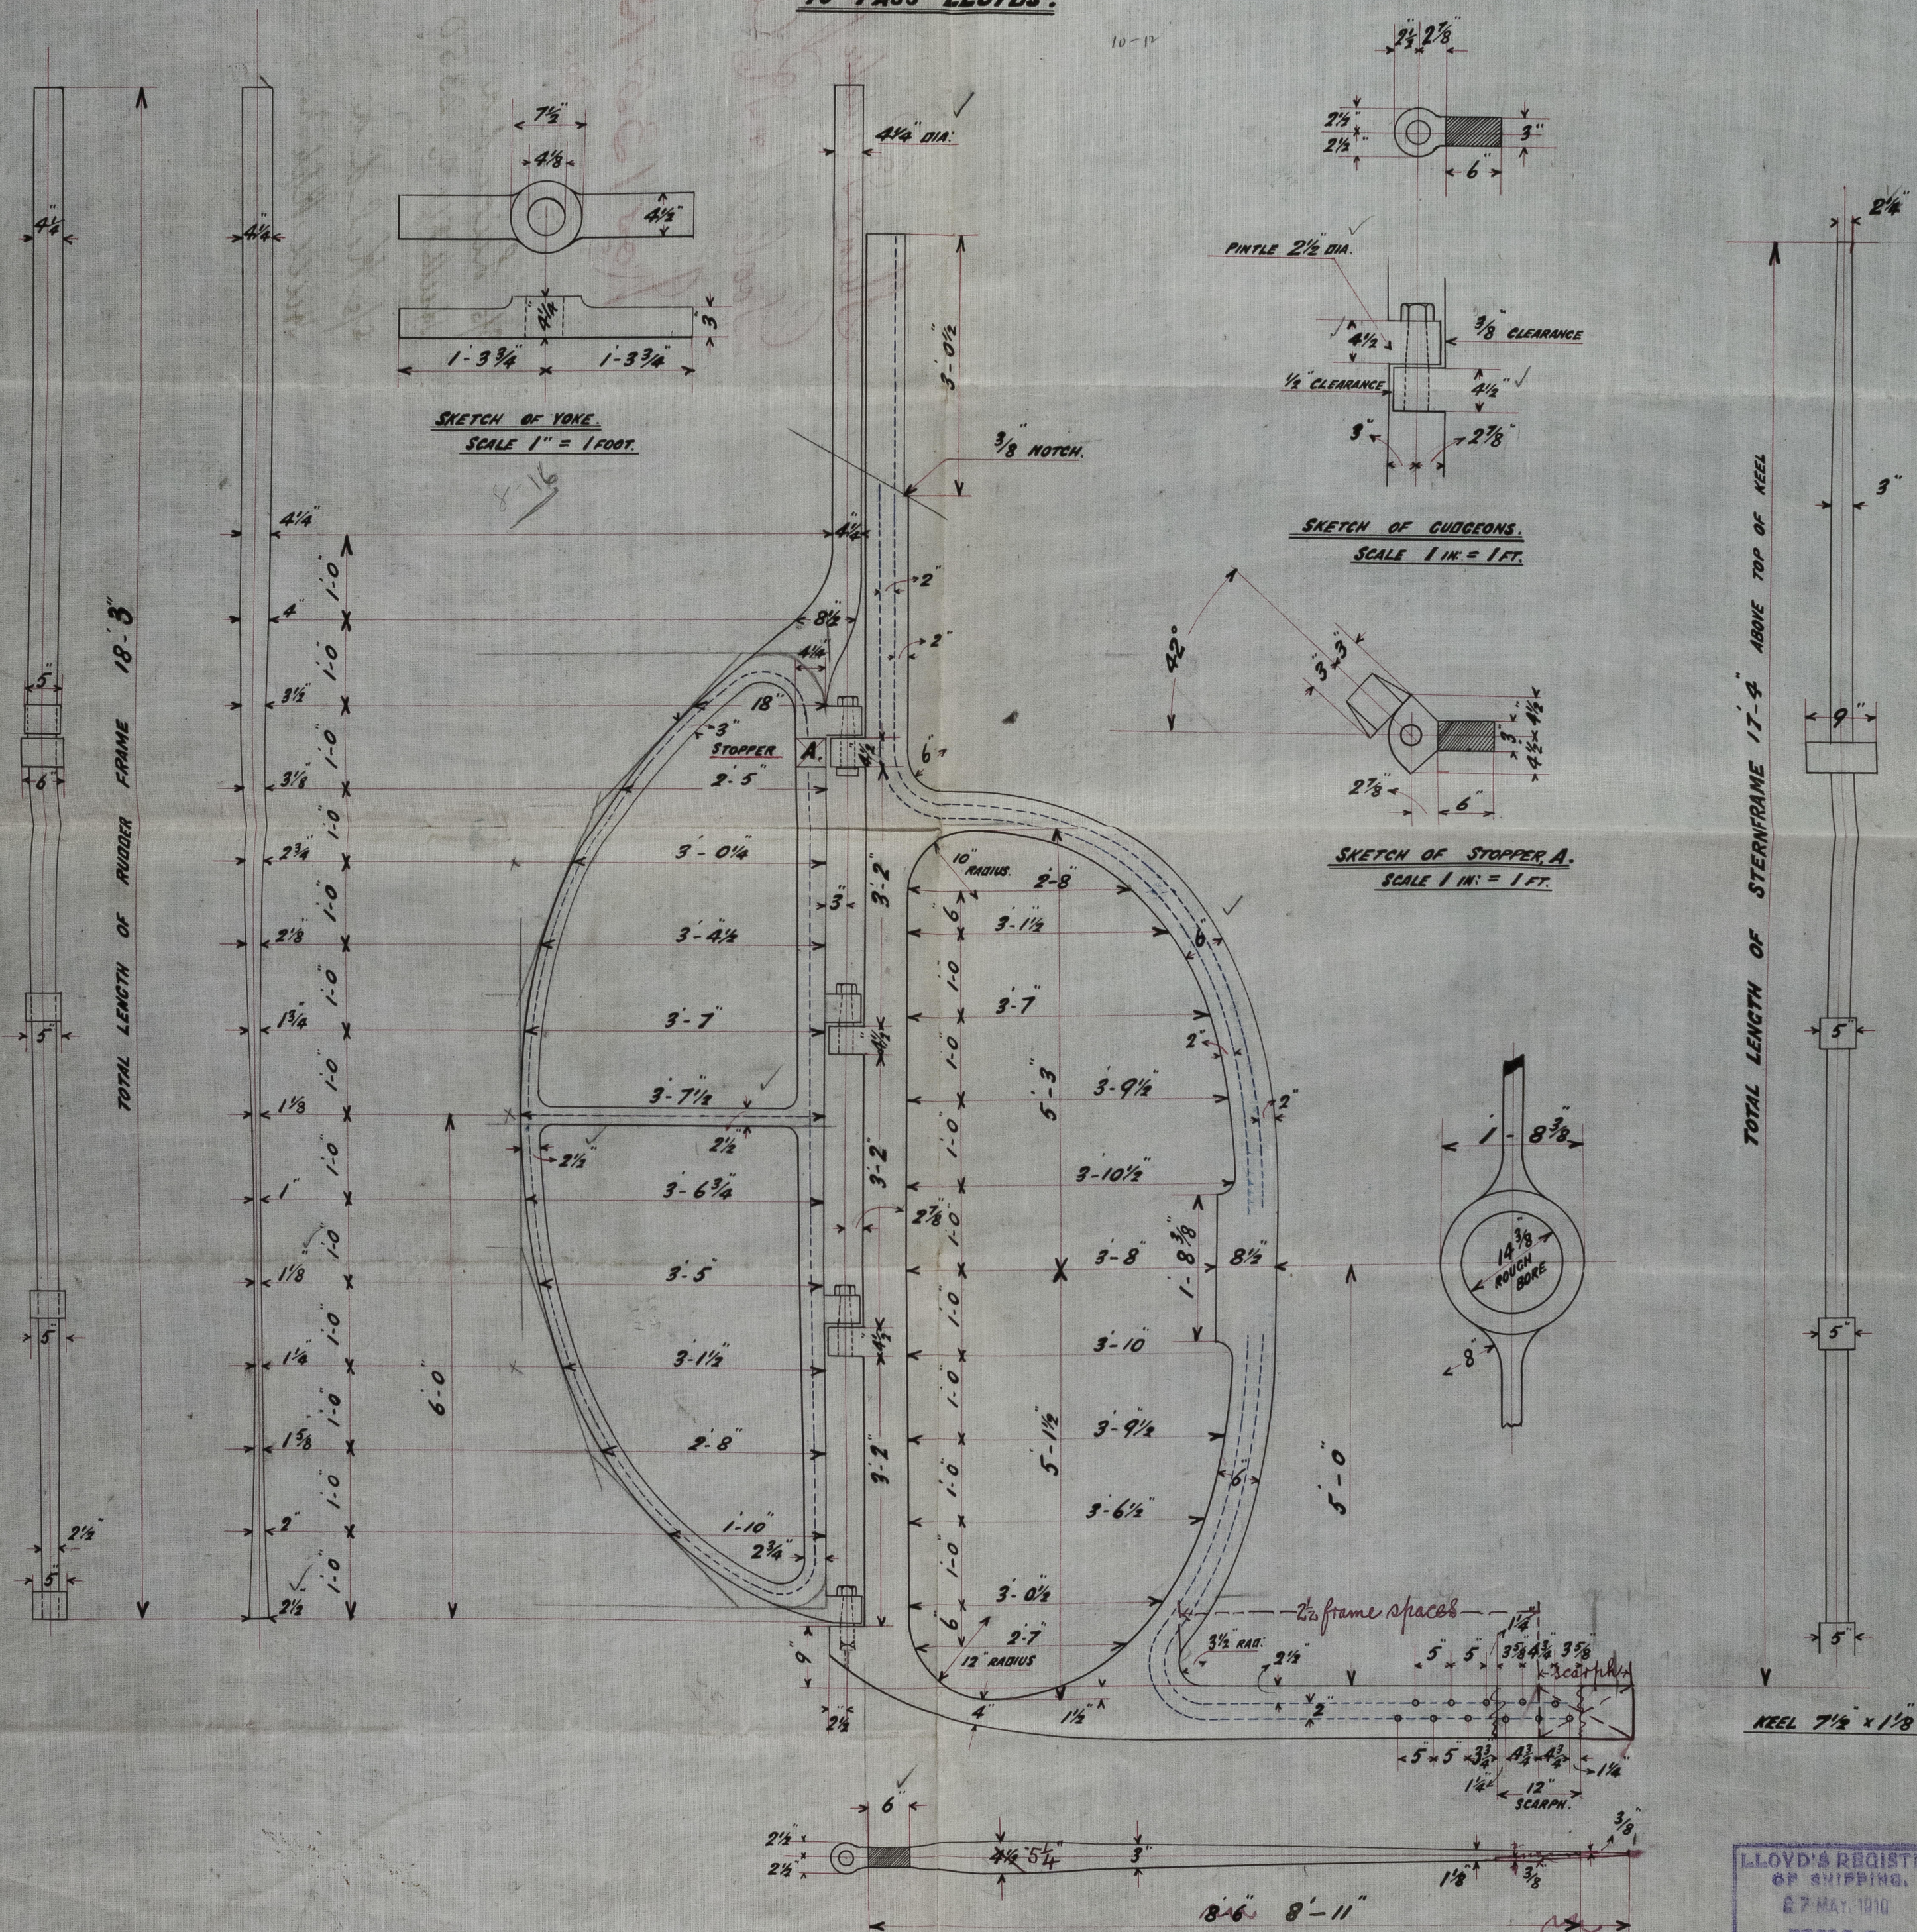

LLOYD'S REGISTER  
OF SHIPPING.  
27 MAY 1910  
HULL

Lloyd's Register  
Foundation



Stern + Rudder frames-  
Goole S. & R. Co's.

Nos 135 + 136


~~See~~

S/S Lucida

Hull Rph. n. 23502

S/S Kilda

Hull Rph. n.

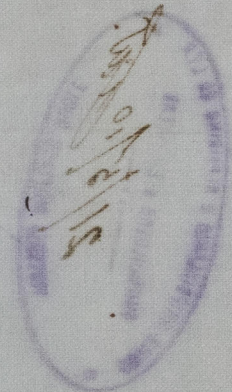

© 2020

Lloyd's Register  
Foundation