


YARD NOS. 78 & 79.

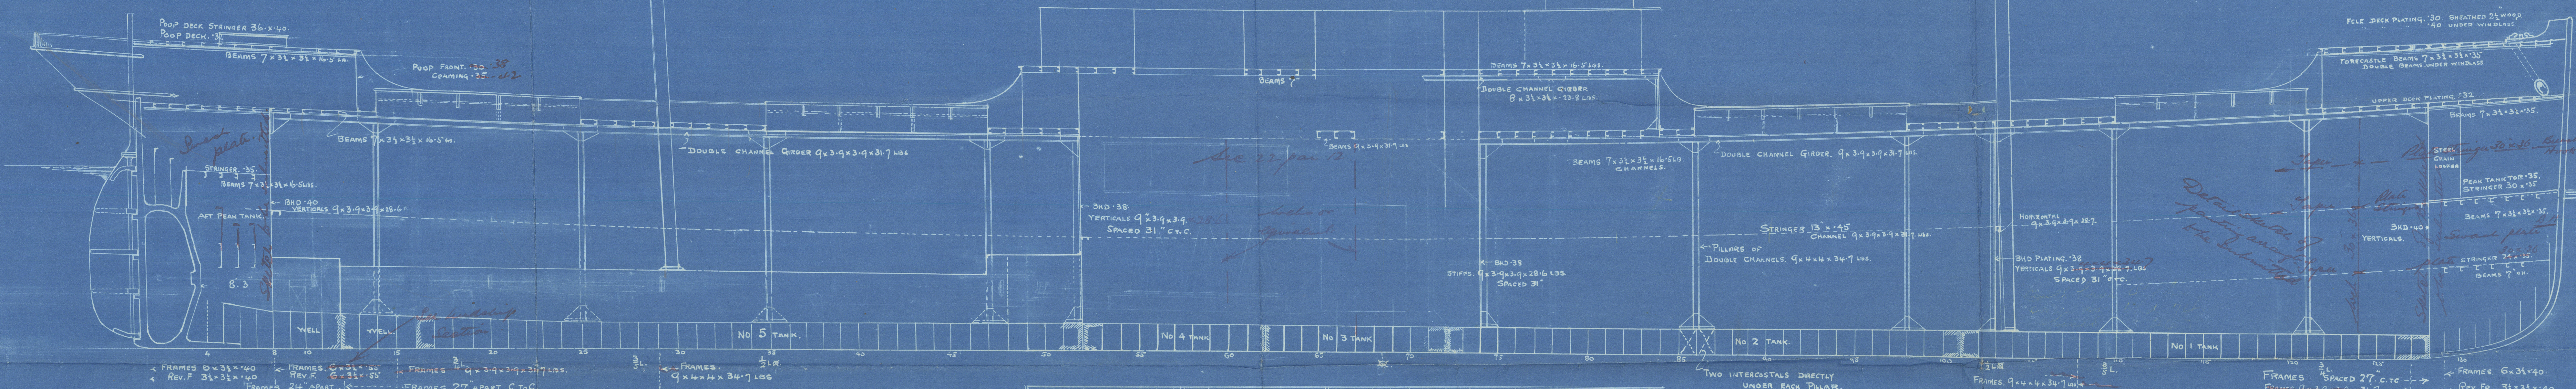

PROFILE & DECK PLANS FOR SINGLE DECK.
CARGO STEAMER
B.P. LENGTH 305 BEAM MLD 46 DEPTH MLD 26'9"
SCALE 1/8" INCH TO ONE FOOT.


OWNERS MESSRS NORMAN LIND & CO.
17 BATTERY PLACE
BUILDERS MESSRS HANLON & CO OAKLAND
SAN. FRANCISCO.



ESPLEN SONS & McNAUGHT, INC.
81 NEW STREET
NEW YORK

Profile & dk plans.

Haulon & Co's No. 7889.

No 78. "Governor John Lind" 

S. To rpt. No. 2850.

No 79. "Major Wheeler."

S. To rpt. No. 2861.

D 33 T.



© 2020

Lloyd's Register
Foundation

005961-005980-0030