
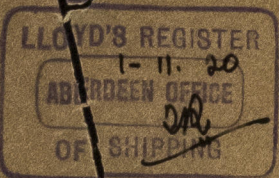


Steel Drifter CHIMERA.

Plan marked "A" shows positions of bulkheads as originally fitted

Plan marked "B" shows positions of bulkheads as now fitted.

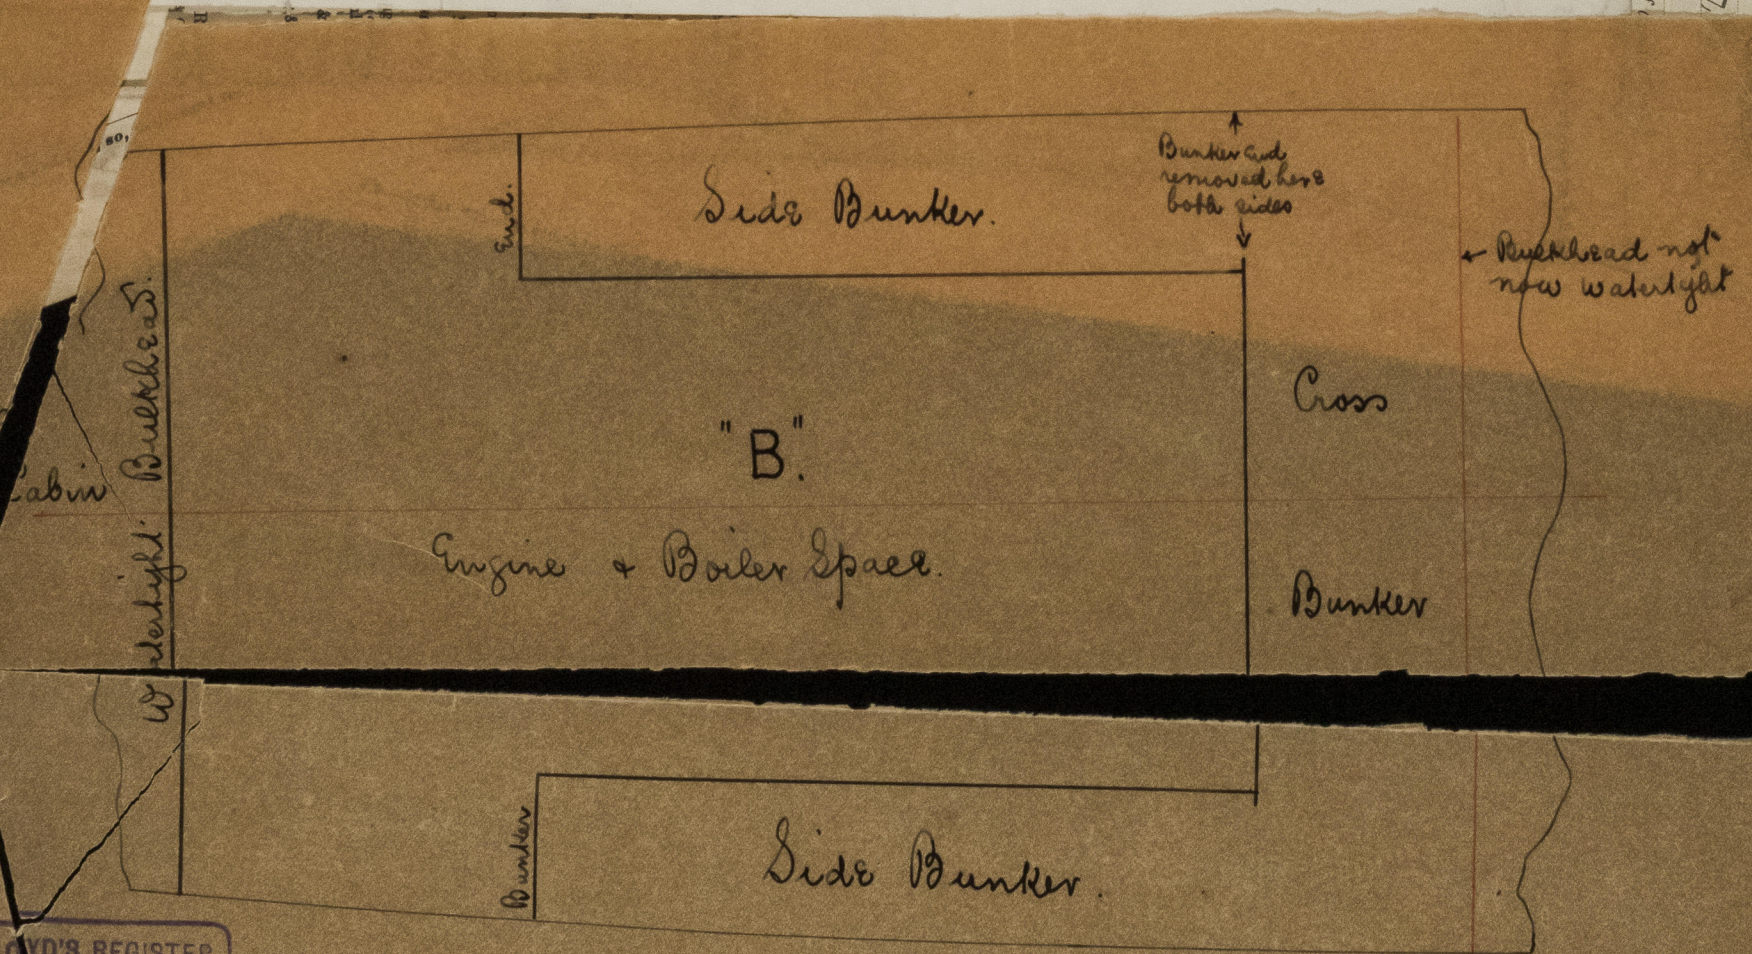

© 2020

Lloyd's Register
Foundation

005961-005980-0173