

17/3/10

S.S. Nos 133 & 4.

MIDSHIP SECTION.

STEEL SCREW FLEETERS.

DIMS: 110' 0" BP x 21' 6" x 12' 11" MLD

SCALE 1/2" = 1 FT.


TO CLASS 100 A.1. AT LLOYDS.

EQUIPMENT No 4756.

1 ANCHOR 5' 4" CENTS	EX STOCK
1 "	4 1/2" 4"
1 "	2 1/2"
90 FTMS 1 1/2" STUD LINK CHAIN	
60 "	5 1/2" HAWSER
60 "	4" WARP

NUMERALS	
1/2 BREADTH	10.75
DEPTH	13.42
1/2 GIRTH	19.52
1ST NO	43.69
LENGTH	108.875
2ND NO	4756.748

3" x 1 1/2" HOLLOW BEARING

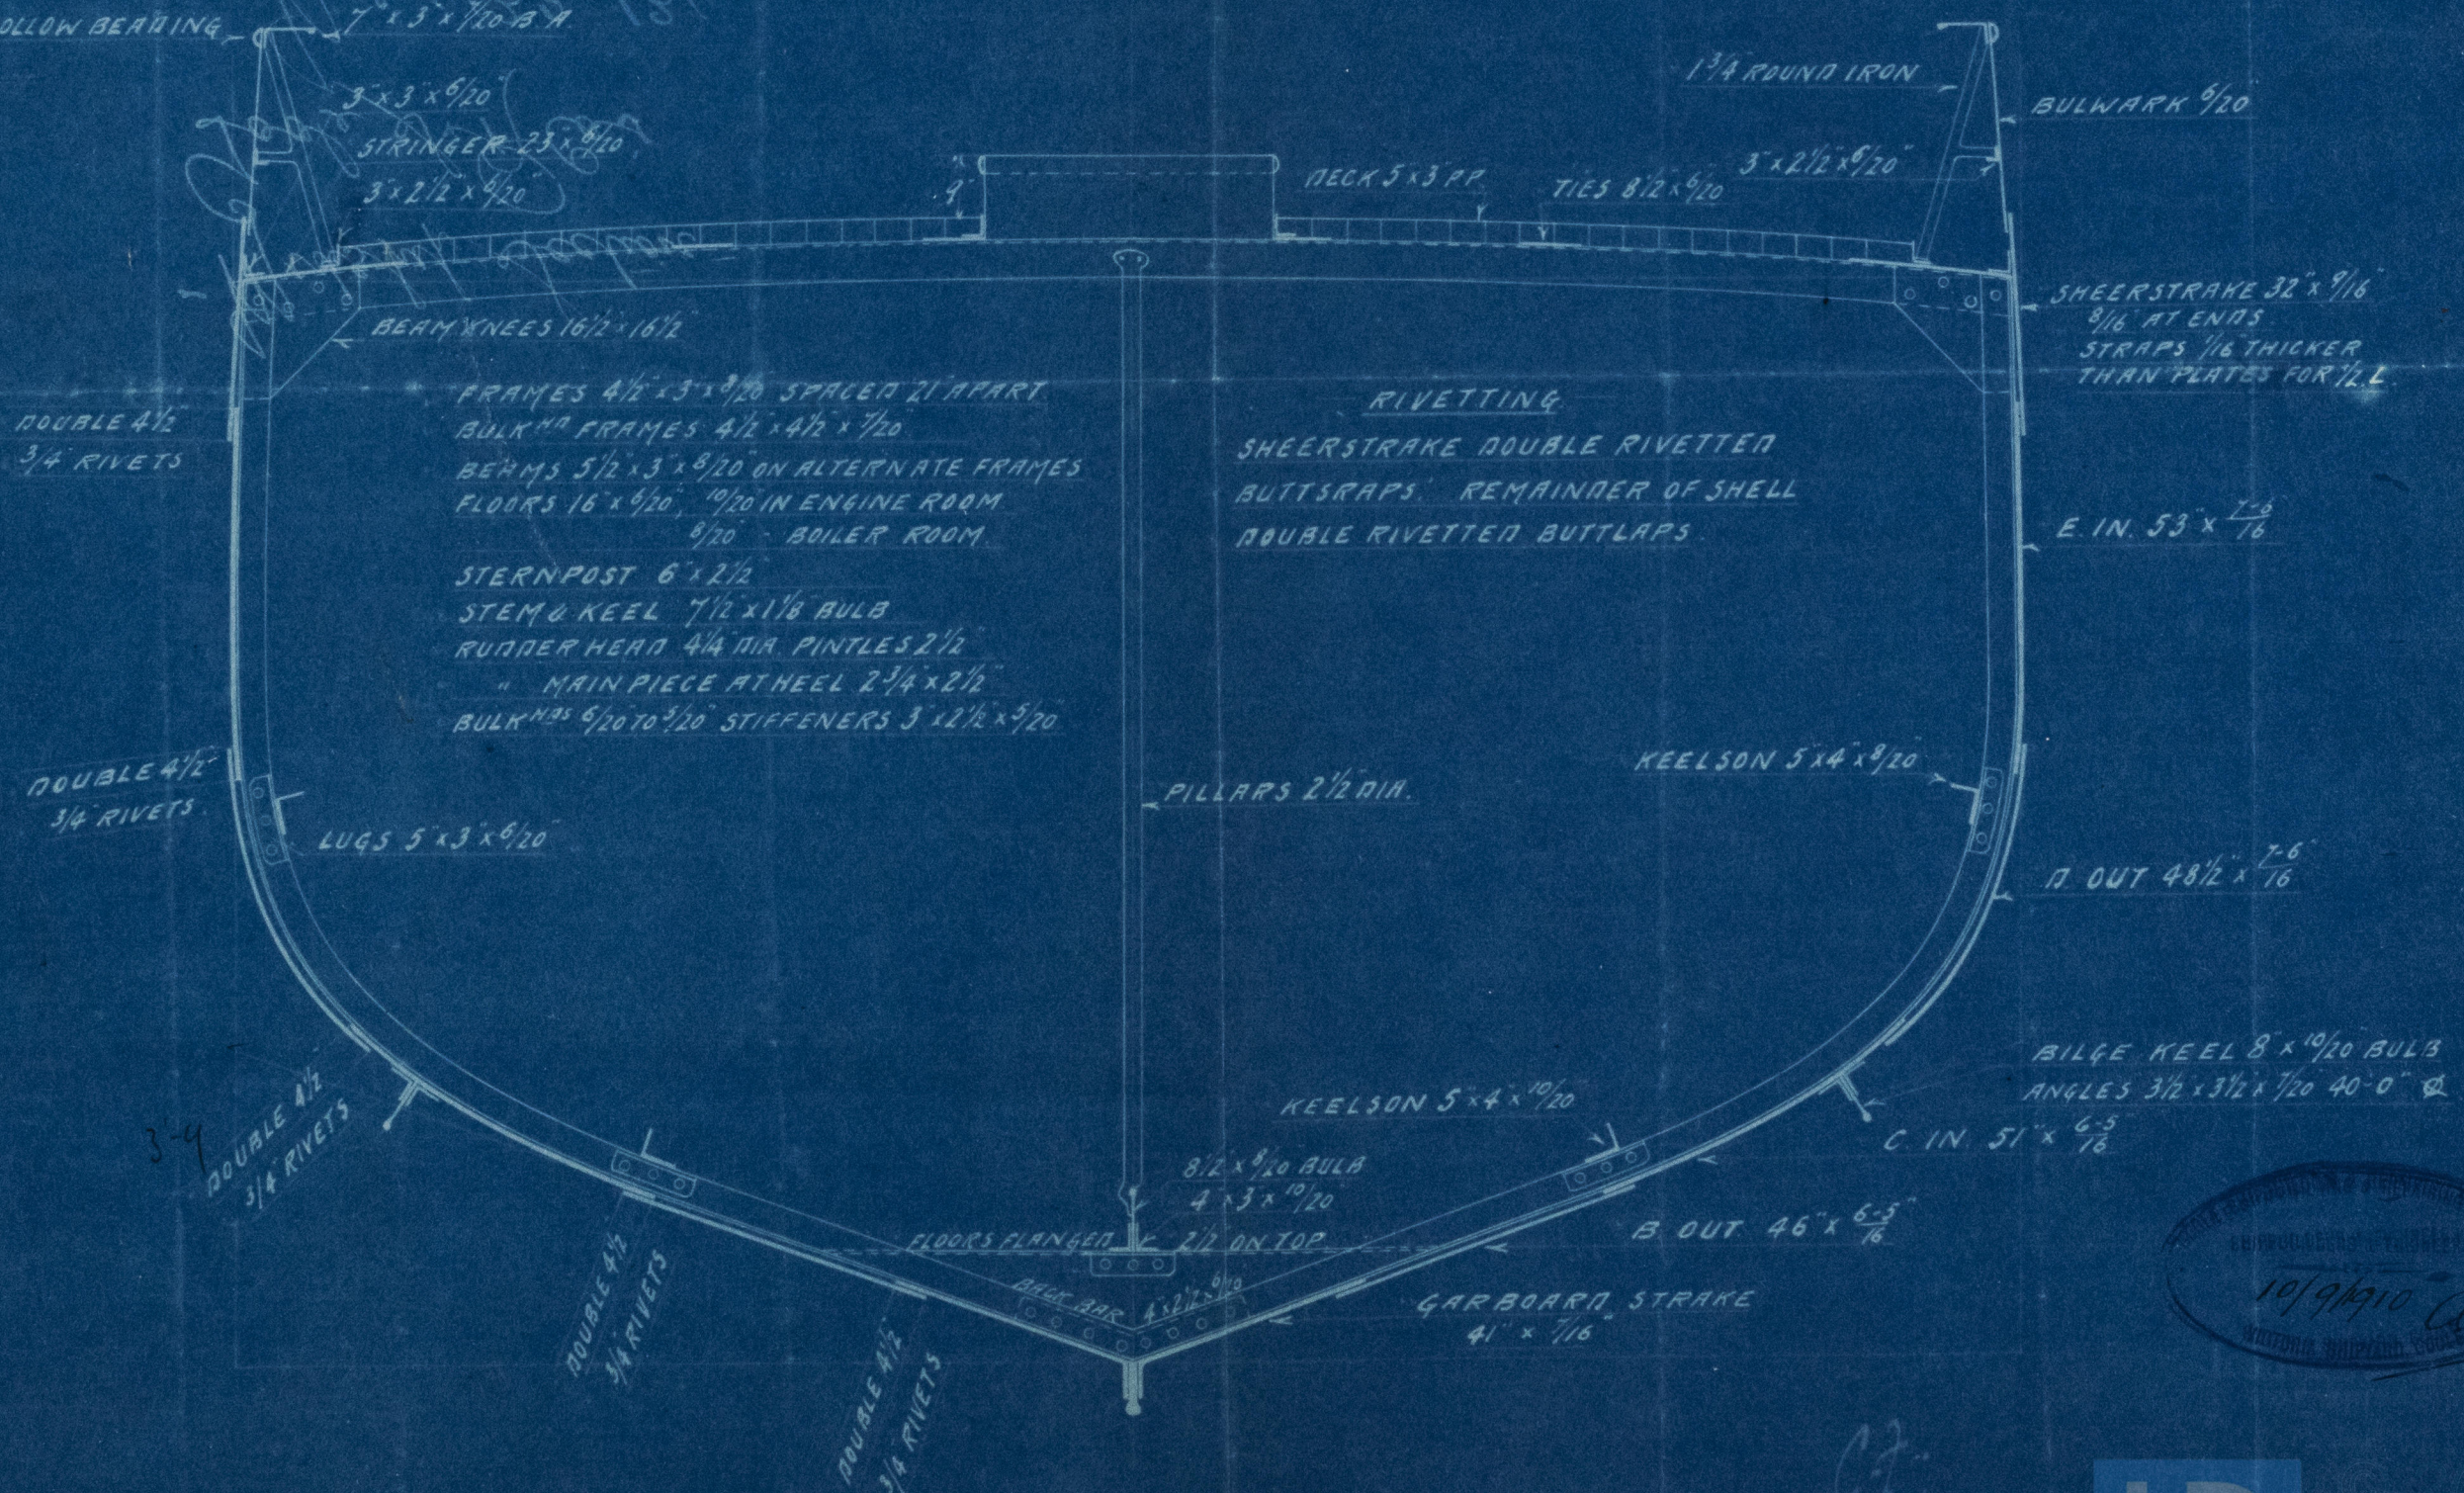

10/9/10



Midship Section
Goole S & R Co. Ltd

sp No. 1341
sp Tanager
Hull Rpt. No. — 22977
" "



© 2020

Lloyd's Register
Foundation

009961-005980-0226