

10.8.16

PLAN No. 478  
FOR ENCLOSURE TO  
H.M. Customs & Excise  
FROM  
COCHRANE & SONS, LTD.  
SHIPBUILDERS, SELBY.  
DATE 11/8/16


# PROFILE & DECK PLAN

N°689

STEEL SCREW TRAWLER

DIMS: 130'0" BP x 23'6" E x 3'2" MLD

SCALE 1/4" INCH

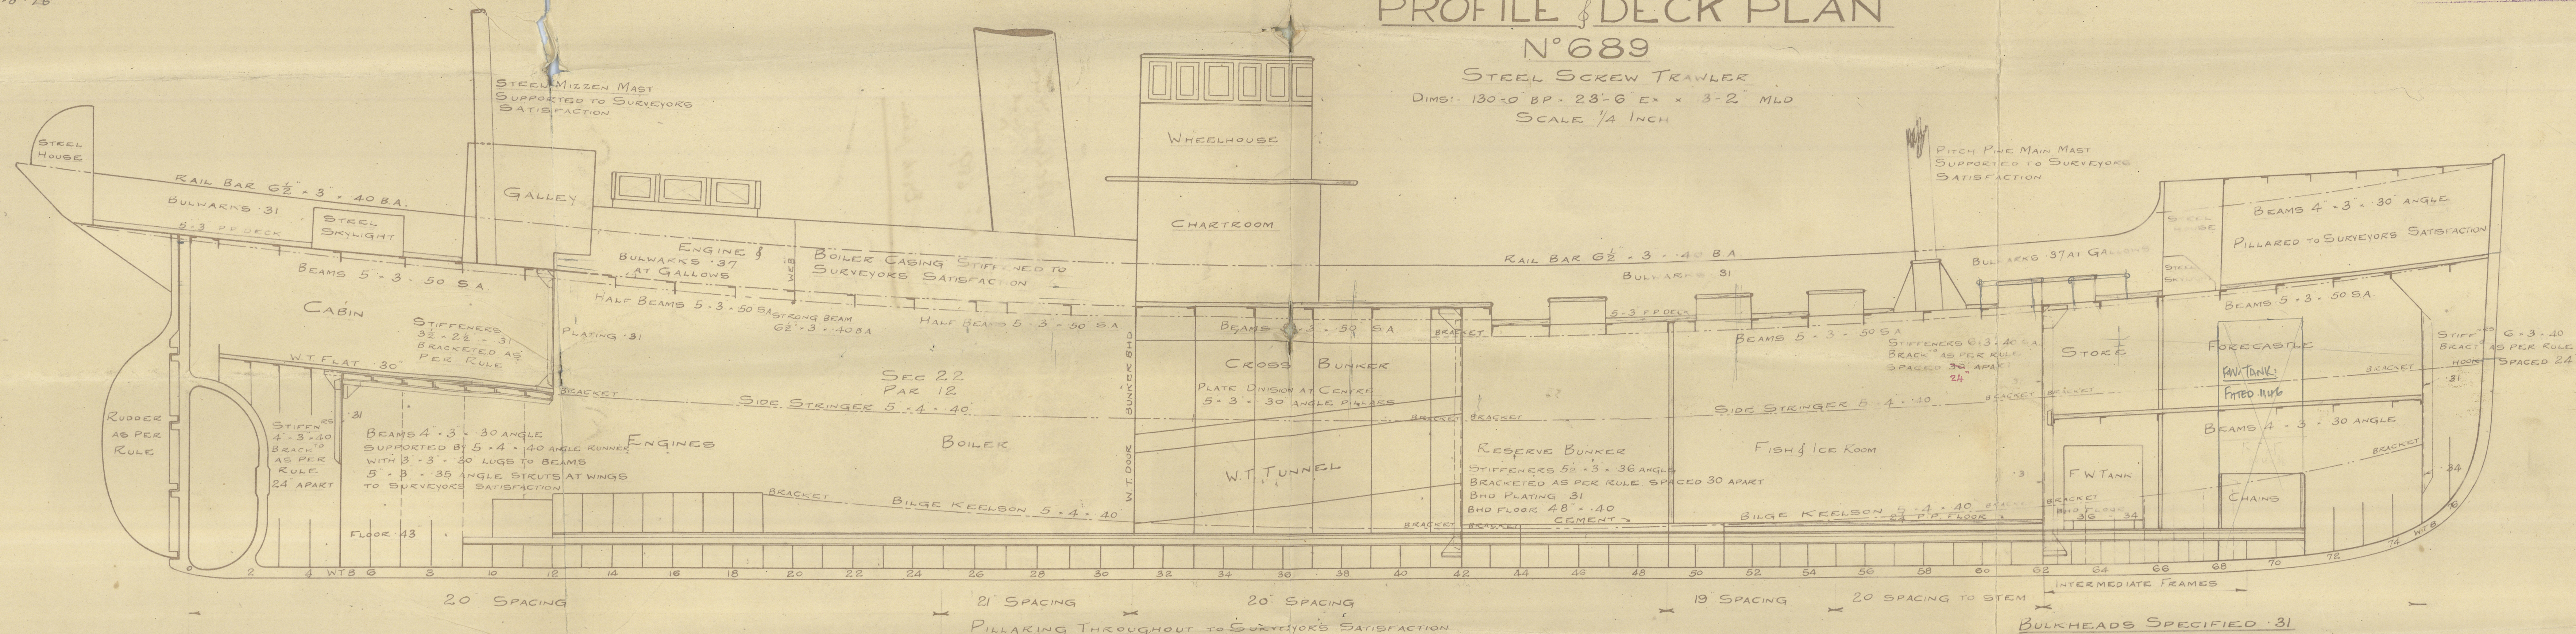

Ct.  
17.8.16

1/5 Anthony Aslett  
Hull Rpt. No. 2999.3



Messrs Cochran & Sons  
Ltd.

1/5 N<sup>o</sup> 689.

Profile & Deck plan.



D 48 Btm.