

13.2-11

MIDSHIP SECTION

Nº 487


STEEL SCREW TRAWLER.

DIMS 120' 0" BP x 21' 6" EX^E x 12' 3" ML^O

SCALE $\frac{1}{2}$ = ONE FOOT.

VESSEL TO CLASS 100 A1 AT LLOYD'S FOR FISHING PURPOSES
DECK PLATED OVER IN WAY OF MACHINERY SPACE E'S B
CASING AS PREVIOUSLY APPROVED.

PLAN No. 10031
FOR ENCLOSURE TO
Messrs Lloyd's Surveyors
Hull FROM
COCHRANE & SONS,
SHIPBUILDERS, SEELY
DATE 9/2/11 *RL*

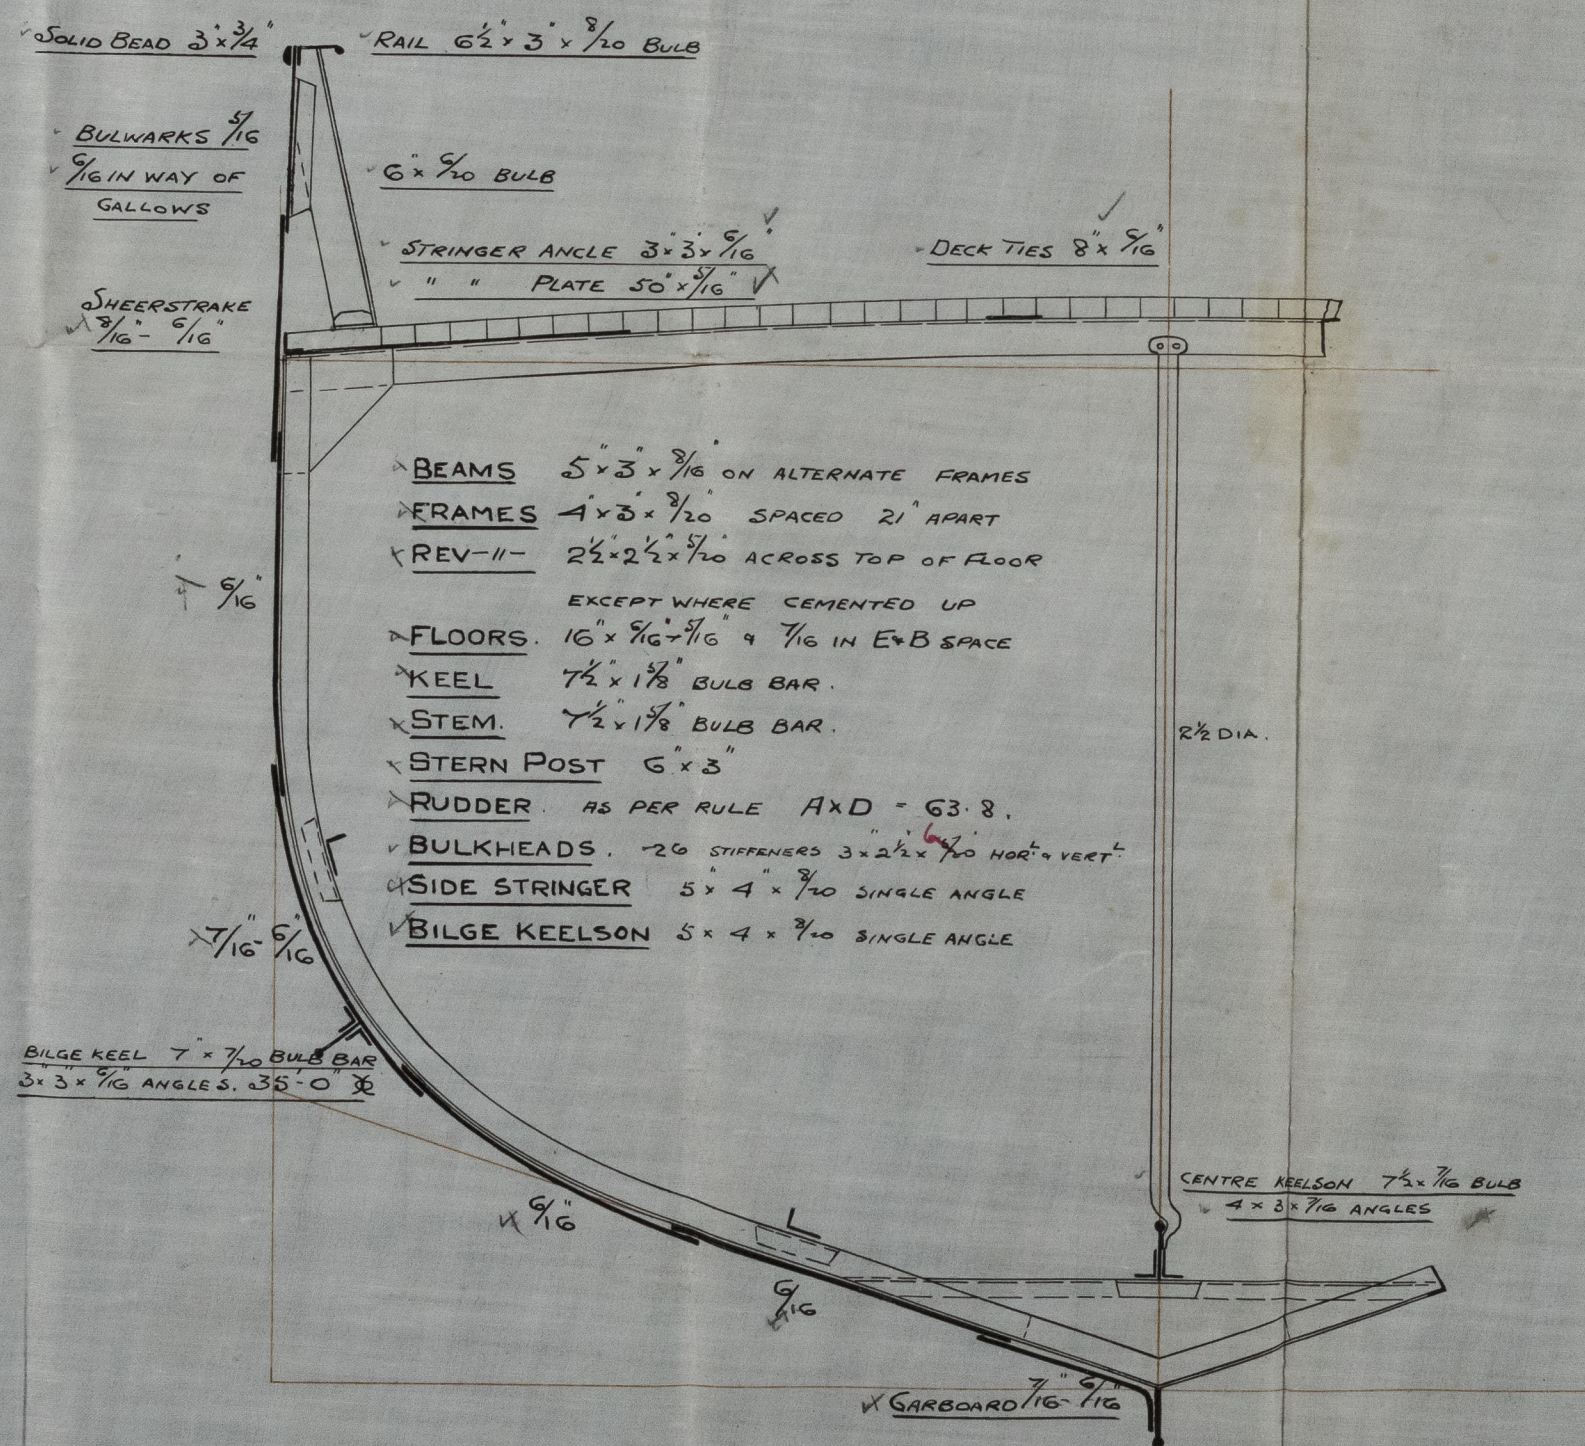

NUMERALS.

B+D. = 33.625 ✓
L x (B+D) = 4035 ✓
EQUIPMENT Nº 4035 ✓

PROPORTIONS.

$\frac{L}{D}$ = 9.79 ✓
 $\frac{L}{B}$ = 5.61 ✓

EQUIPMENT.

1ST BOWER ANCHOR 5 CWTs EX STOCK
2ND " " $4 \frac{1}{2}$ " " "
KEDGE " $2 \frac{1}{2}$ " " "
90 FATHOMS 1" CABLE
60 " $5 \frac{1}{2}$ " HAWSER
60 " 4 WARP

RIVETING.

BUTTS OF SHELL PLATING LAPPED
DOUBLE RIVETED EXCEPT GARBOARD
SHEERSTRAKE WHICH ARE TO BE
STRAPED & DOUBLE RIVETED, LANDINGS
DOUBLE RIVETED, BULWARKS SINGLE.

C.F.
13.2.11

Cochrane & Sons.
No. 487.

Midship Section.
of Cayman
Hull Rpt No 23995

Declass Section
147

13001

Hull

11/2/9

SECTION

No 487

TRAWLER

CREW


ONE FOOT

See 100 A at Lloyd's for fishing purpose

OVER IN WAY OF MACHINERY SPACE

APPROVED



© 2021

8820-51000-00605-0288

Lloyd's Register
Foundation