

S. S. No 95, & 104 & 5

MIDSHIP SECTION

STEEL SCREW TRAWLER

DIMS:- 130'-0" B.P. x 22'-6" x 13'-0" MLD.

TO CLASS 100 AL LLOYDS. FOR FISHING PURPOSES.

SCALE: 1/2" IN = 1 FT.

EQUIPMENT No 5766.

1 ANCHOR-- 5 3/4 CWT EX STOCK.

1 " -- 5 1/4 CWT " "

1 " -- 3 CWT " "

105 FMS -- 1 1/16" STUDLINK CHAIN.

60 " -- 6" HAWSER.

60 " -- 5" TARP.

NUMERALS.

HALF GIRTH -- 20.0.

" BREADTH -- 11.25.

DEPTH -- 13.5.


1st No -- 44.75.

LENGTH -- 128.875.

2nd No -- 5766.43.

2/0 = 9.5

2/0 = 5.7

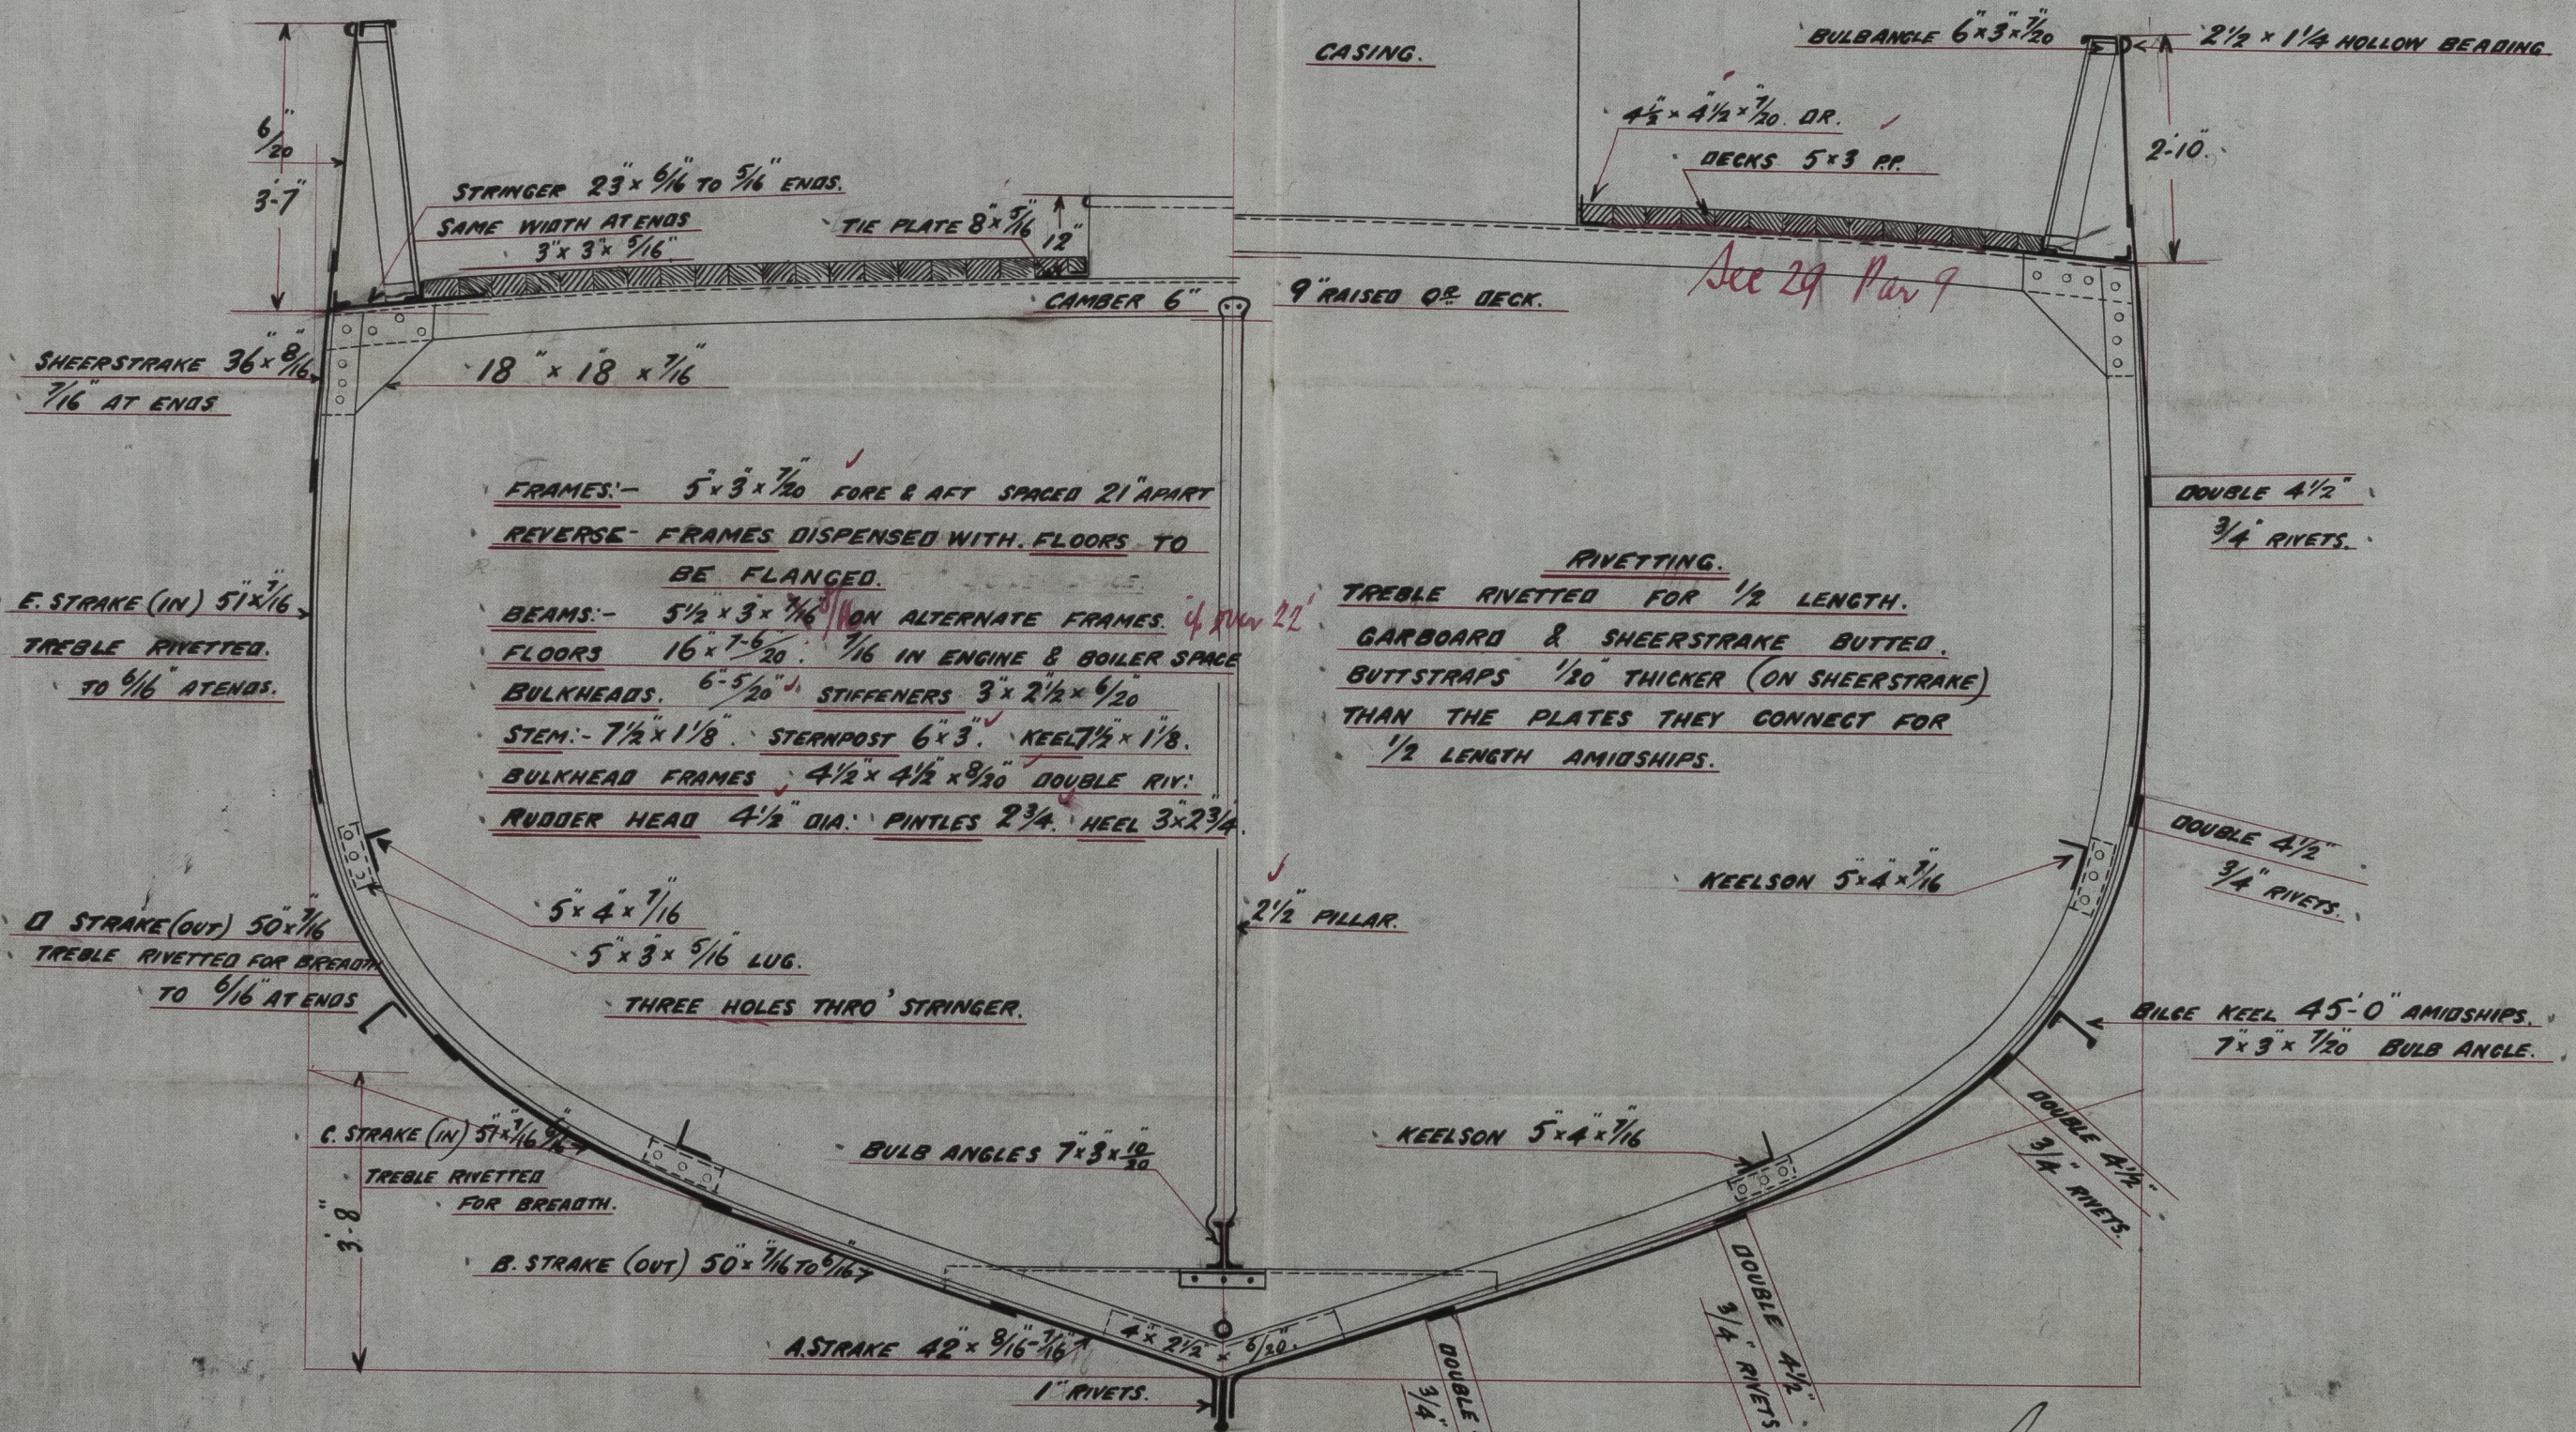

22.3.07




Wool S. + R.C. Ltd.

Nº 95-104 + 105

Midship Section

S.S. Phoebe. Nº 95. Y.N.

Hull Rep. Nº 19408

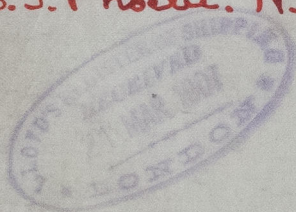


104

S/S Lizzie Hull Rep. No 19619

105

" Ethel

19674

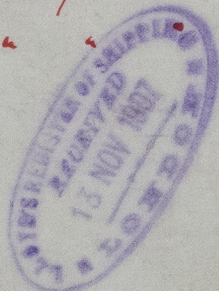

© 2020

Lloyd's Register
Foundation

006039-006055-0001