

19.10.11

19.10.11  
 19.10.11  
 19.10.11

# MIDSHIP SECTION.

STEEL SCREW TRAWLER.


Nº 519.

DIMS 125'-0" x 22'-0" EX x 12'-6" MLD

SCALE 1/2" INCH = 1 FOOT.

TO CLASS 100 A.I. AT LLOYDS FOR FISHING PURPOSES. DECK PLATED OVER IN WAY OF E & B SPACE. E & B CASING AS PREVIOUSLY APPROVED.

PLAN No. 216  
 FOR ENCLOSURE TO  
 Messrs Lloyd's Surveyors  
 Hull FROM  
 COCHRANE & SONS,  
 SHIPBUILDERS, 81 LONDON  
 DATE 17/10/11 RR

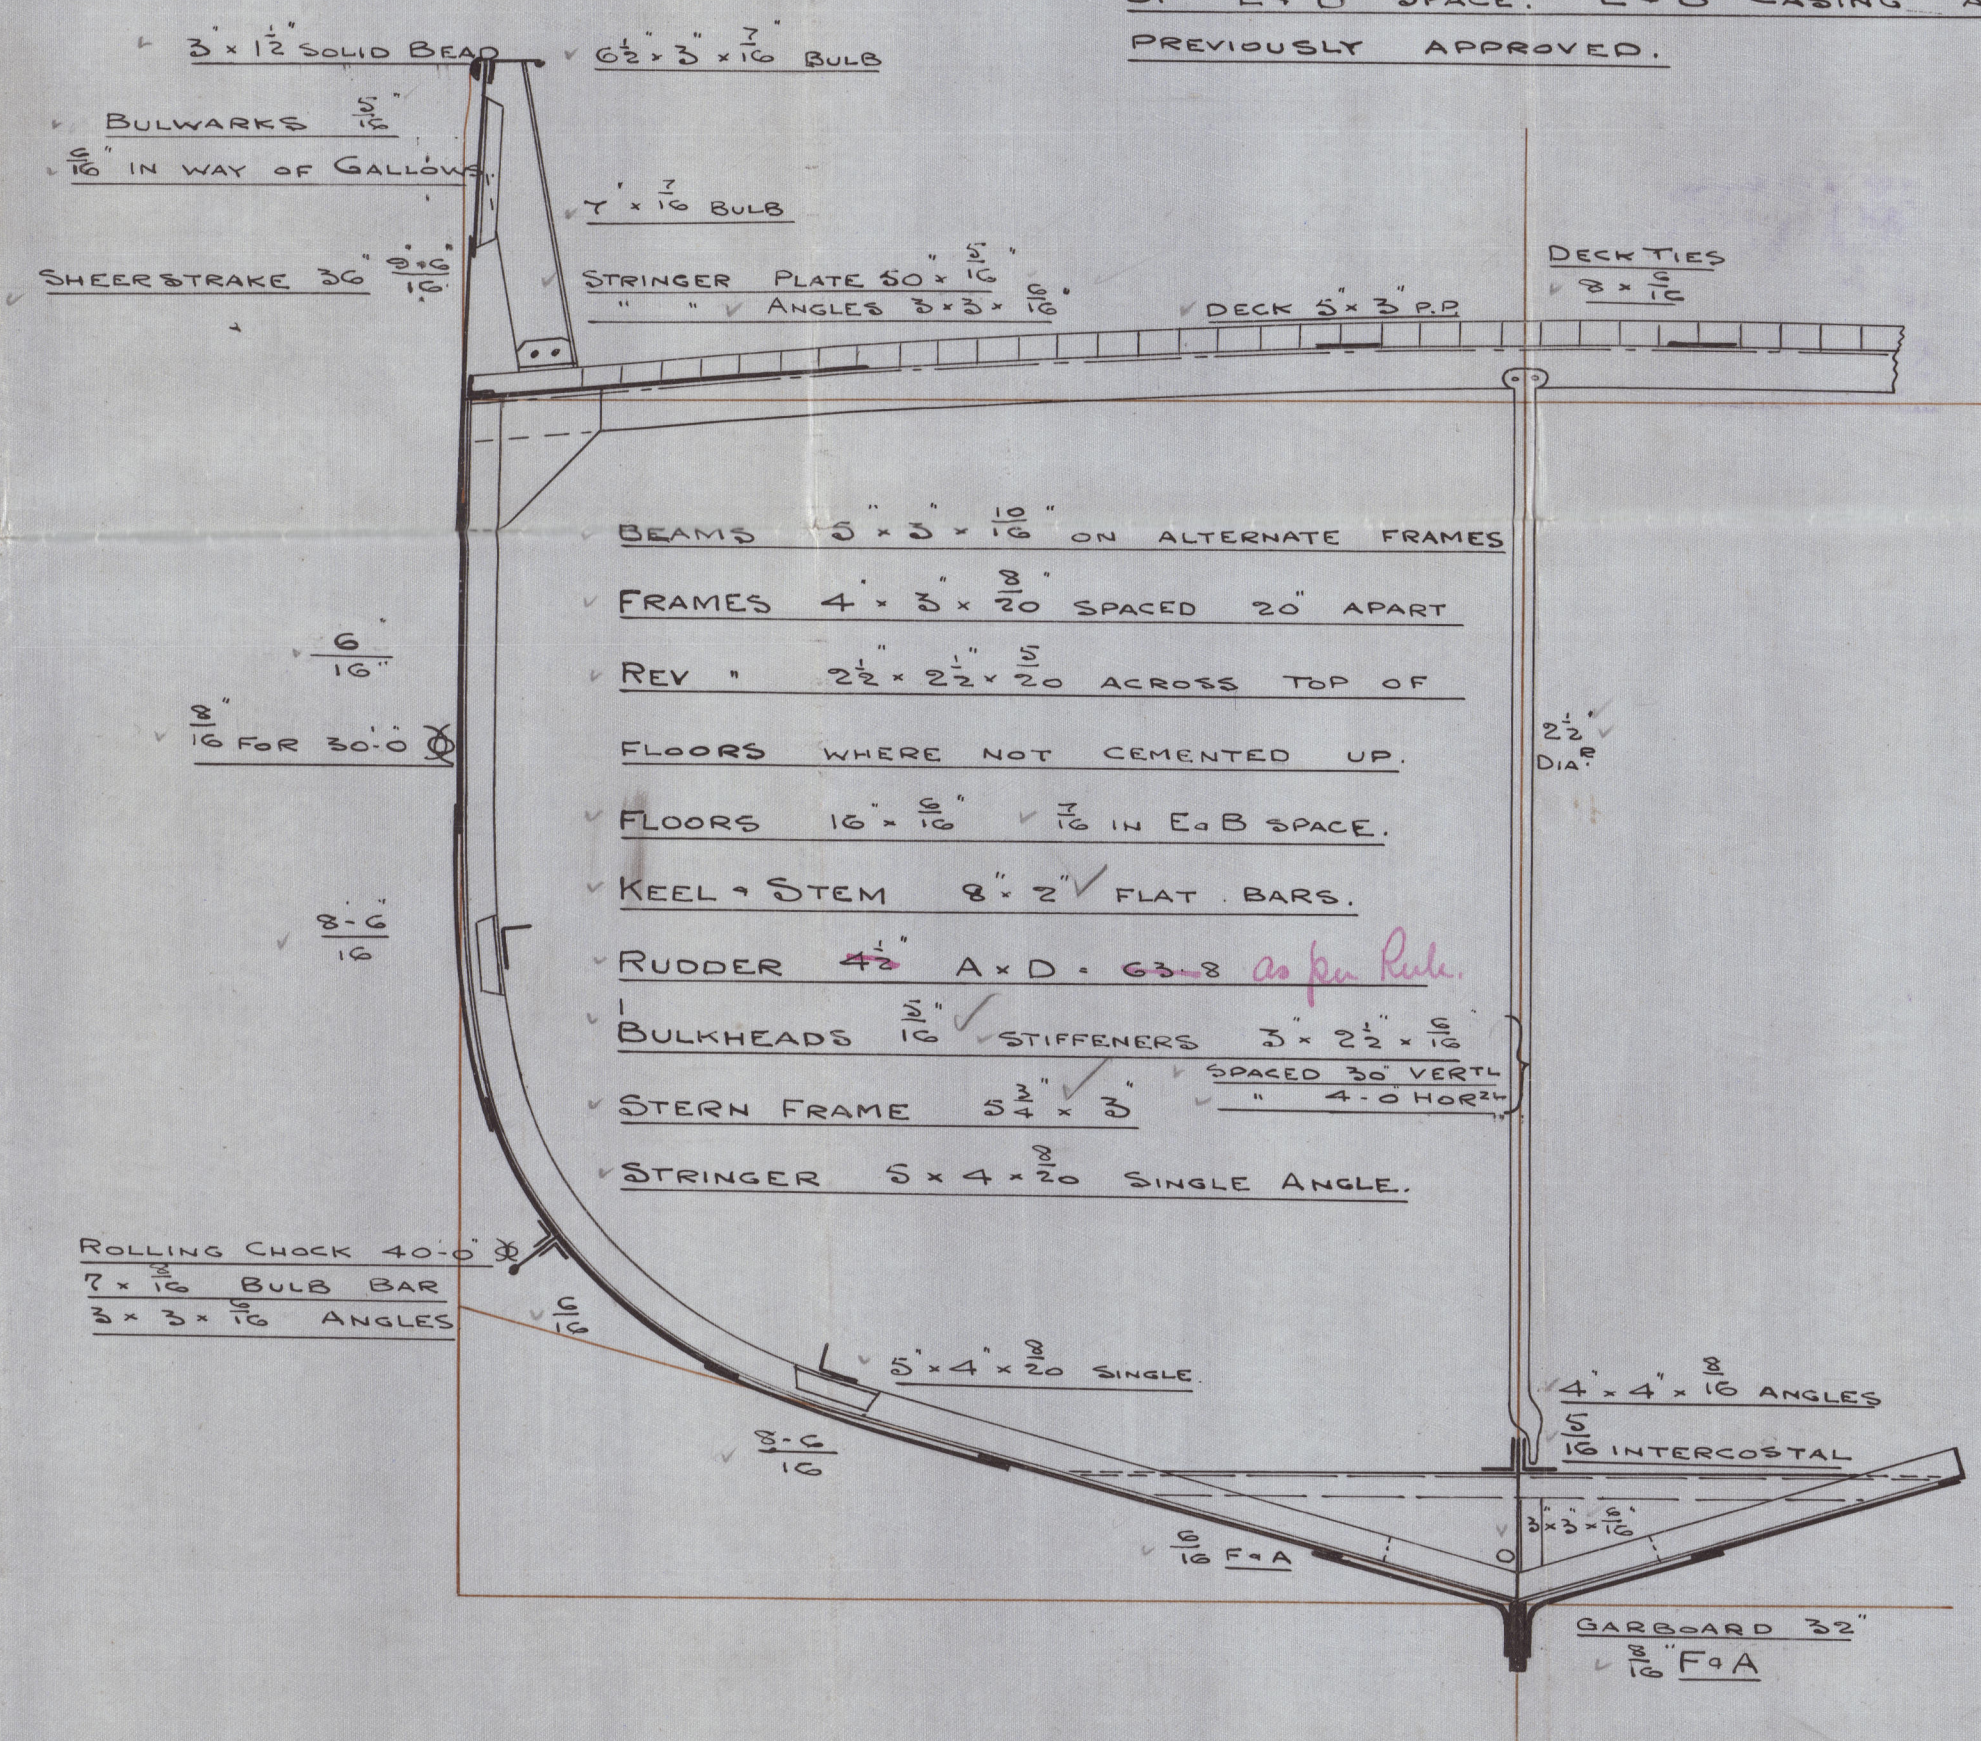

## NUMERALS

B + D = 34.37  
 L x (B + D) = 4296.25

## PROPORTIONS

L / D = 10  
 L / B = 5.71

## EQUIPMENT

1st Bower Anchor 5 1/2' cwt Ex Stock ✓  
 2nd " " 5 " " " ✓  
 Kedge Anchor 2 1/2 " " " ✓  
 103 FATHOMS 1 1/2" CABLE ✓  
 60 " 6" HAWSER ✓  
 60 " 4 1/2" WARP ✓

## RIVETING

Butts of shell plating lapped ✓  
 9 double riveted except garboard ✓  
 7 sheerstrake which are to be ✓  
 5 strapped 9 double riveted. Landings ✓  
 Double riveted, bulwarks single ✓

asur.  
 19.10.11

C.F.  
 19.10.11




Cochrane & Sons.

No. 519.

Midship Section.

1/2 Garola Hall Rpt No. 24864

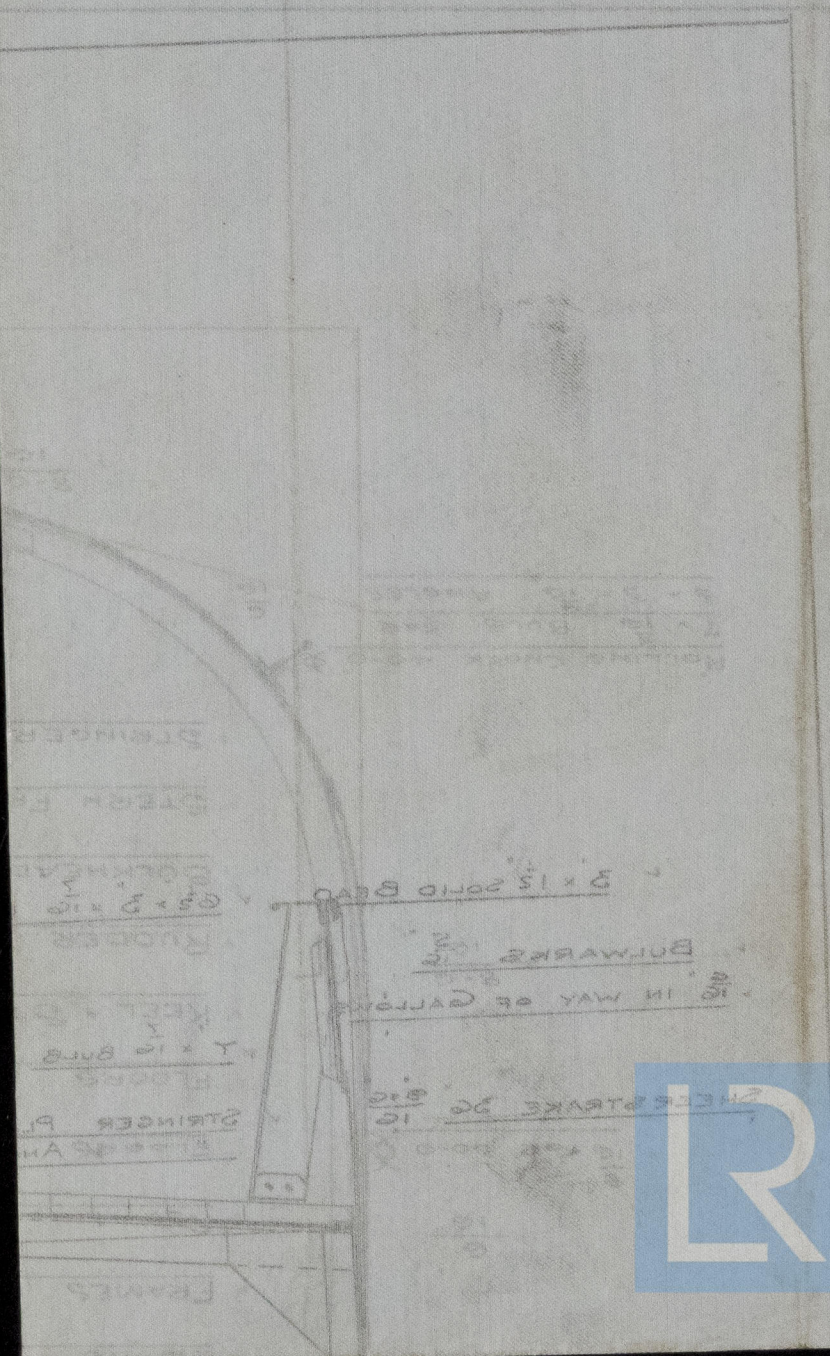

© 2020

Lloyd's Register  
Foundation

006039-006035-0096



# SECTION

PLAN NO. 816

FOR ENCLOSURE TO




SHIPBUILDERS & SHIP

DATE 12/10/11

BY M

TRAWLER

CREW

219

SS-OEX \* 15-6 M


1/2 INCH \* 1 FOOT

AT LLOYD'S FOR FISHING

PLATED OVER IN WAY

EAB CASING AS

AVED

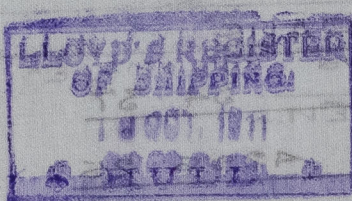

006039-006055-00946



© 2020

Lloyd's Register Foundation