

## MIDSHIP SECTION

N<sup>o</sup> 308

SCALE  $\frac{1}{2}" = 1 \text{ FOOT}$ .

24. 108.  
1/2 Class 100 A.I. at Lloyd's Ave. deck  
14. 5. 08  
265'-0"  $\times$  38'-6"  $\times$  26'-0" D.M.

Approx. U. D. Tonnage 1300.

Sheer

at stem ----- 6'-0" 6-2"

at  $\frac{1}{8}$  L. abaft stem --- 2'-9" 3-0 $\frac{1}{2}$ "

At.  $\frac{1}{8}$  L. For<sup>d</sup> of Post --- 1'  $\frac{1}{2}$ " 1' 9"

At Post ----- 2'-0" 3-2"

## Numerals

1/2 Breadth ----- 19.16

Depth ----- 19.04

1/2 Girth ----- 34.64

42.84 1<sup>st</sup> No

263.5

19201      2nd 82

$\frac{L}{D}$  to Ave. dk. 9.83.

Equipment Number

19201

$$263.5 \times 4.45 \times 1\frac{1}{2} = 3062$$

Sidchouses  $50 \times 7 = \underline{350}$

22613 Equip No

## Equipment

2 Bower Anchors ----- 35 1/2 Cwt Stockless

1 " " 30 " "

1 Stream " 9 1/4 " Ex Stock

1 Kedge " 14 <sup>3</sup>/<sub>4</sub> " "

240 Lathoms ----- 1 <sup>14</sup>/<sub>16</sub> stud Chain Cable

45 " ----- 4" wire

90 " - - - - -  $3\frac{1}{2}$  "

2-90 " 6" Manila

Riveting

Butts of shell plating treble riveted overlaps, and  
Quadruple for  $\frac{1}{2}$  L. II where over rule rivets.

Bulbs of Main and Awining Deck Stringers plates  
treble riveted for  $\frac{1}{2}$  to 20, double at ends.

Butts of Centre Reel on treble riveted for  $\frac{3}{4}$  L 28  
double at ends.

Bulbs of margin plate, Tank Top Centre Strake and  
Lower str. Stringer plates double riveted thro.

Bulbs of Main and Awining deck plating double  
for  $\frac{1}{2}$  L H, single at ends.

Baths of tank top Plating single riveted  
and double in E. & B. spaces.

All angles in double bottom (except those attached to outside plating) to be  $\frac{3}{16}$ " thicker in Boiler Space.



21/4/00  
N<sup>o</sup> 308


Midship Section

The Greenock &  
Glasgow S.S. Co.

Glasgow

"Cabo La Plata"

Lth 12455.

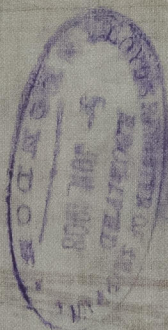

© 2020

Lloyd's Register  
Foundation

006056-006066-0190