


# PROFILE & DECK PLAN N<sup>o</sup>s. 221

SCALE  $\frac{1}{8}'' = 1 \text{ foot}$

LENGTH B.P. 331'-0" — BREADTH EXT. 47'-9" — DEPTH M.O. 24'-6"

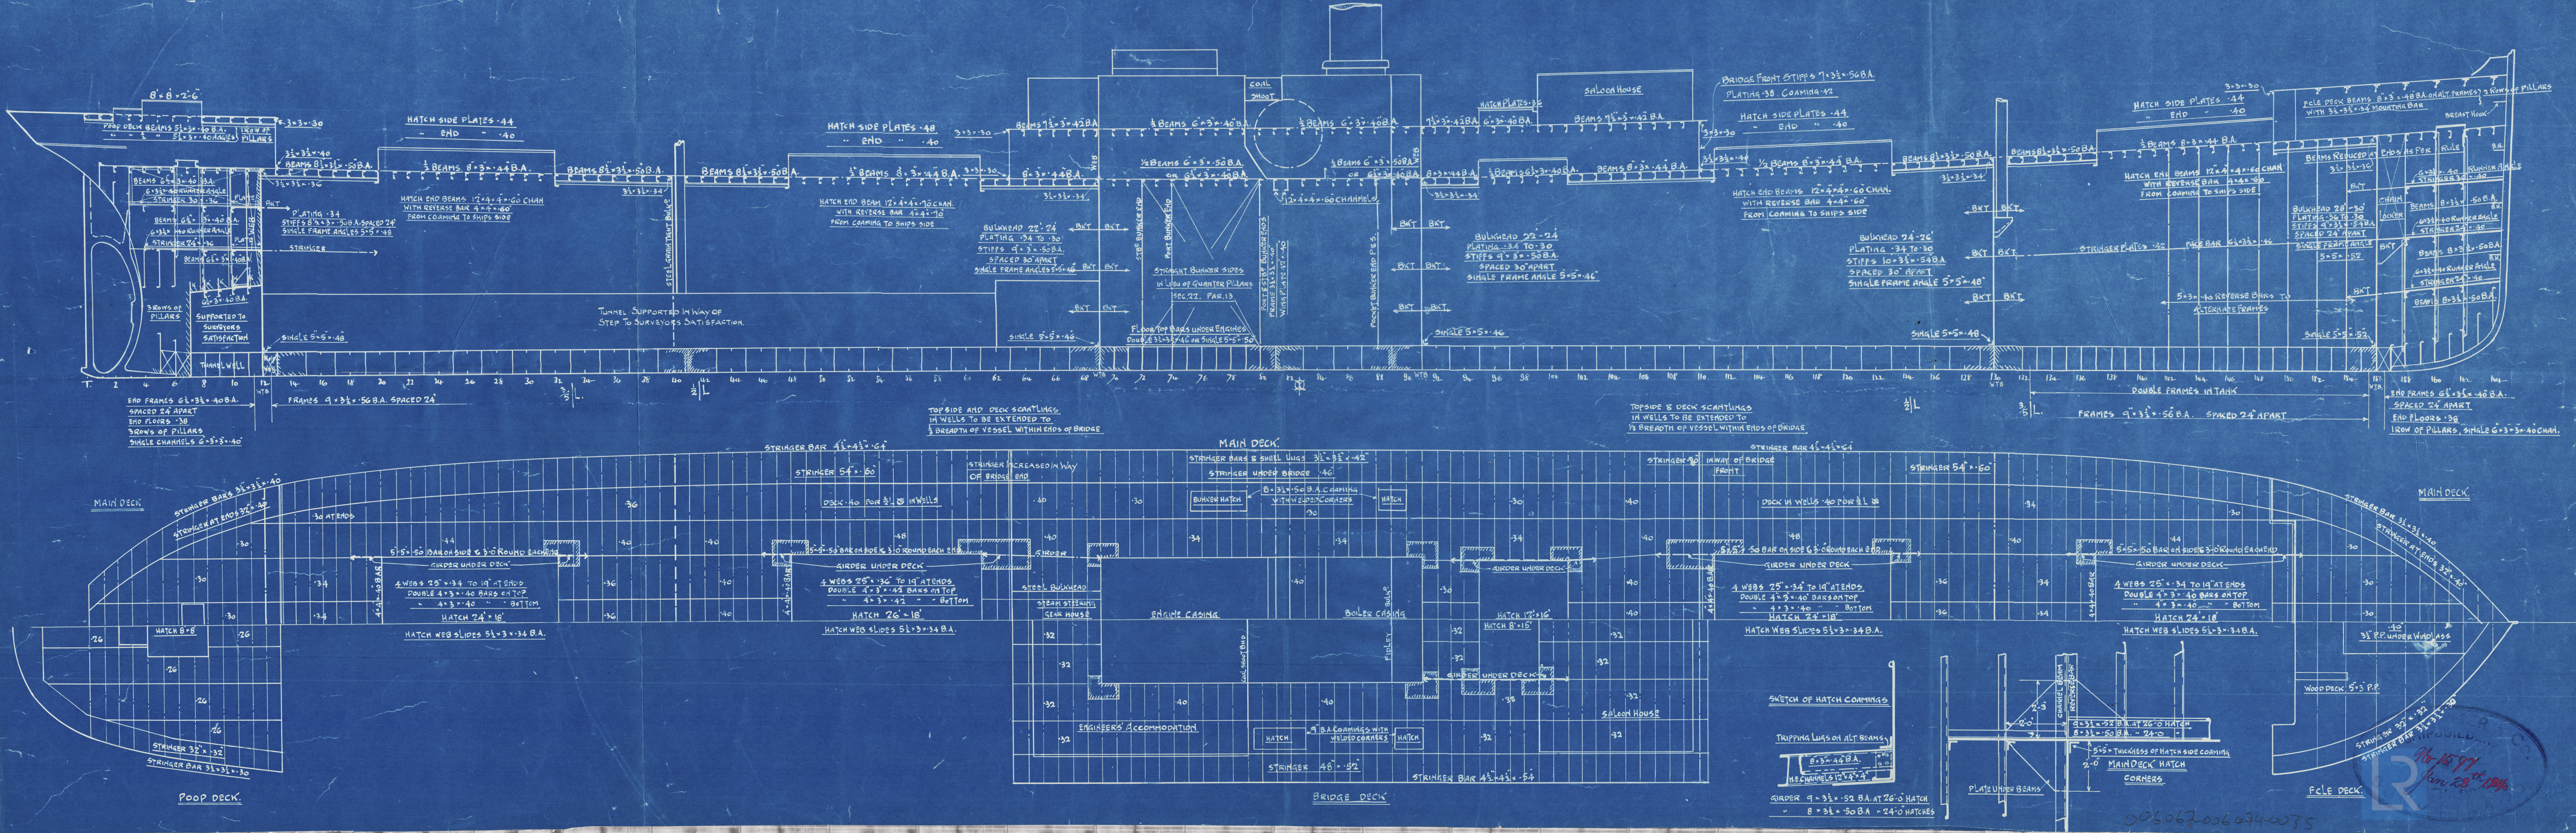



Profile +  
Deck Plan  
(as built)

S/S. "Aydin" <sup>ex</sup> Sld 25993.  
Nelson Moor

J. Blumier & Co<sup>s</sup>  
No. 221

Sld Rpt No 25993



© 2021

Lloyd's Register  
Foundation

006067-006074-0035