


31.8.06

# S.S. N<sup>o</sup> - 389 MIDSHIP SECTION

STEEL SCREW TRAWLER  
DIM<sup>s</sup> LENGTH 120'0" x BREADTH 22'0" D<sup>PTH</sup> MOULDED 12'6"  
SCALE 1/2" = 1 FOOT

TO BE CLASSED 100 A.1. AT LLOYD'S FOR FISHING PURPOSES

E & B CASING AS PREVIOUSLY APPROVED  
DECK PLATED OVER IN WAY OF E & B CASING

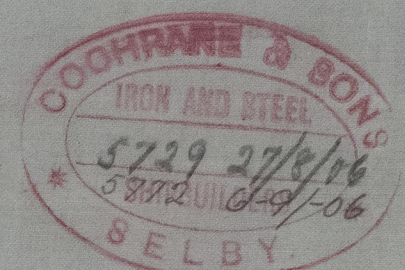

## NUMERALS AS PER RULES


1/2 BREADTH	10'95
1/2 GIRTH	19'37
DEPTH	12'95
	43'27
	118'66
	5139'4182

## PROPORTIONS

D. TO L	9'2
B. TO L	5'4

## EQUIPMENT

1 <sup>ST</sup> STOCKLESS	6 3/4 CWTs	5000
2 <sup>ND</sup> BOWER	4 3/4	200 STOCK
3 <sup>RD</sup> BOWER	2 1/2	" "
20 FATH <sup>s</sup>	1"	CABLE
60 FATH <sup>s</sup>	6"	HAWSER
60 FATH <sup>s</sup>	4 1/2	WART

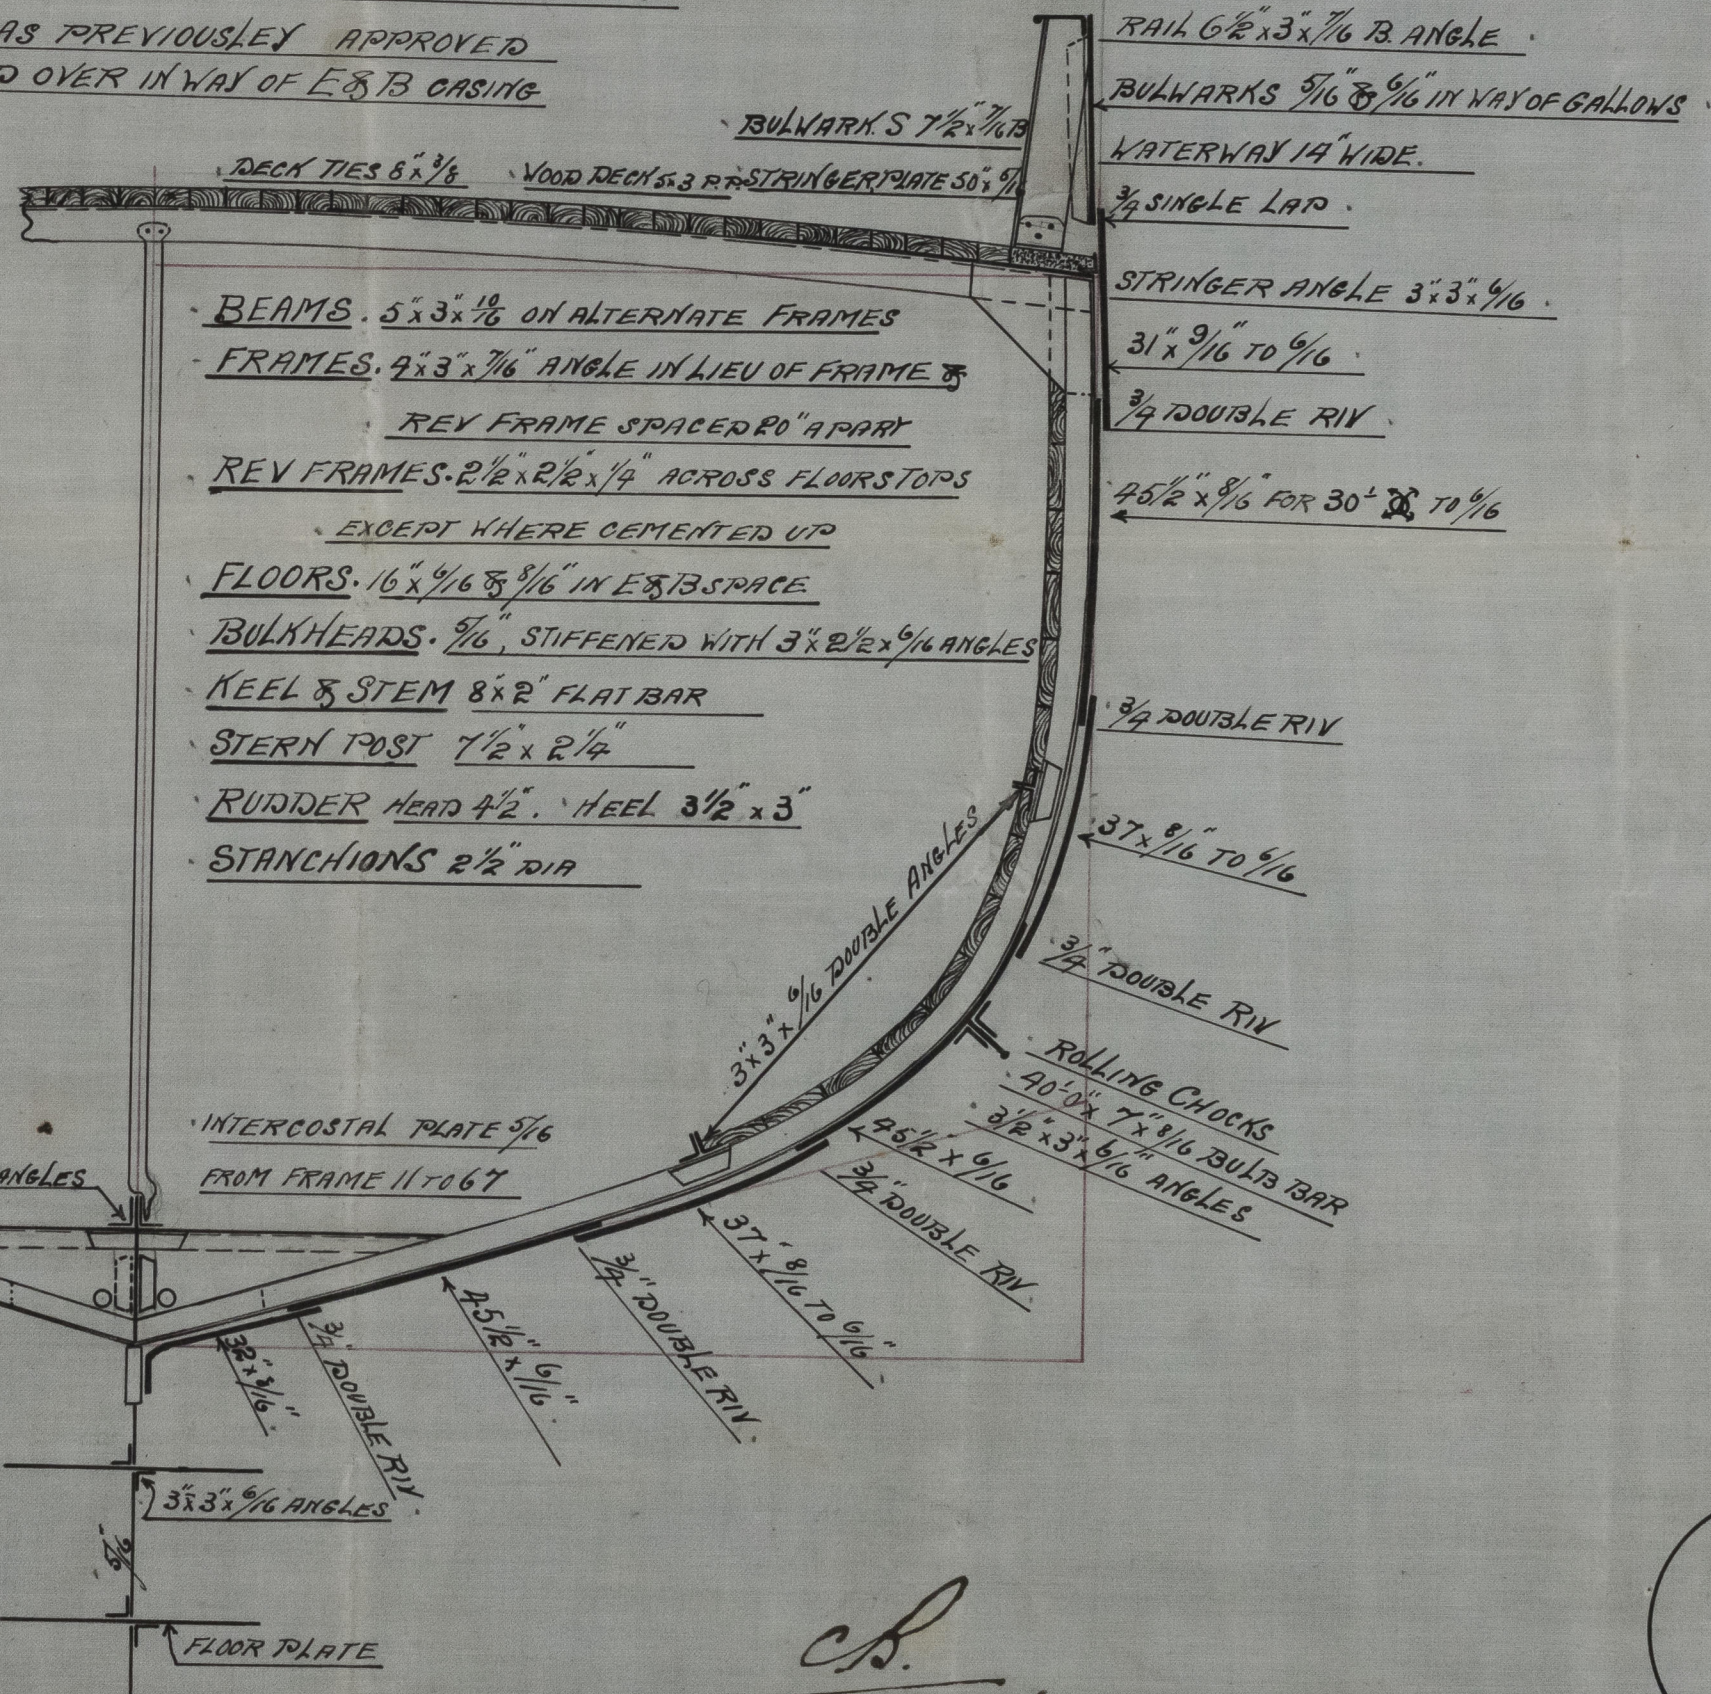

C.B.  
31.8.06.



No. 389.

S/S Bombay  
Null Rph. No. 188444

# Lloyd's Register

006067-006079-203