

MIDSHIP SECTION.

STEEL SCREW TRAWLERS

NOS. 417. 418. 419. & 420.


LENGTH. 105'-0" x 21'-6" EX x 12'-0" MOULDED.

SCALE $\frac{1}{2}$ " = 1 FOOT.

TO CLASS 100.A1. STEAM TRAWLER

DECK PLATED OVER IN WAY OF MACHINERY SPACE

MACHINERY CASING AS PREVIOUSLY APPROVED.

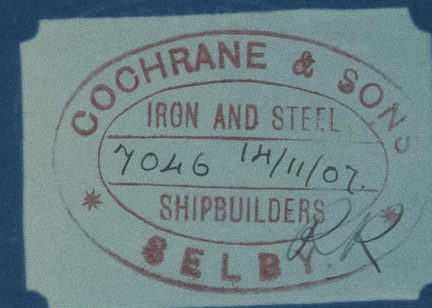

NUMERALS.

1/2 BREADTH	10.7	L/B 4.85
1/2 GIRTH	18.58	
DEPTH	12.43	L/D 8.35
1ST NO.	41.71	
	103.87	
2ND NO.	4332.6	

EQUIPMENT

1ST BOWER ANCHOR	4 1/2 CWT EX STOCK
2ND	" 4 " "
3RD	" 2 1/2 " "
75 FATHOMS	15/16" SHORT LINK CABLE
60	5 1/2" HAWSER
60	3 1/2" WARP.



Lloyd's Register
Foundation

Handwritten notes and signatures in the bottom right corner, including a signature and the date 05.11.14.

Cochrane & Sons.

N^{os} 417, 418, 419 and 420.

Duplicate

Midship Section.

s/s 'Boreas'

Hull Report No 19618



© 2021

Lloyd's Register
Foundation

006080-006095-0063