

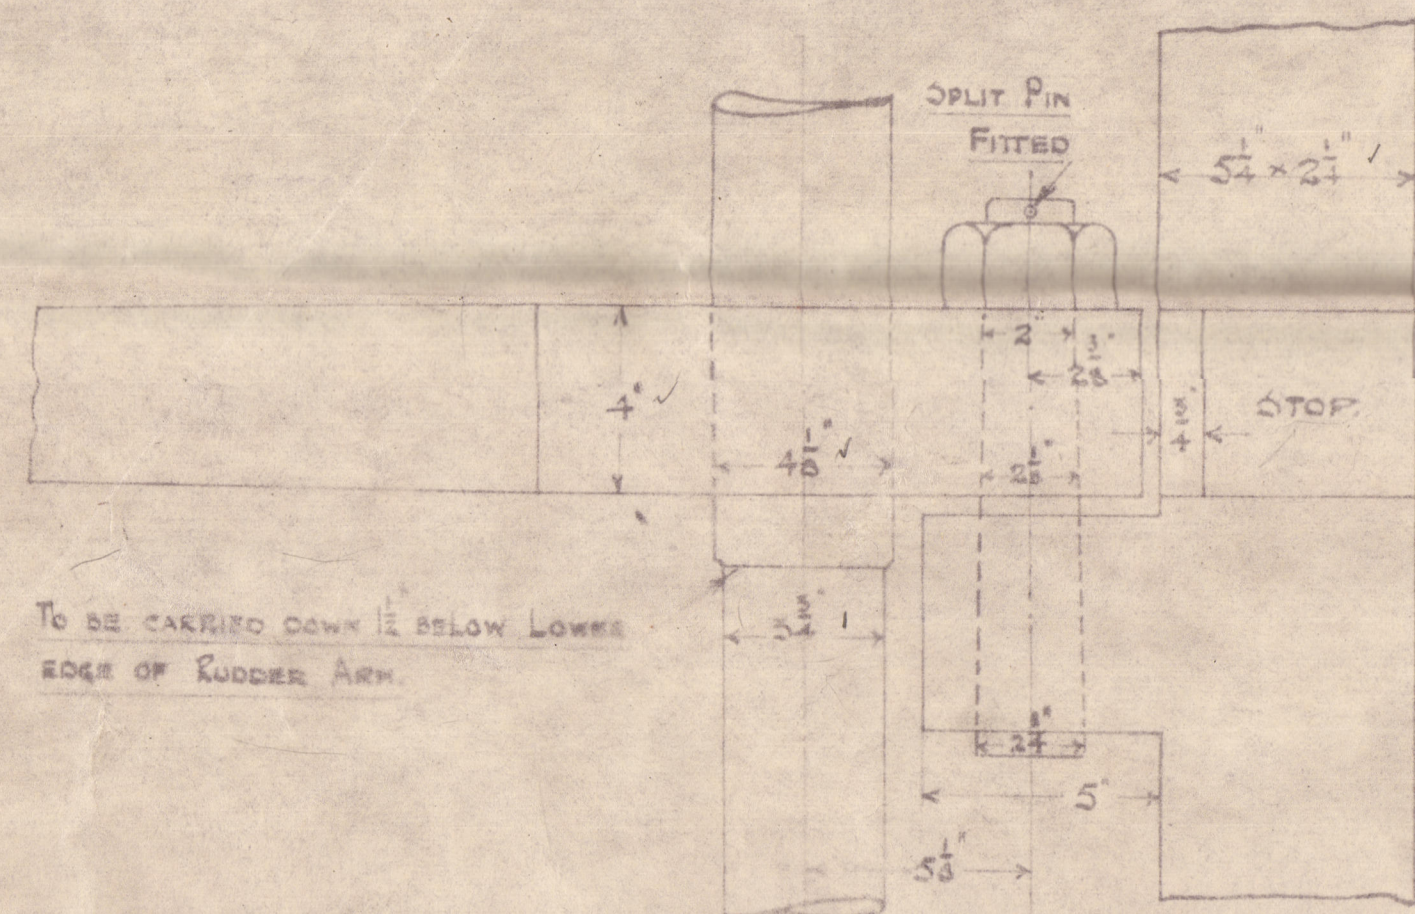
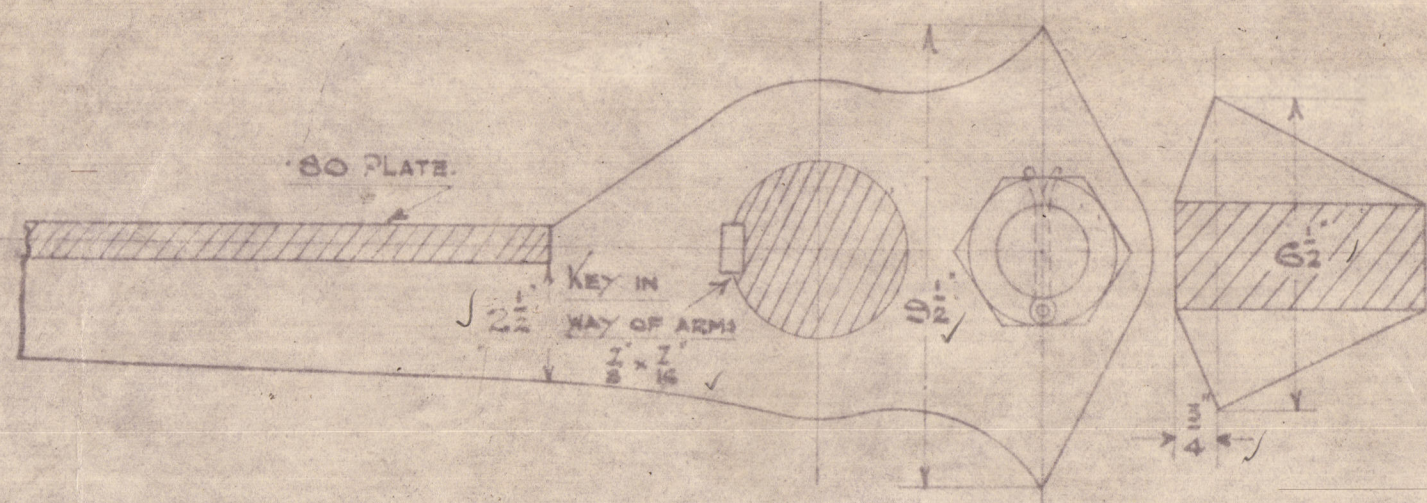


22/8/18

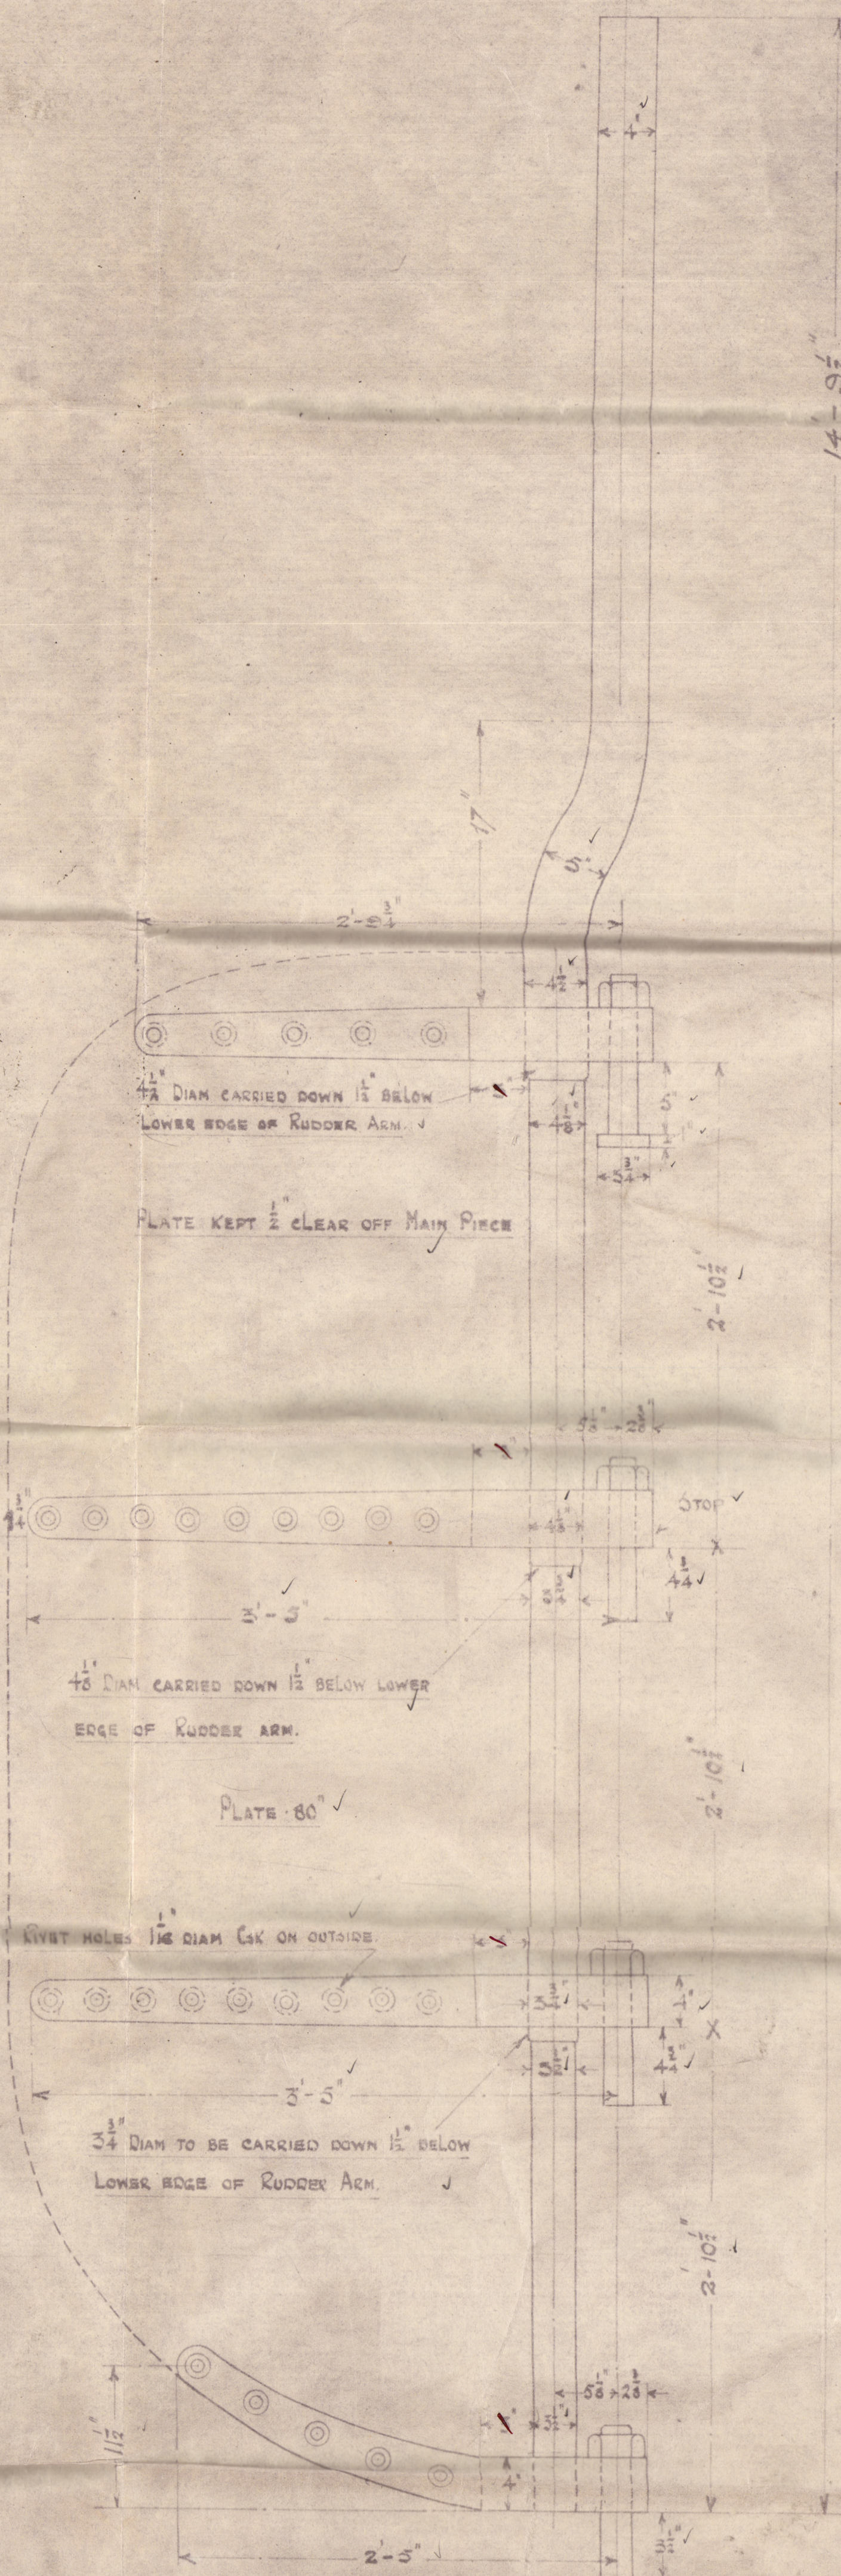

STOP ON STERN & RUDDER FRAMES
SCALE: 3" = ONE FOOT.

PINTLES 2 1/2" DIAM.
NECKS OF PINTLES TAPER TO 2 1/4"
DOWELS OF PINTLES 2" DIAM.
THICKNESS OF METAL ROUND MAIN PIECE 3/4"

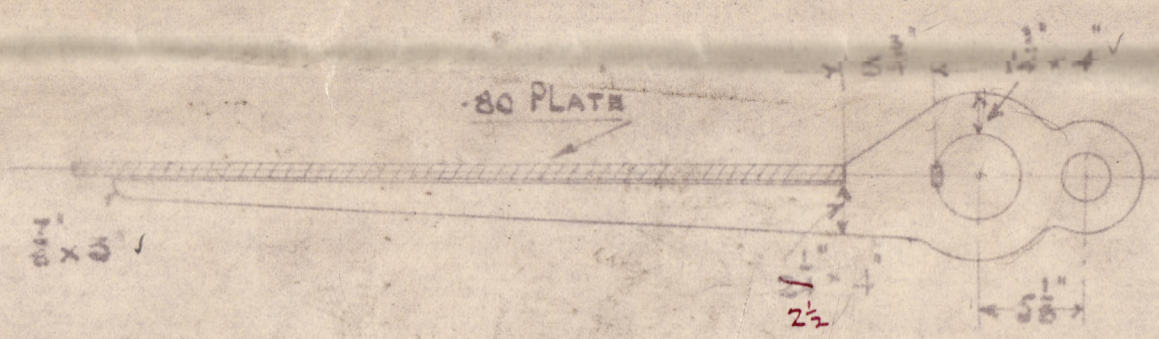


STERN & RUDDER FORGINGS

STEEL SCREW DRIFTERS

YARD No 174-5.

SCALE: 1 1/2" = ONE FT.

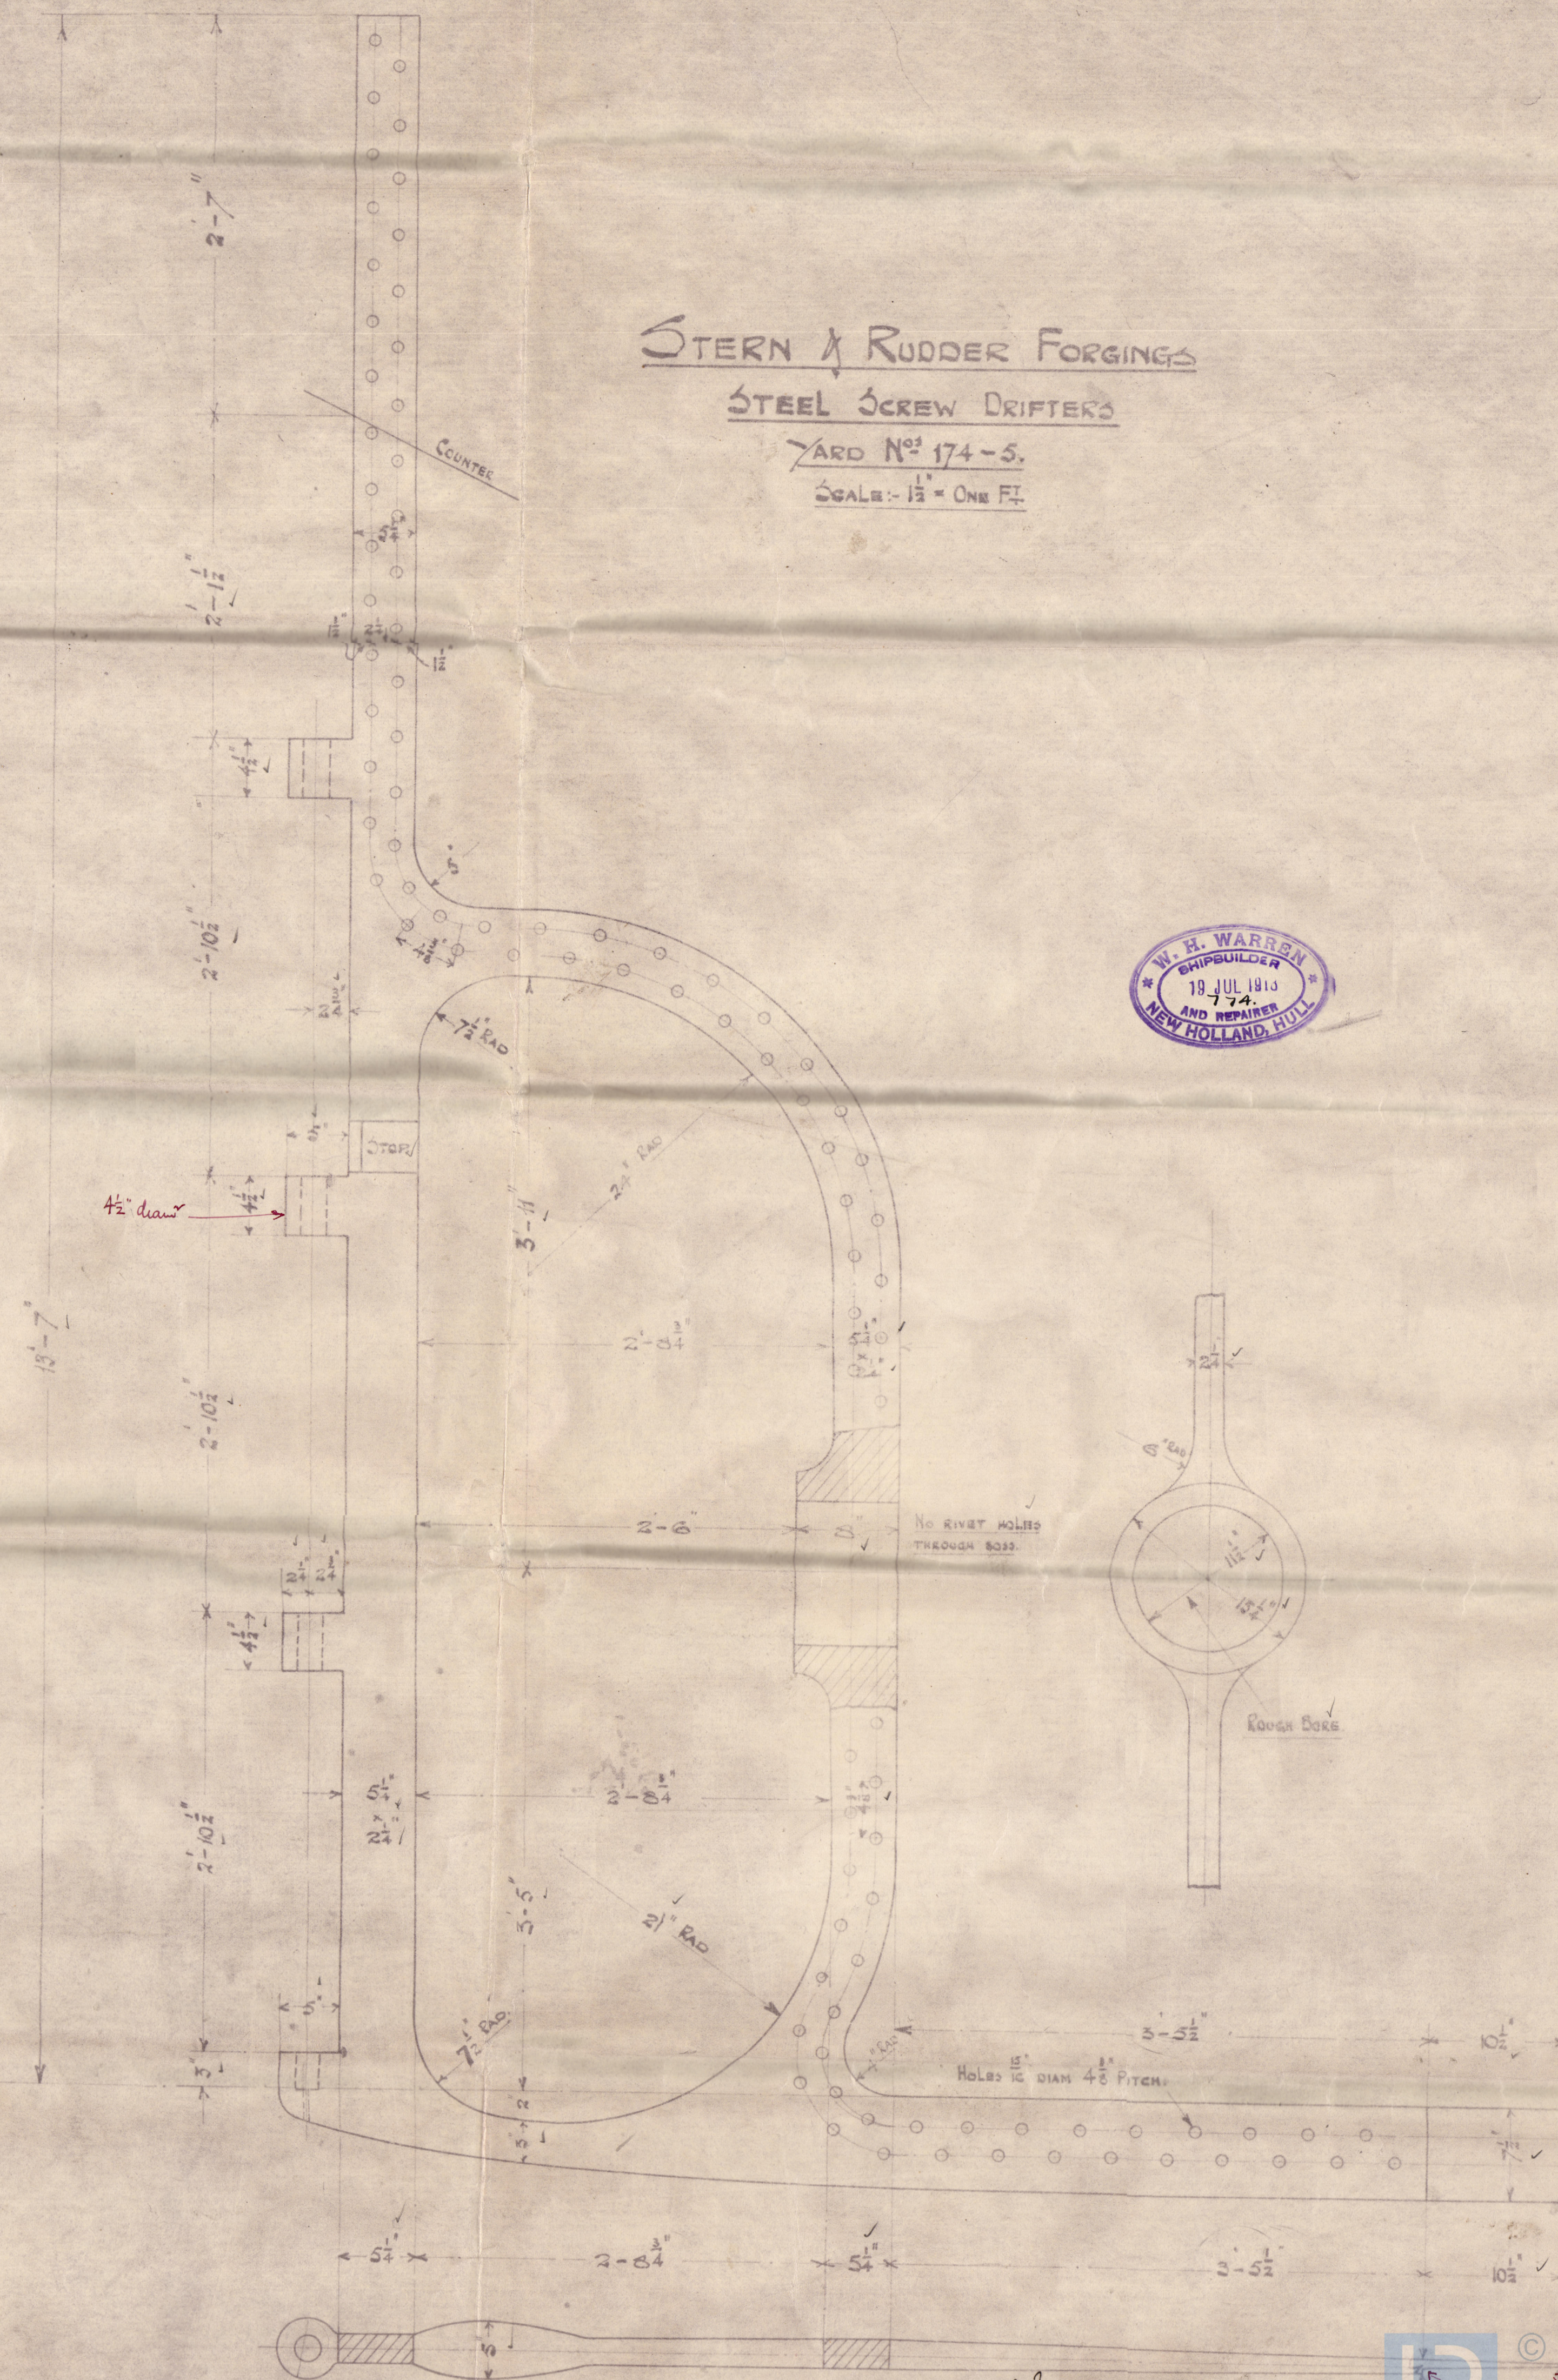

C7.
22.8.18

Steel Drifters

W. H. Warren, New Holland

No 174 + 175

Plan of Stern frame
& Rudder.

Hull Report to. 32126.

174. Windrise Hull. 32126

175. Windshift Hull 32227.



© 2020

Lloyd's Register
Foundation

006096-006110-0059