

N<sup>o</sup>. 7.




16.5.03

T. S. N<sup>o</sup> 665.

— PLAN OF RUDDER & STERNFRAME. —

See later plan of Rudder

SCALE  $\frac{1}{2}$  INCHES TO THE FOOT

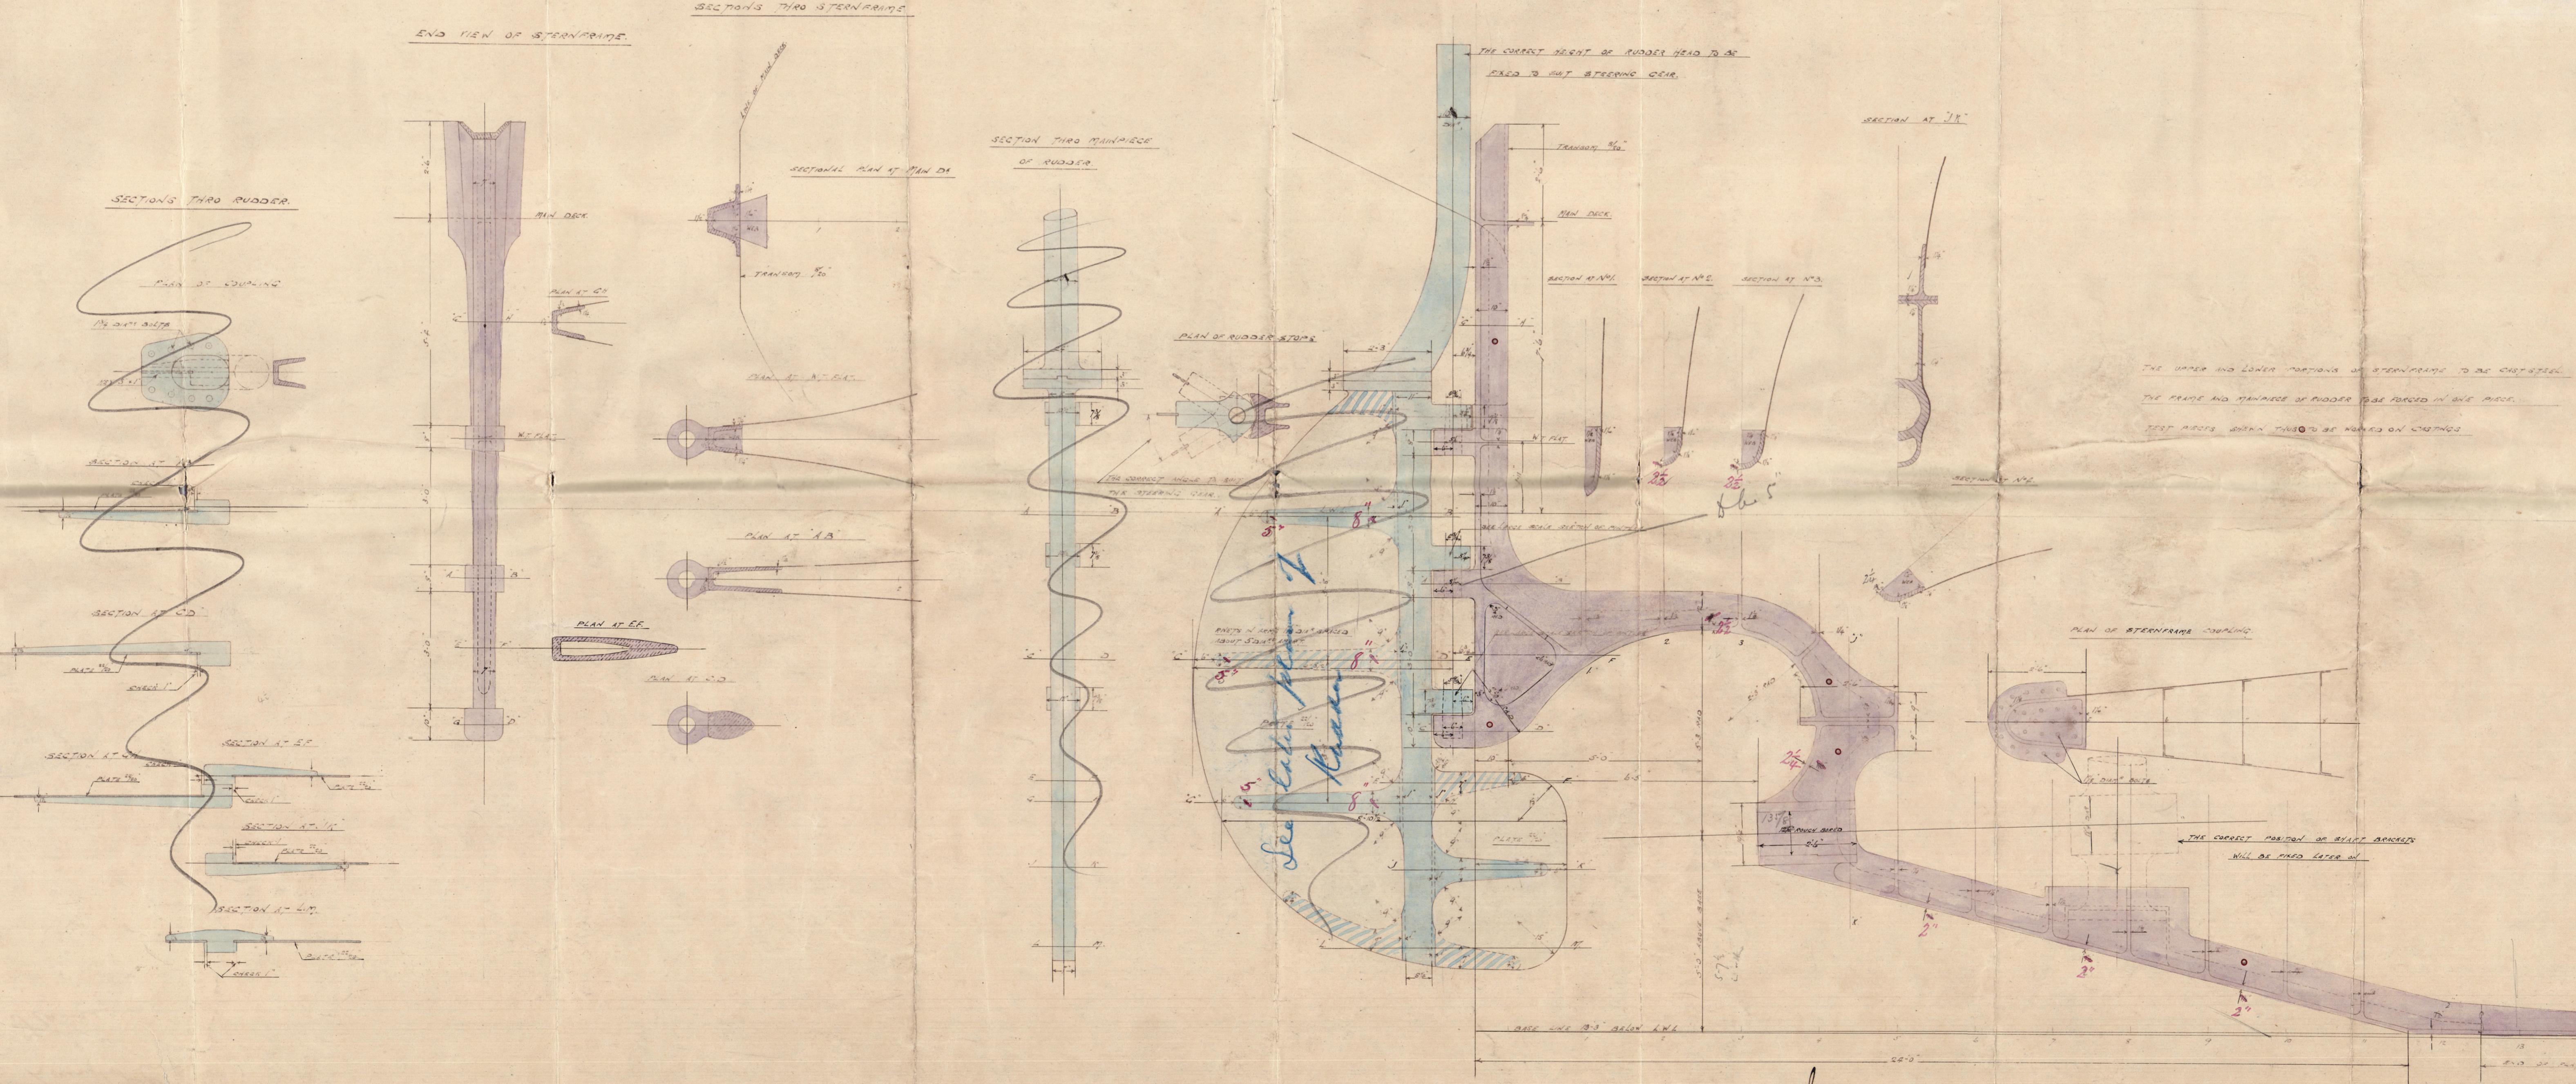

© 2020

Lloyd's Register

006111-00612019188

No 665-

Building by Messrs  
Cameron Laidlow & Co

Stern Frame  
Turbine 11 St George

Liverpool N 58263



© 2020

Lloyd's Register  
Foundation

006111-006125-0168