


PLAN N° 406

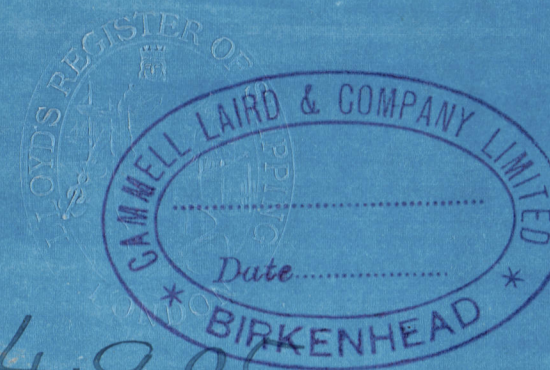


4.9.05

— T. S. N° 665. —

— PLAN OF RUDDER. —

SCALE 1/2" = 1 FOOT.

SECTION TWO PAINPIERS

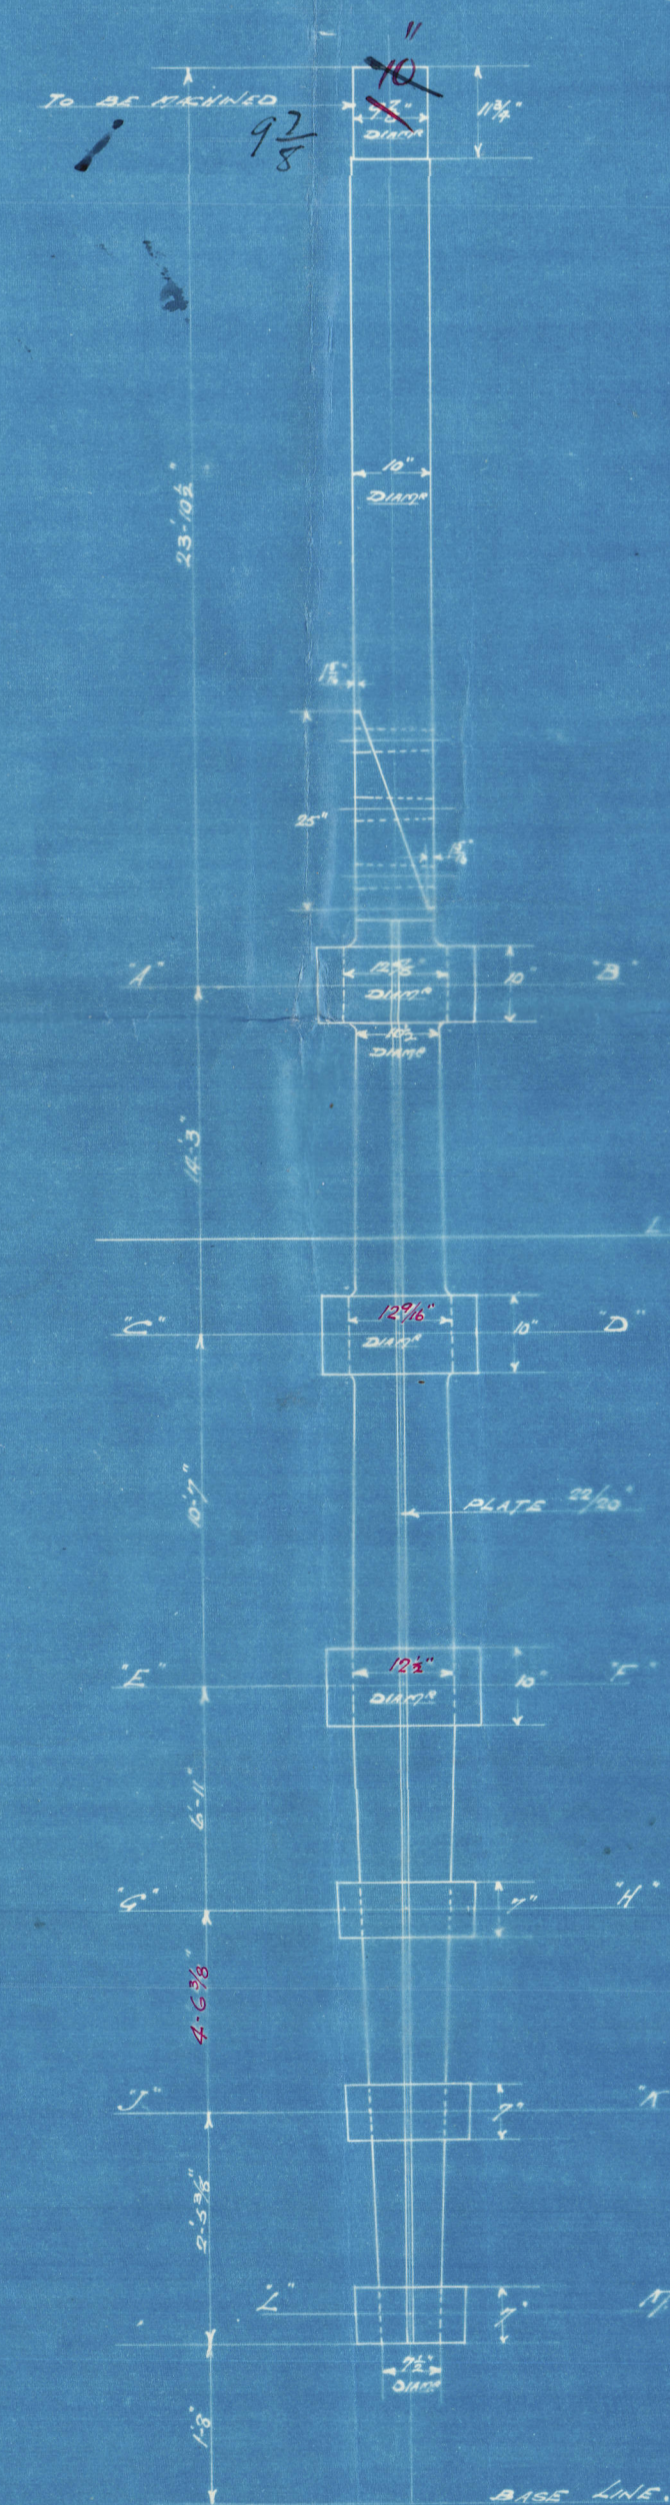

PLAN AT 13'

PLAN AT 20'


PLAN AT 27'

PLAN AT 34'

PLAN AT 41'

PLAN AT 48'

PLAN AT 55'

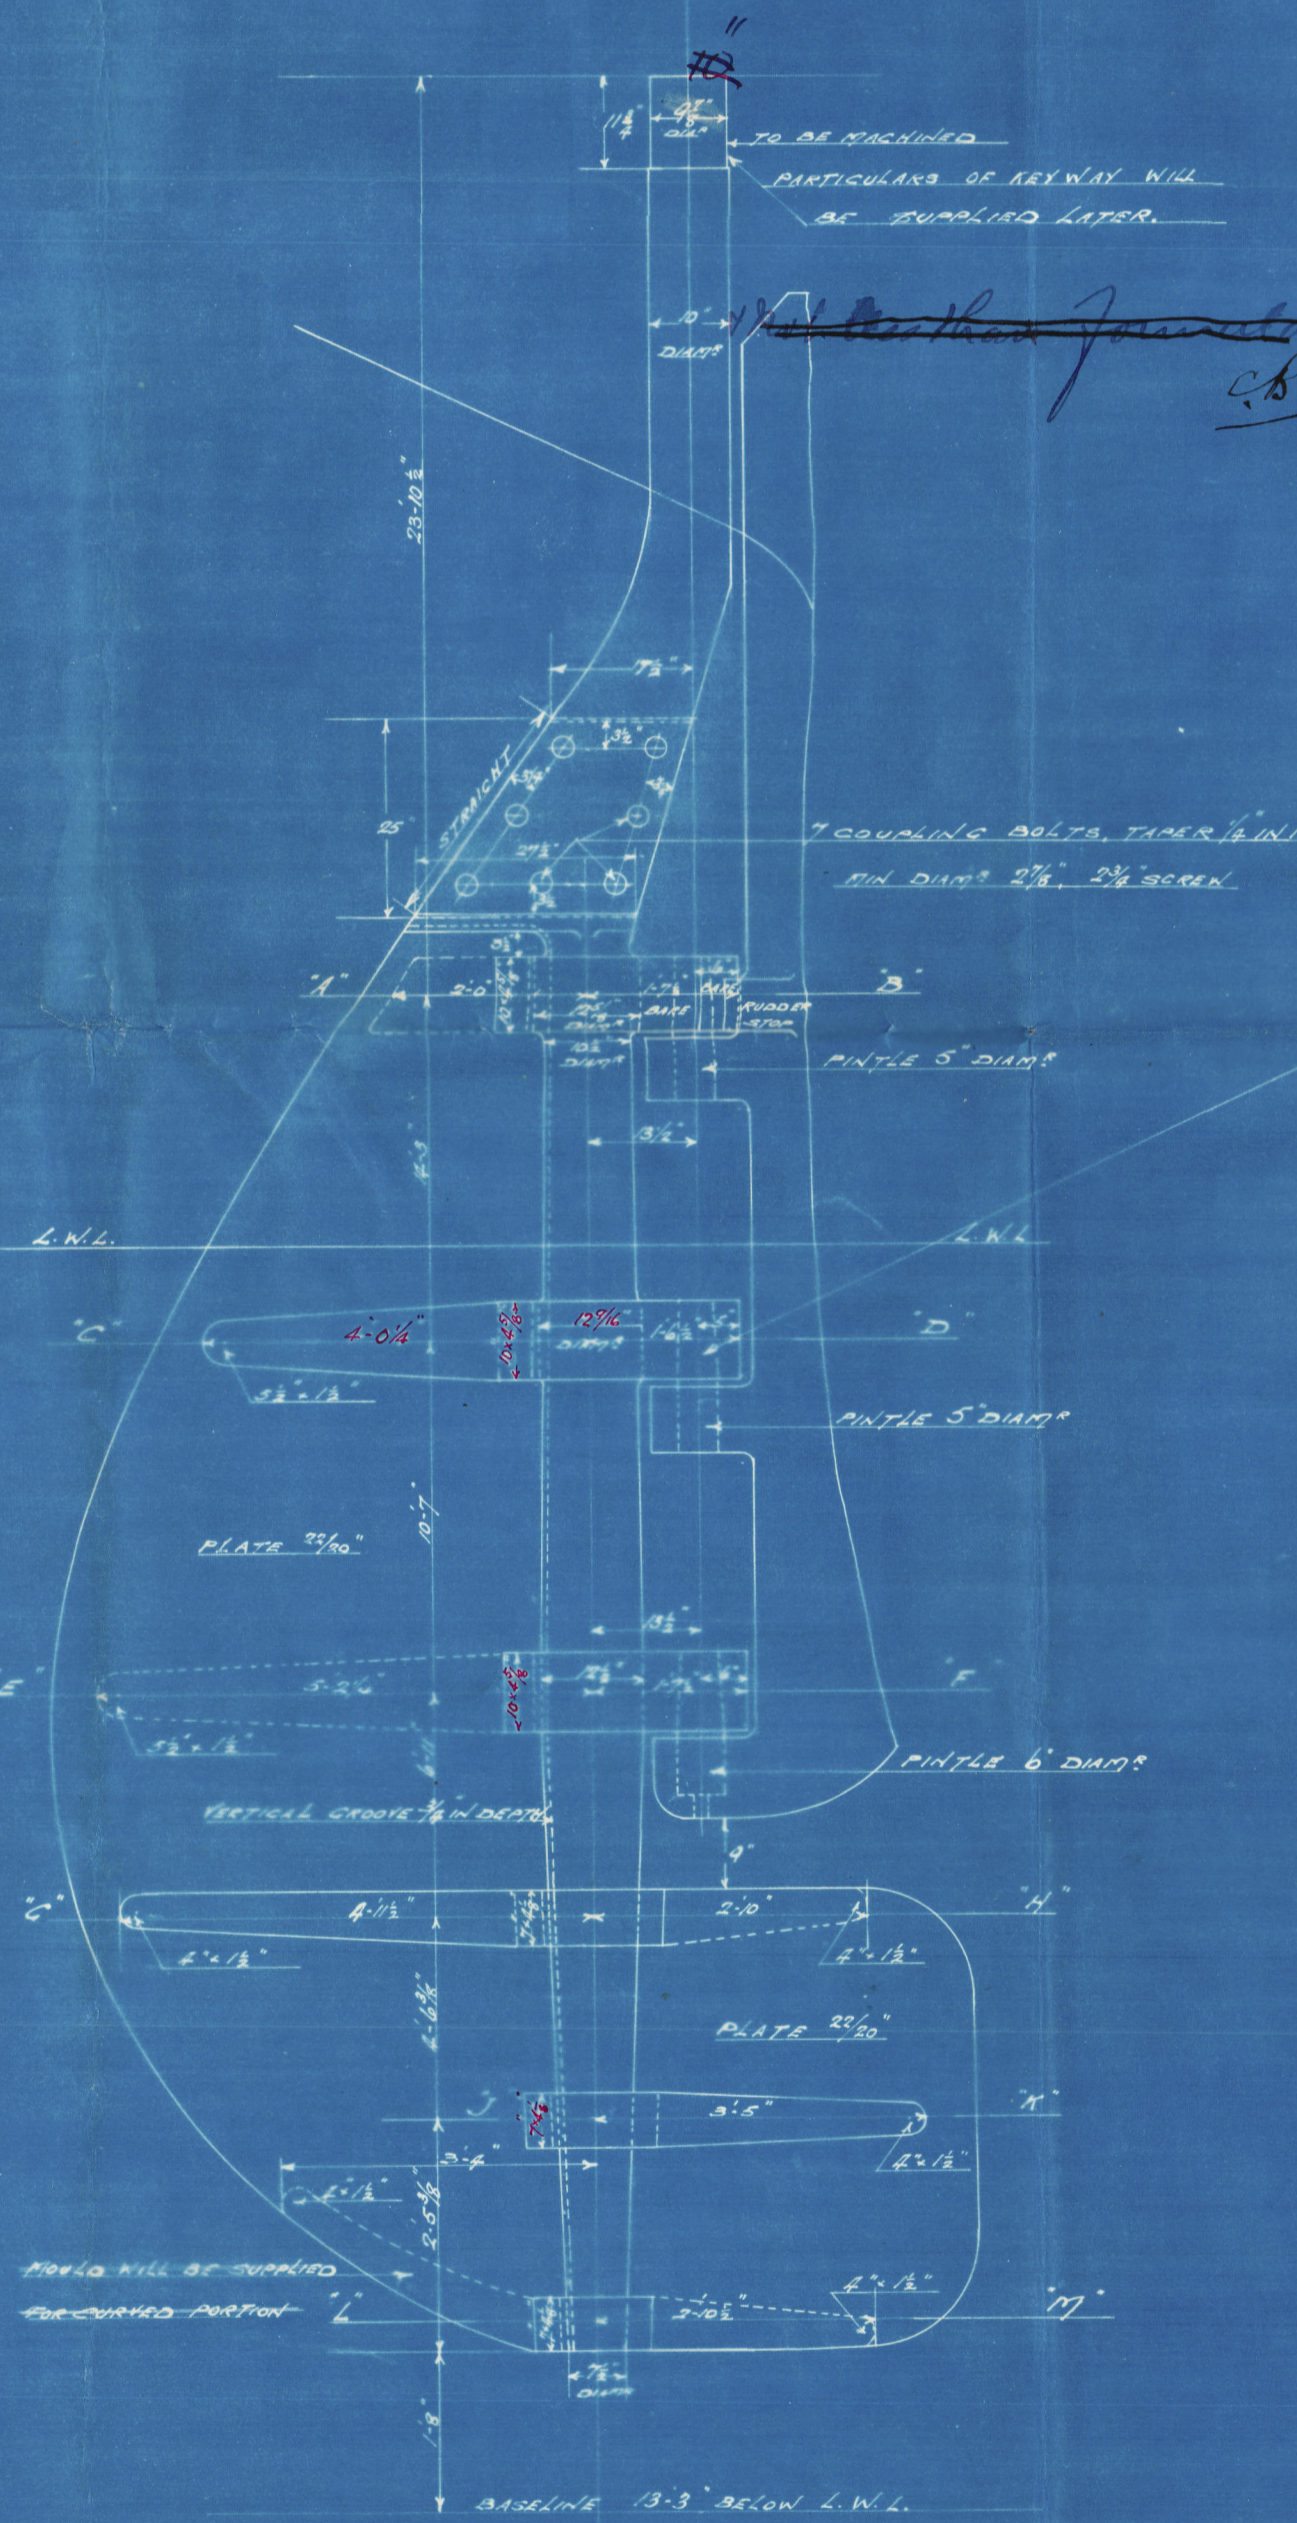

SECTIONAL ELEVATION OF TOP RINTE



SECTIONAL ELEVATION OF BOTTOM RINTE

SCALE 1/2" = 1 FOOT.

STOCK IS NOT TO BE FROM GLENN'S MARTIN MOOT  
APPROX. FROM SCARP MON.  
TO LLOYD'S & BANK OF TRADE REQUIREMENTS & TESTS.

DETAIL OF INTERLOCKING SCARFED JOINT.

SCALE 1" = 1 FOOT.

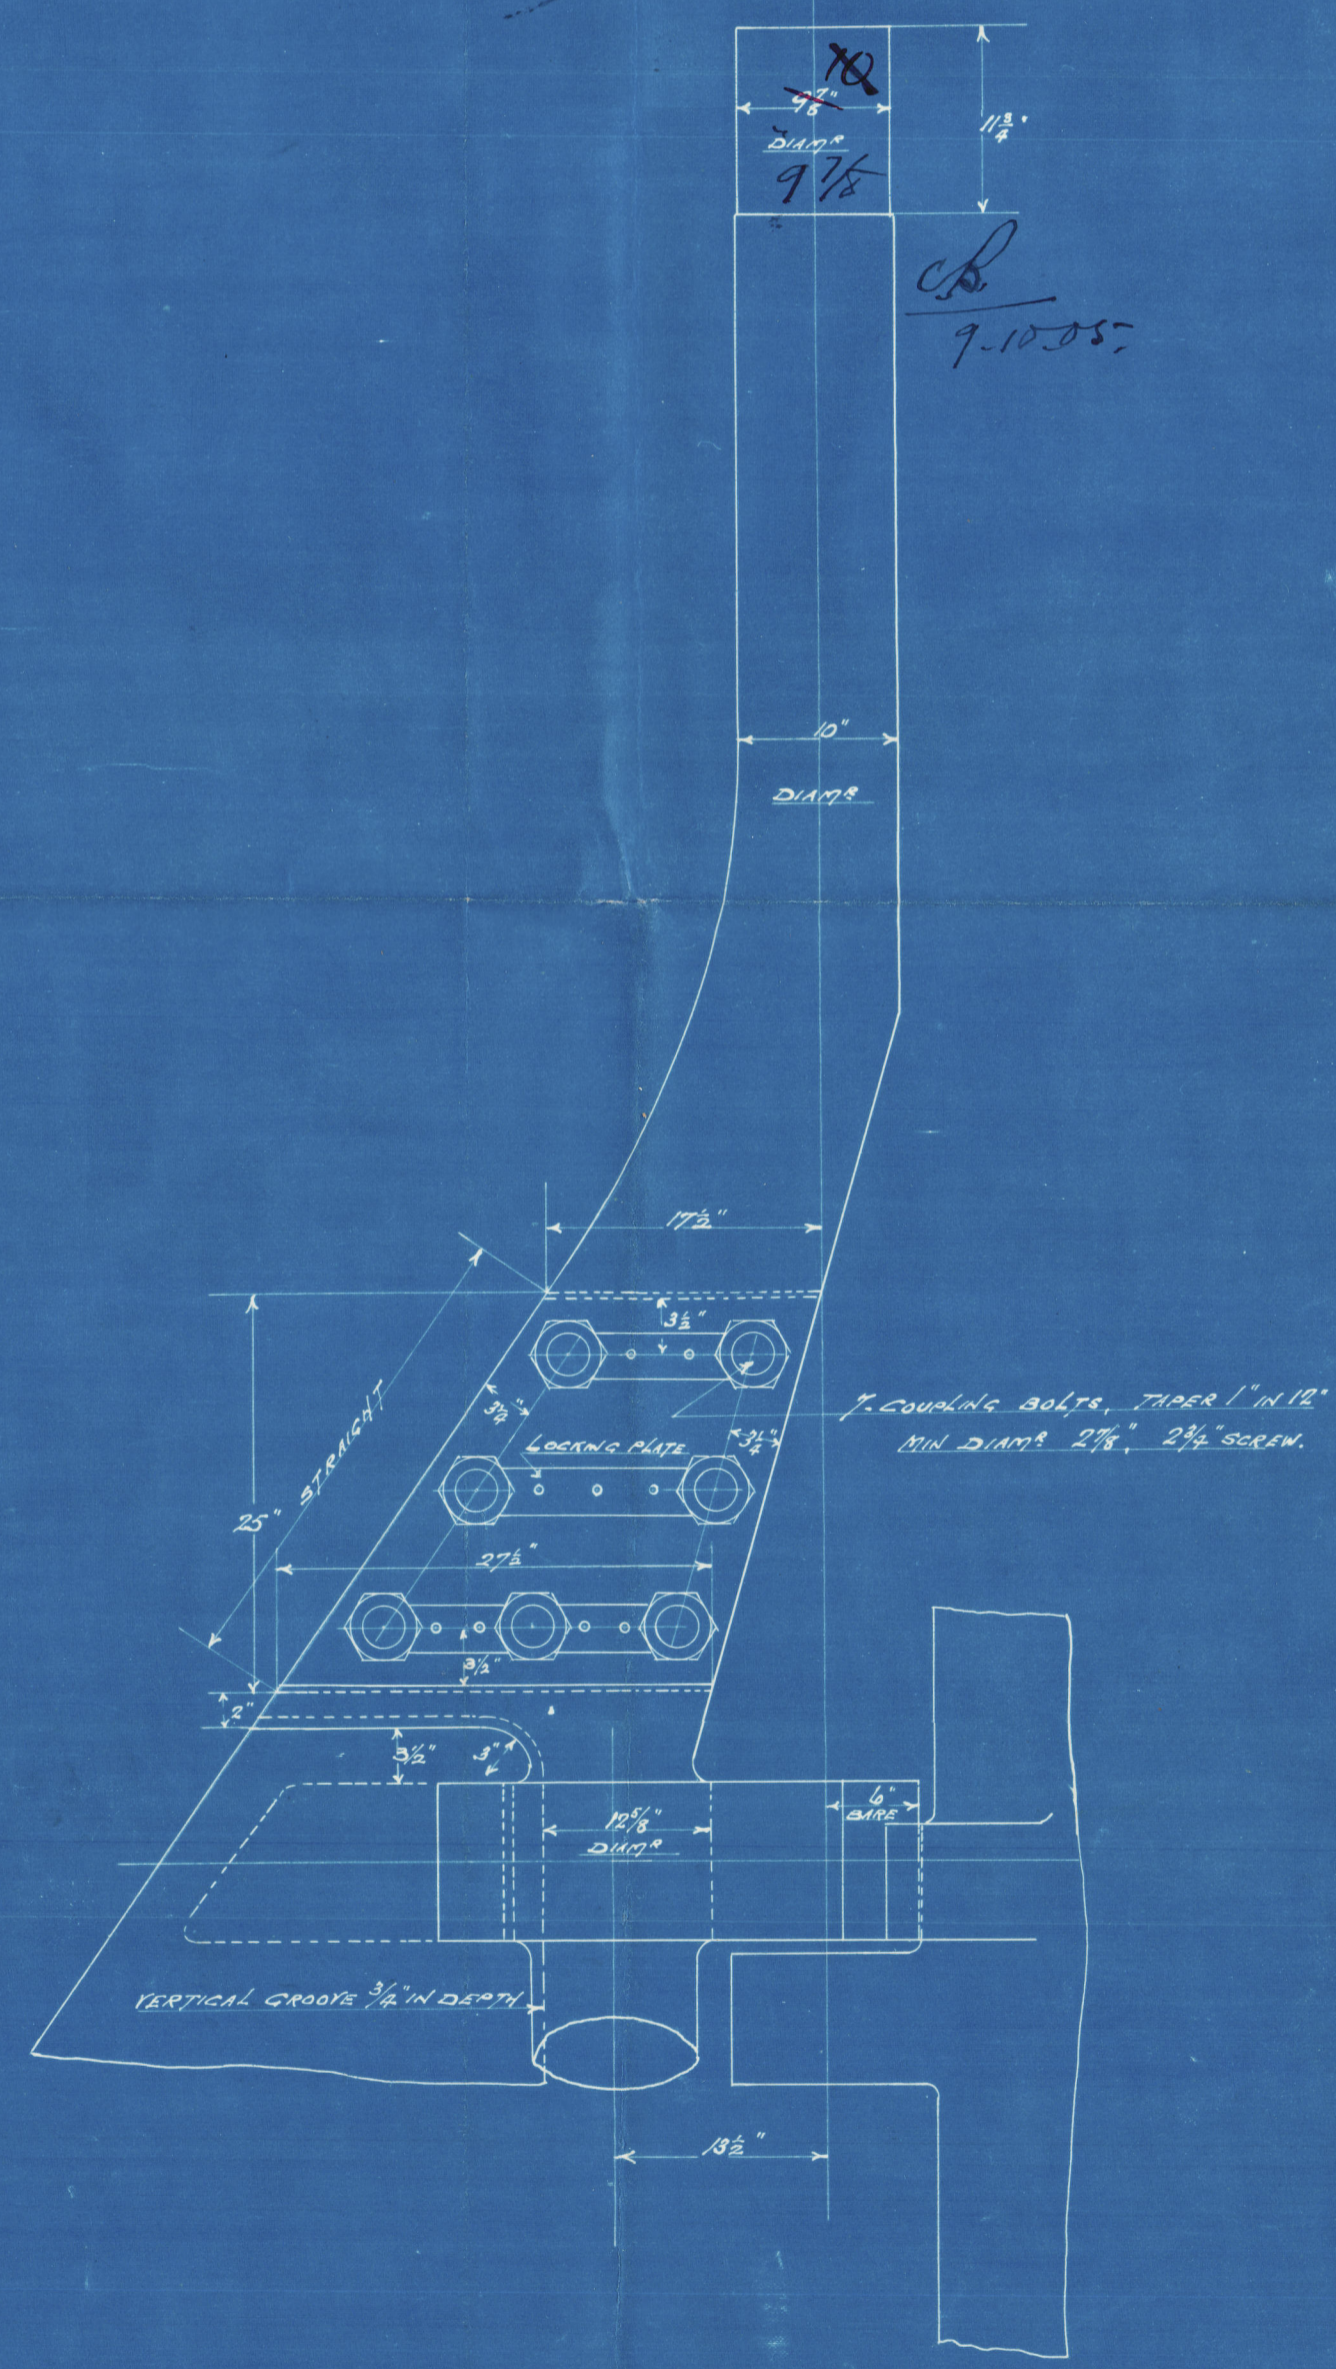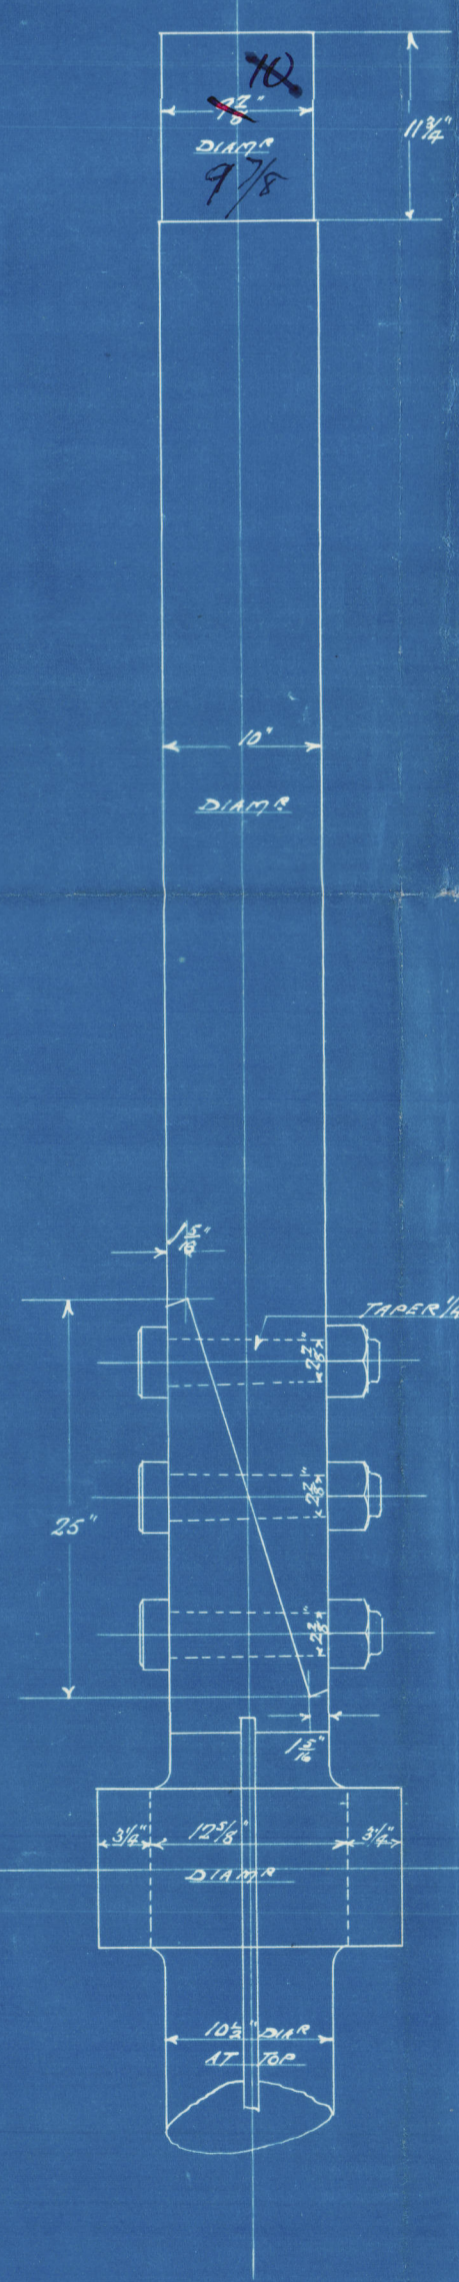

C.B.  
4.9.05

Nº 665

RUDDER

4/9/05

Turline 1. 1. St George

Quatre N. 58263



© 2020

Lloyd's Register  
Foundation

006111-000125-0169