



No 446

TURBINE CHANNEL STEAMER
FOR THE
FISHGUARD & ROSSLARE RAILWAYS AND HARBOURS CO.


SCALE 1/16" = ONE FOOT

PROPOSED BY:-



9.3.05
18.4.05
1.6.05
9.6.05
21.8.05
13.9.05

14'-6"

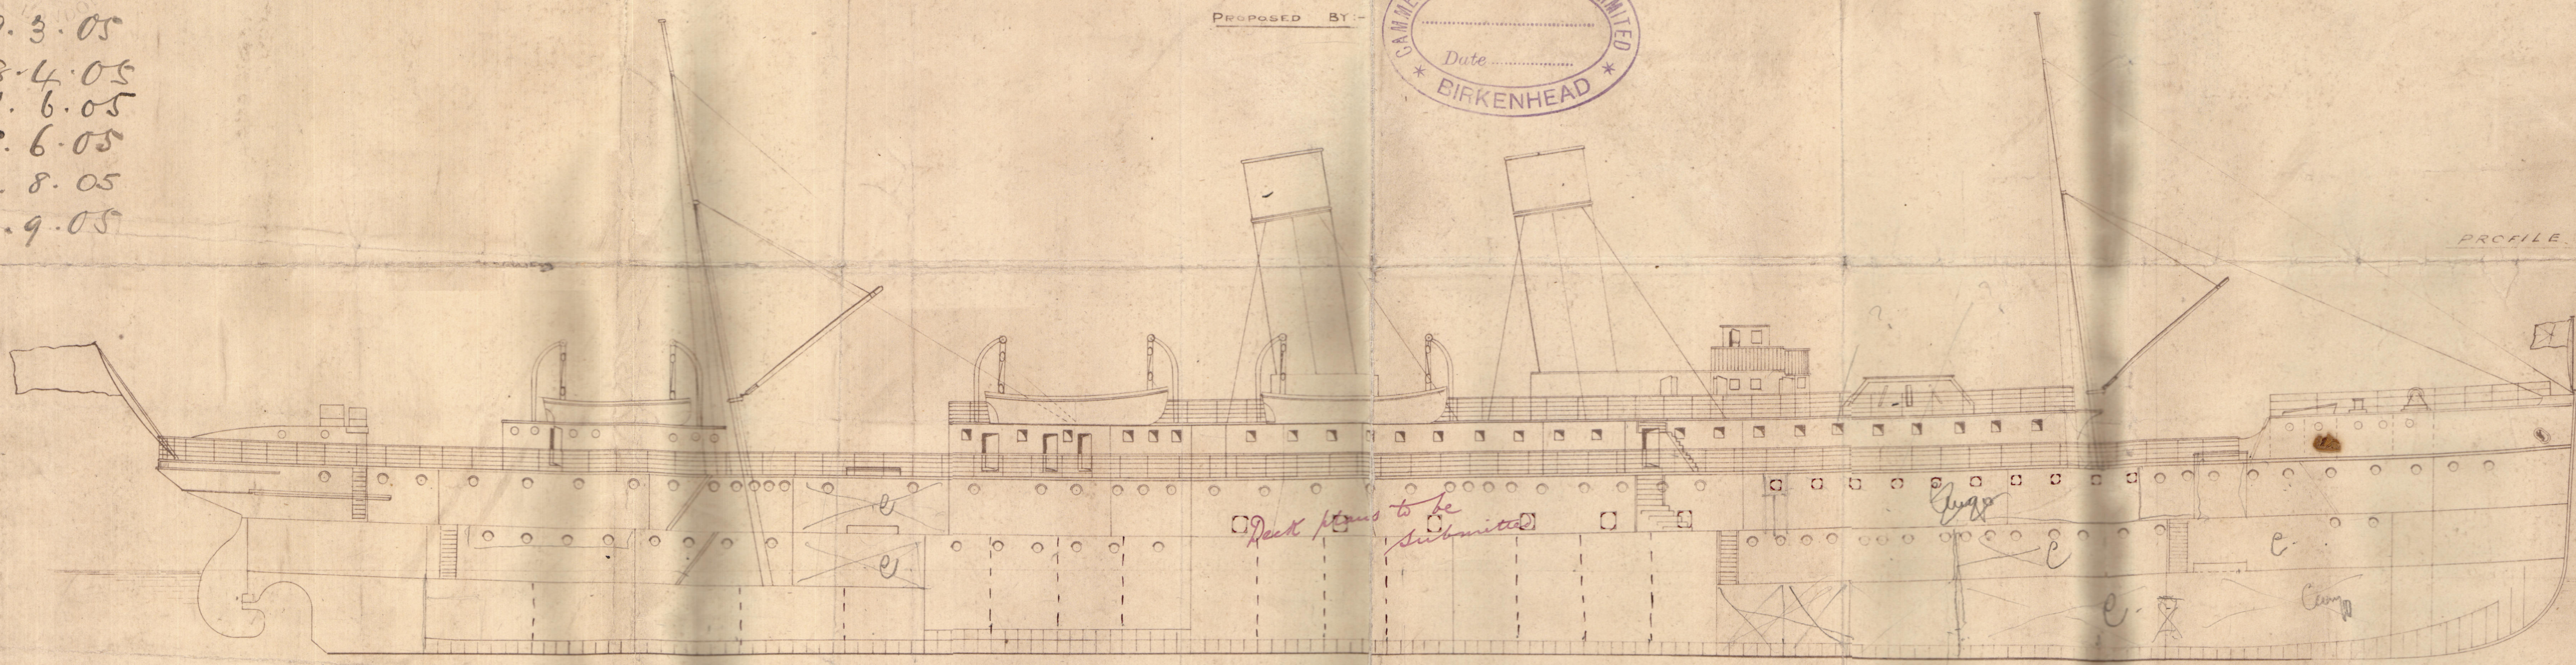

PROFILE


Deck plans to be submitted

Yard

Comp


Inter-portal centre line
Kelson aft

Inter-portal centre line for

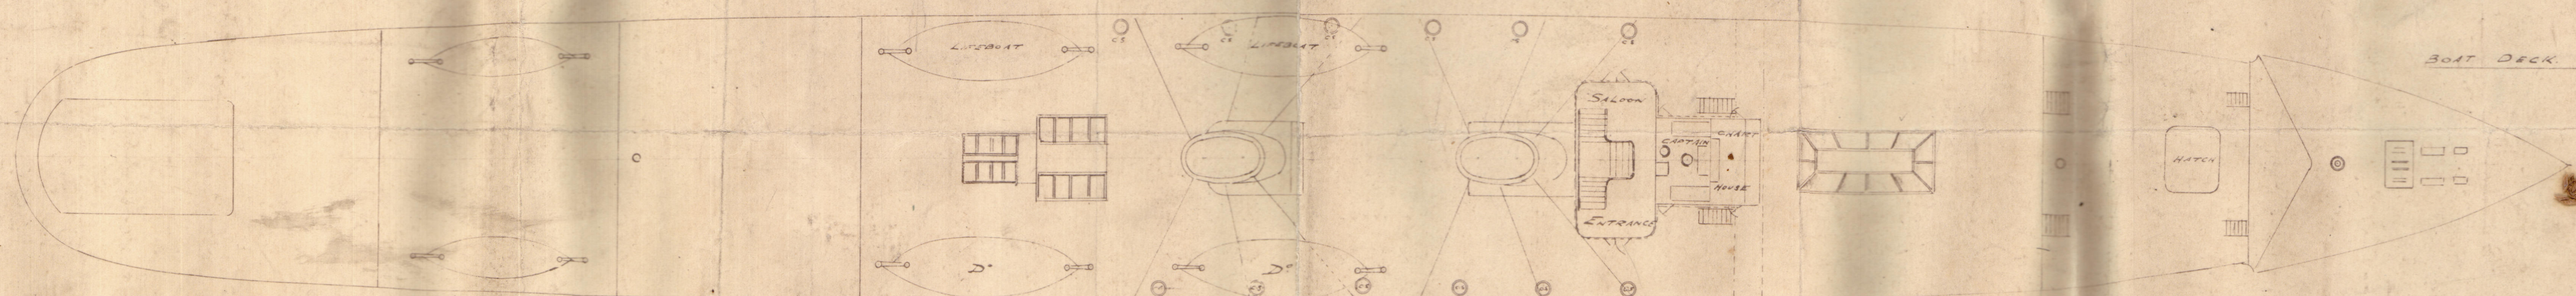


BOAT DECK

See notes on st side for plan submitted by Paul 18.12.13 to 14.12.13

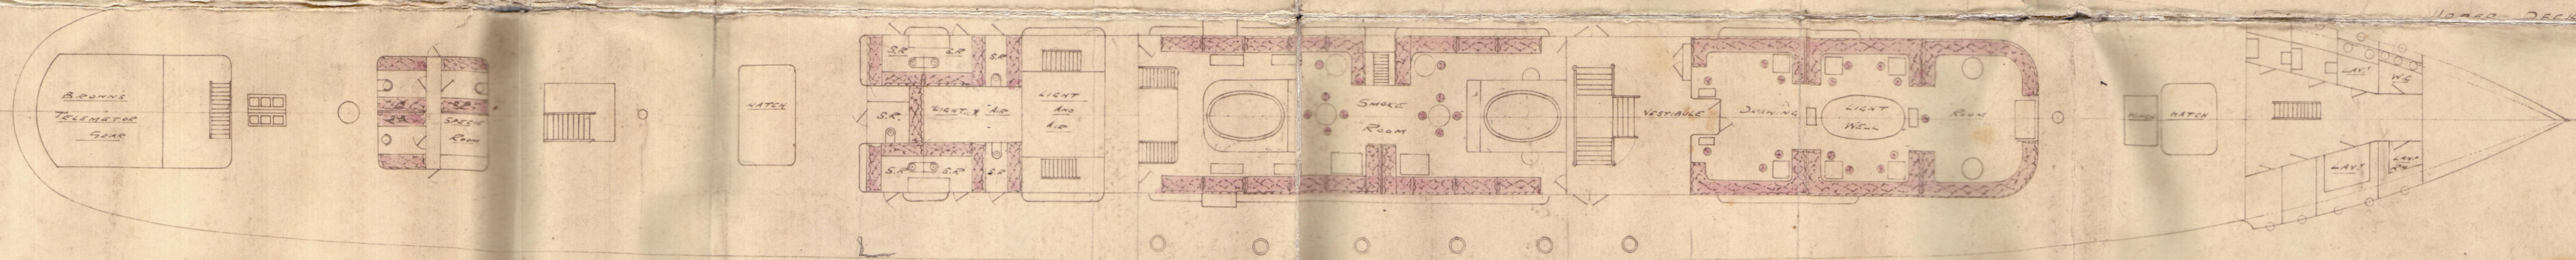


UPPER DECK

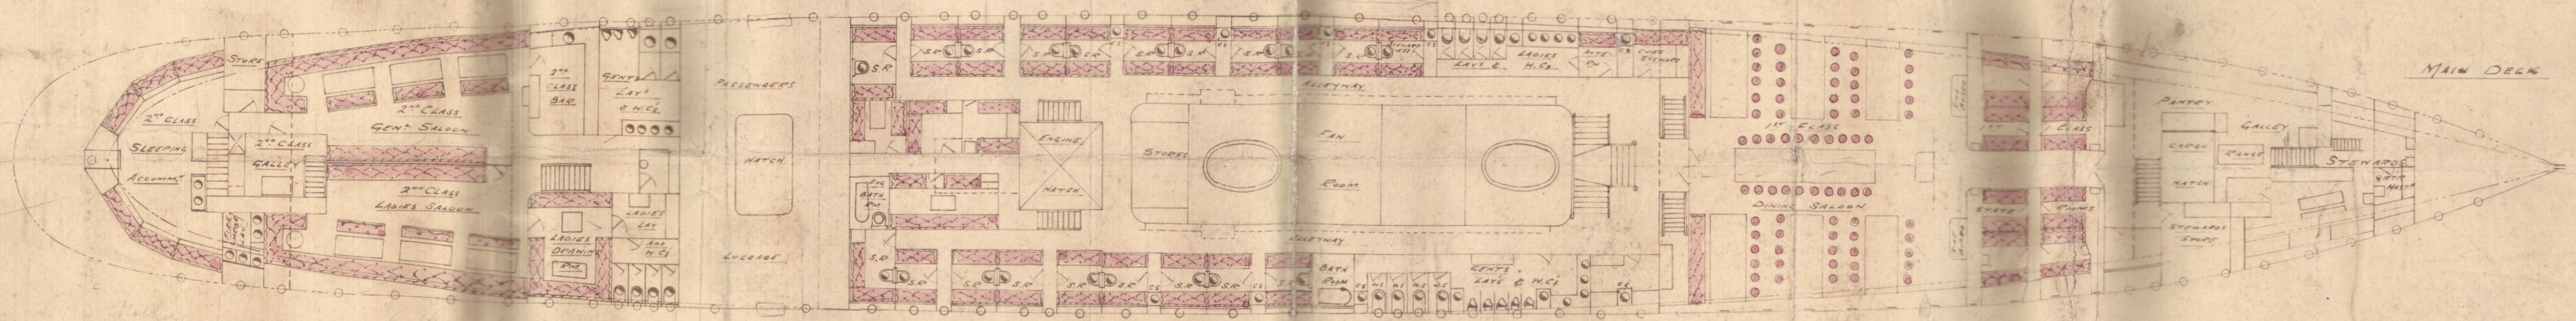

MAIN DECK



LOWER DECK

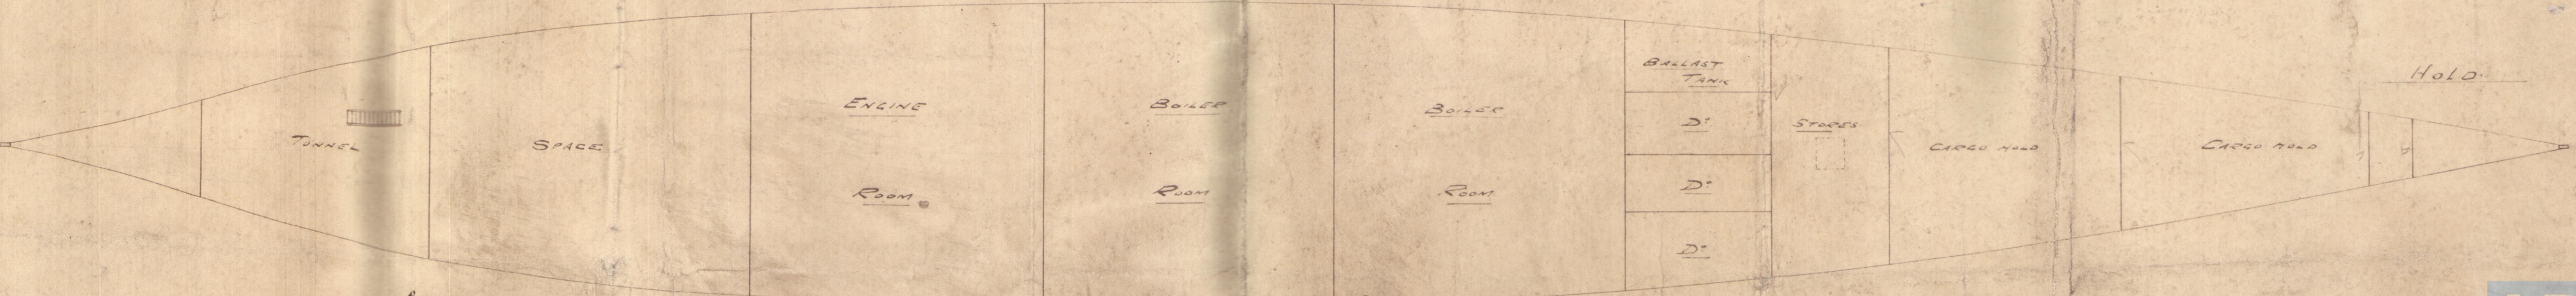

HOLD

J.V.L.
7/10/05



© 2020
Lloyd's Register
Foundation

00611-006125-0170

Triple L.S.

" So George."

Hall. Rpt: 31756

P/D



© 2020

Lloyd's Register

006111-006125-0170

Foundation