


S/S 'St George'

SCALE $\frac{1}{2}$ = 1 FOOT.

$\frac{1}{2}$ BEAM	20.5	
$\frac{1}{2}$ GIRTH	34.75	
DEPTH	18.27	
LENGTH	73.52	1 ST NUMERAL
	350	
	257 32.0	2 ND NUMERAL
DEPTHS TO LENGTH	19.1	
BREADTHS	8.5	

9. 3. 05
18. 4. 05
1. 6. 05
9. 6. 05
21. 8. 05
13. 9. 05
13. 10. 05

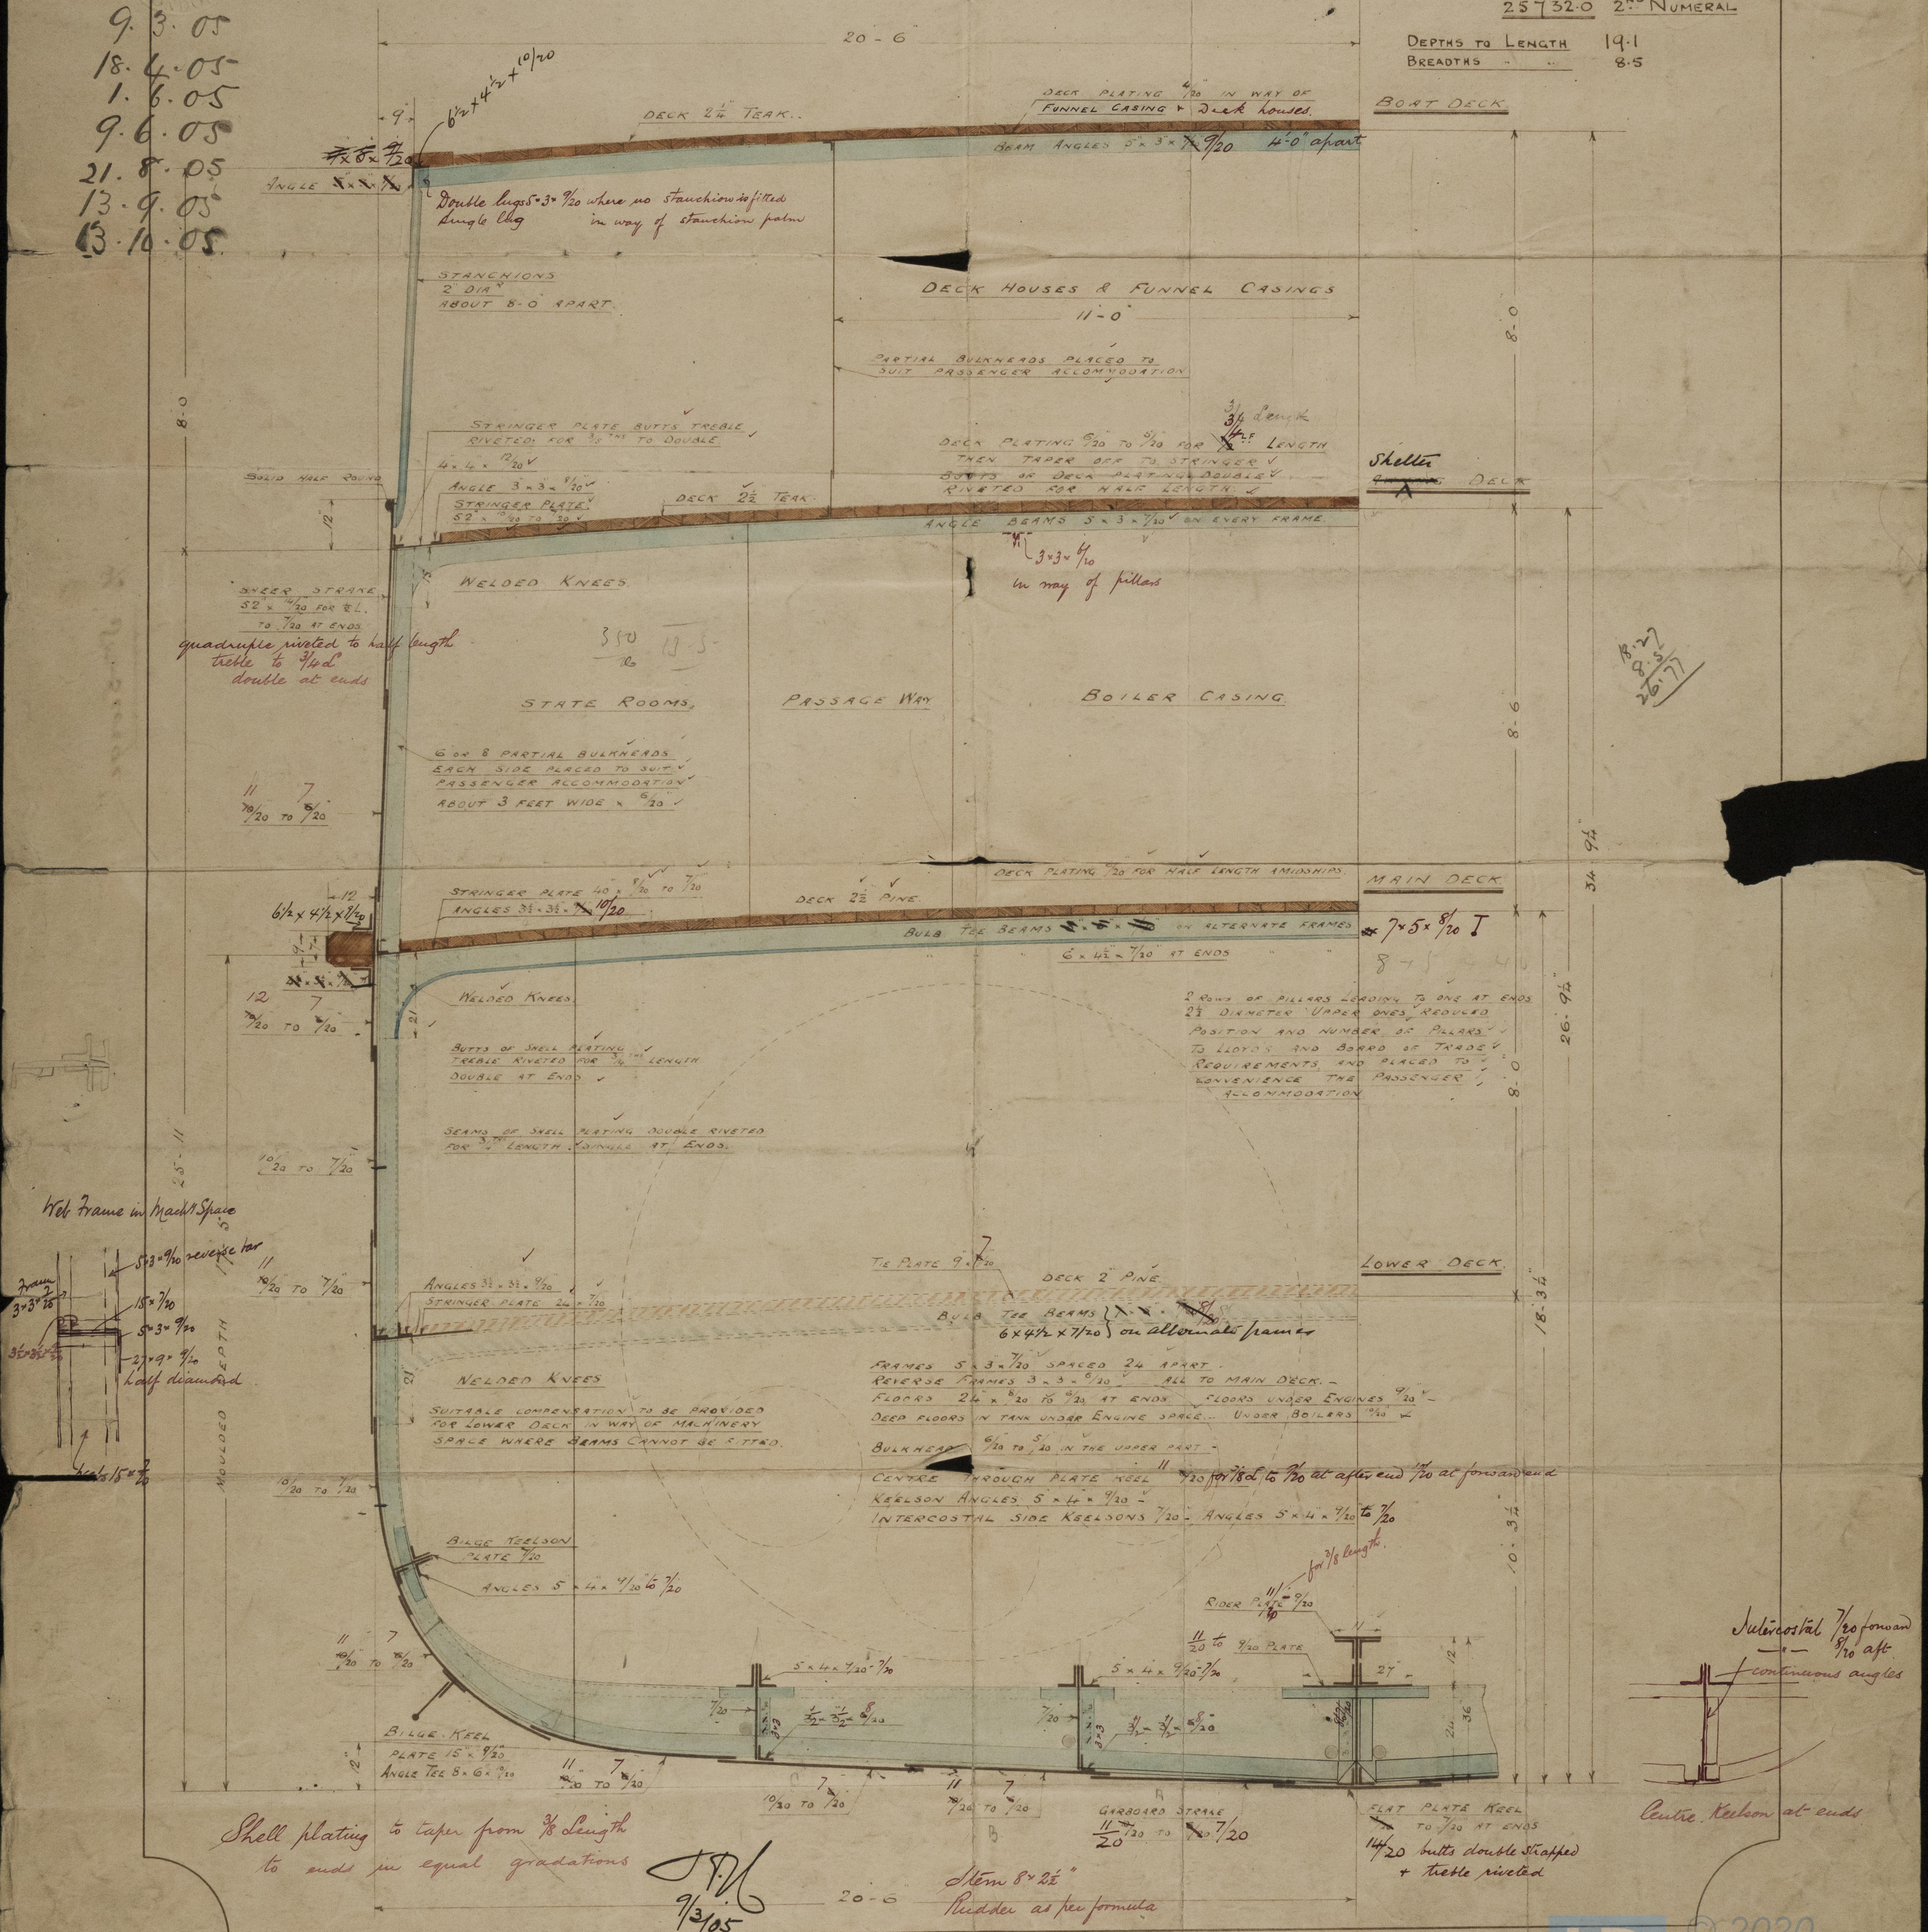

Shell plating to taper from $\frac{3}{8}$ Length
to ends in equal gradations

Stem $8 \times 2\frac{1}{2}$ "
Rudder as per formula




MIDSHIP SECTION

Nº 665

APPROVED BY LLOYD'S

St George's

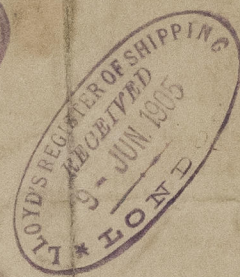

St George's

Liverpool rps N. 58263.

Chise (119)



Three dots



© 2020

Lloyd's Register

006/01+006/25-0771