


T.S.S. APPLELEAF

PLAN SHOWING ALTERATION TO EXISTING BALLAST LINE FOR
FUEL PUMP SUCTIONS FROM FORWARD COFFERDAM.

SCALE: - 1" = 1 FOOT.

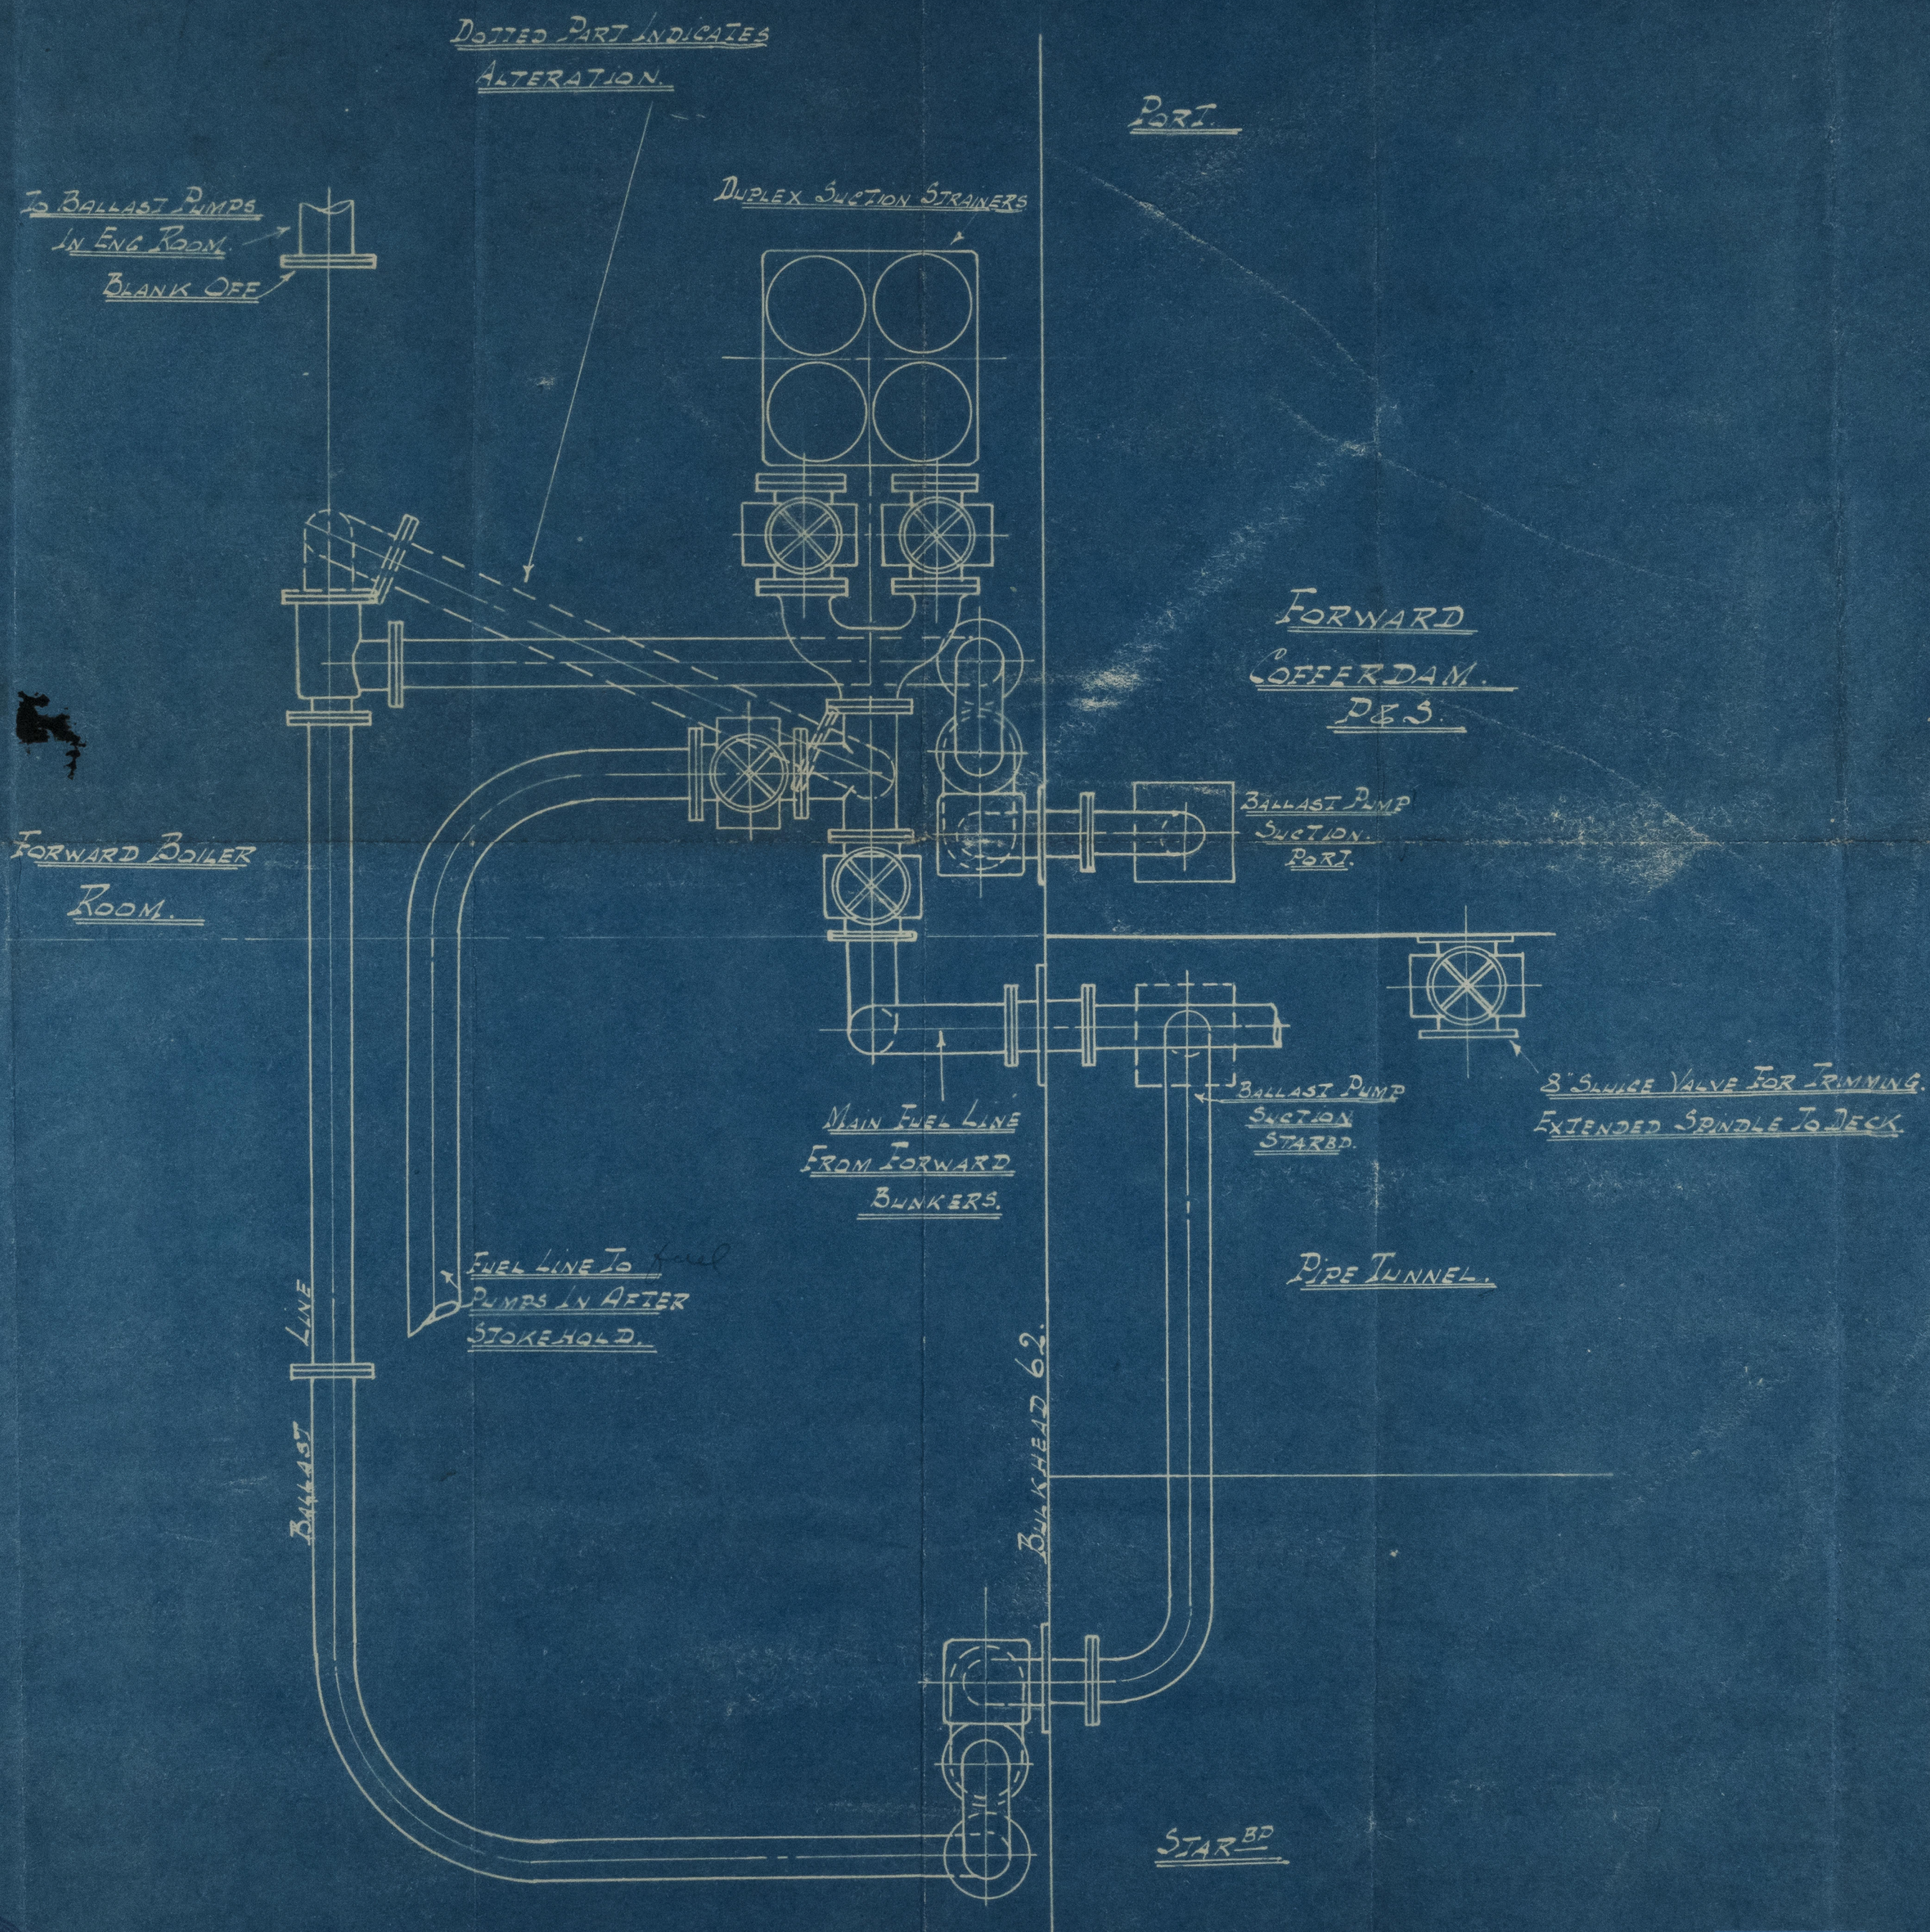

J. S. S. Appleleaf
Indb Report #10078.

© 2021

Lloyd's Register
Foundation

006140-006147-0066