

SEP -6 1937


## Lloyd's Register of Shipping.

Ship's Name "APPLELEAF"

Official No. 140251

Memorandum of alterations reported since ship was surveyed for assignment of Load Lines in Chatham

- (1) New partial bulkheads, plating .30", stiffeners 3"x 3"x .30" angles, spaced 30", now fitted, enclosing openings in forecastle bulkhead as shown in sketch below, Forecastle bulkhead now has "No openings" and the Load Line Certificate has been changed accordingly.
- (2) Two steel companions 4'-6" x 3'-4" x 6'-6" high, plating .30" suitably stiffened, fitted on forecastle deck leading to crew's quarters. Watertight doors of steel, strongly constructed, can be operated from both sides, sill 12".

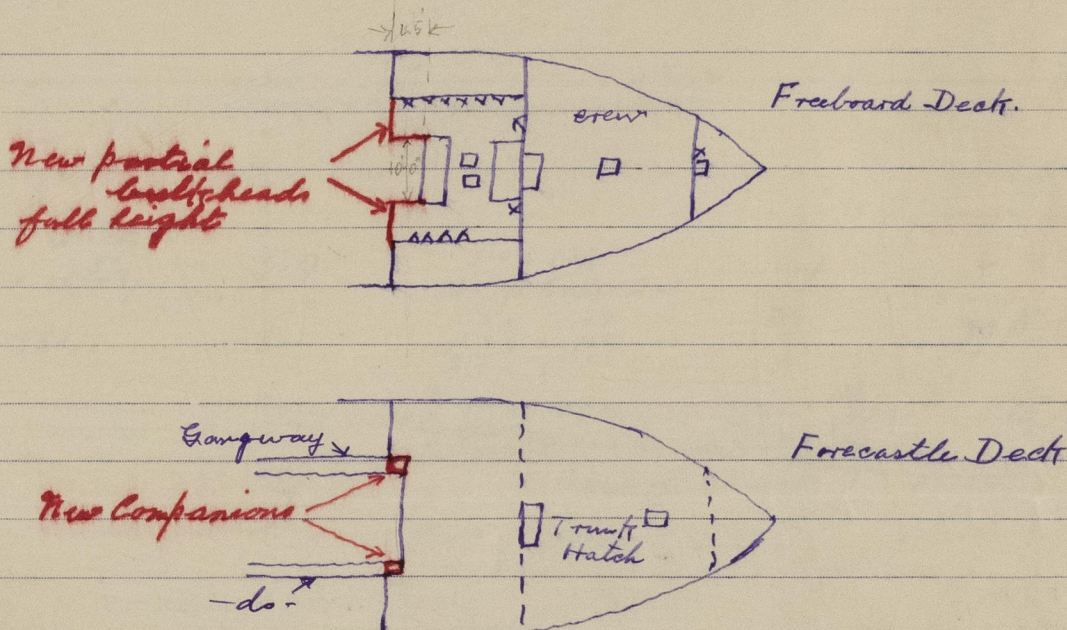

*Noted*  
*655*  
*3/2/38*

*J. S. Morrison*  
H'Kong, 28th. July 1937.