

7.1.15

- NOS. 180-1.-

- MIDSHIP SECTION -

- DIMENSIONS. 117'-0" BP. x 22'-0" EX. x 13'-0" MLD. -

- TO CLASS 100 A1. STEAM TRAWLER. -

- NUMERALS -

BREADTH 21-83

DEPTH 13-00

34-83 TRAN. N^o

LENGTH 117

4075-11 LONG. N^o

- SCALE 1/2" = 1 FOOT. -

- EQUIPMENT -

1 BOWER 6 1/2 CWT. STOCKLESS


1 " 6 " "

1 KEDGE 2 1/2 " EX. STOCK.

90 FATHOMS 1" STUD LINK CHAIN.

60 " 6" HAWSER

60 " 4 1/2" WARP

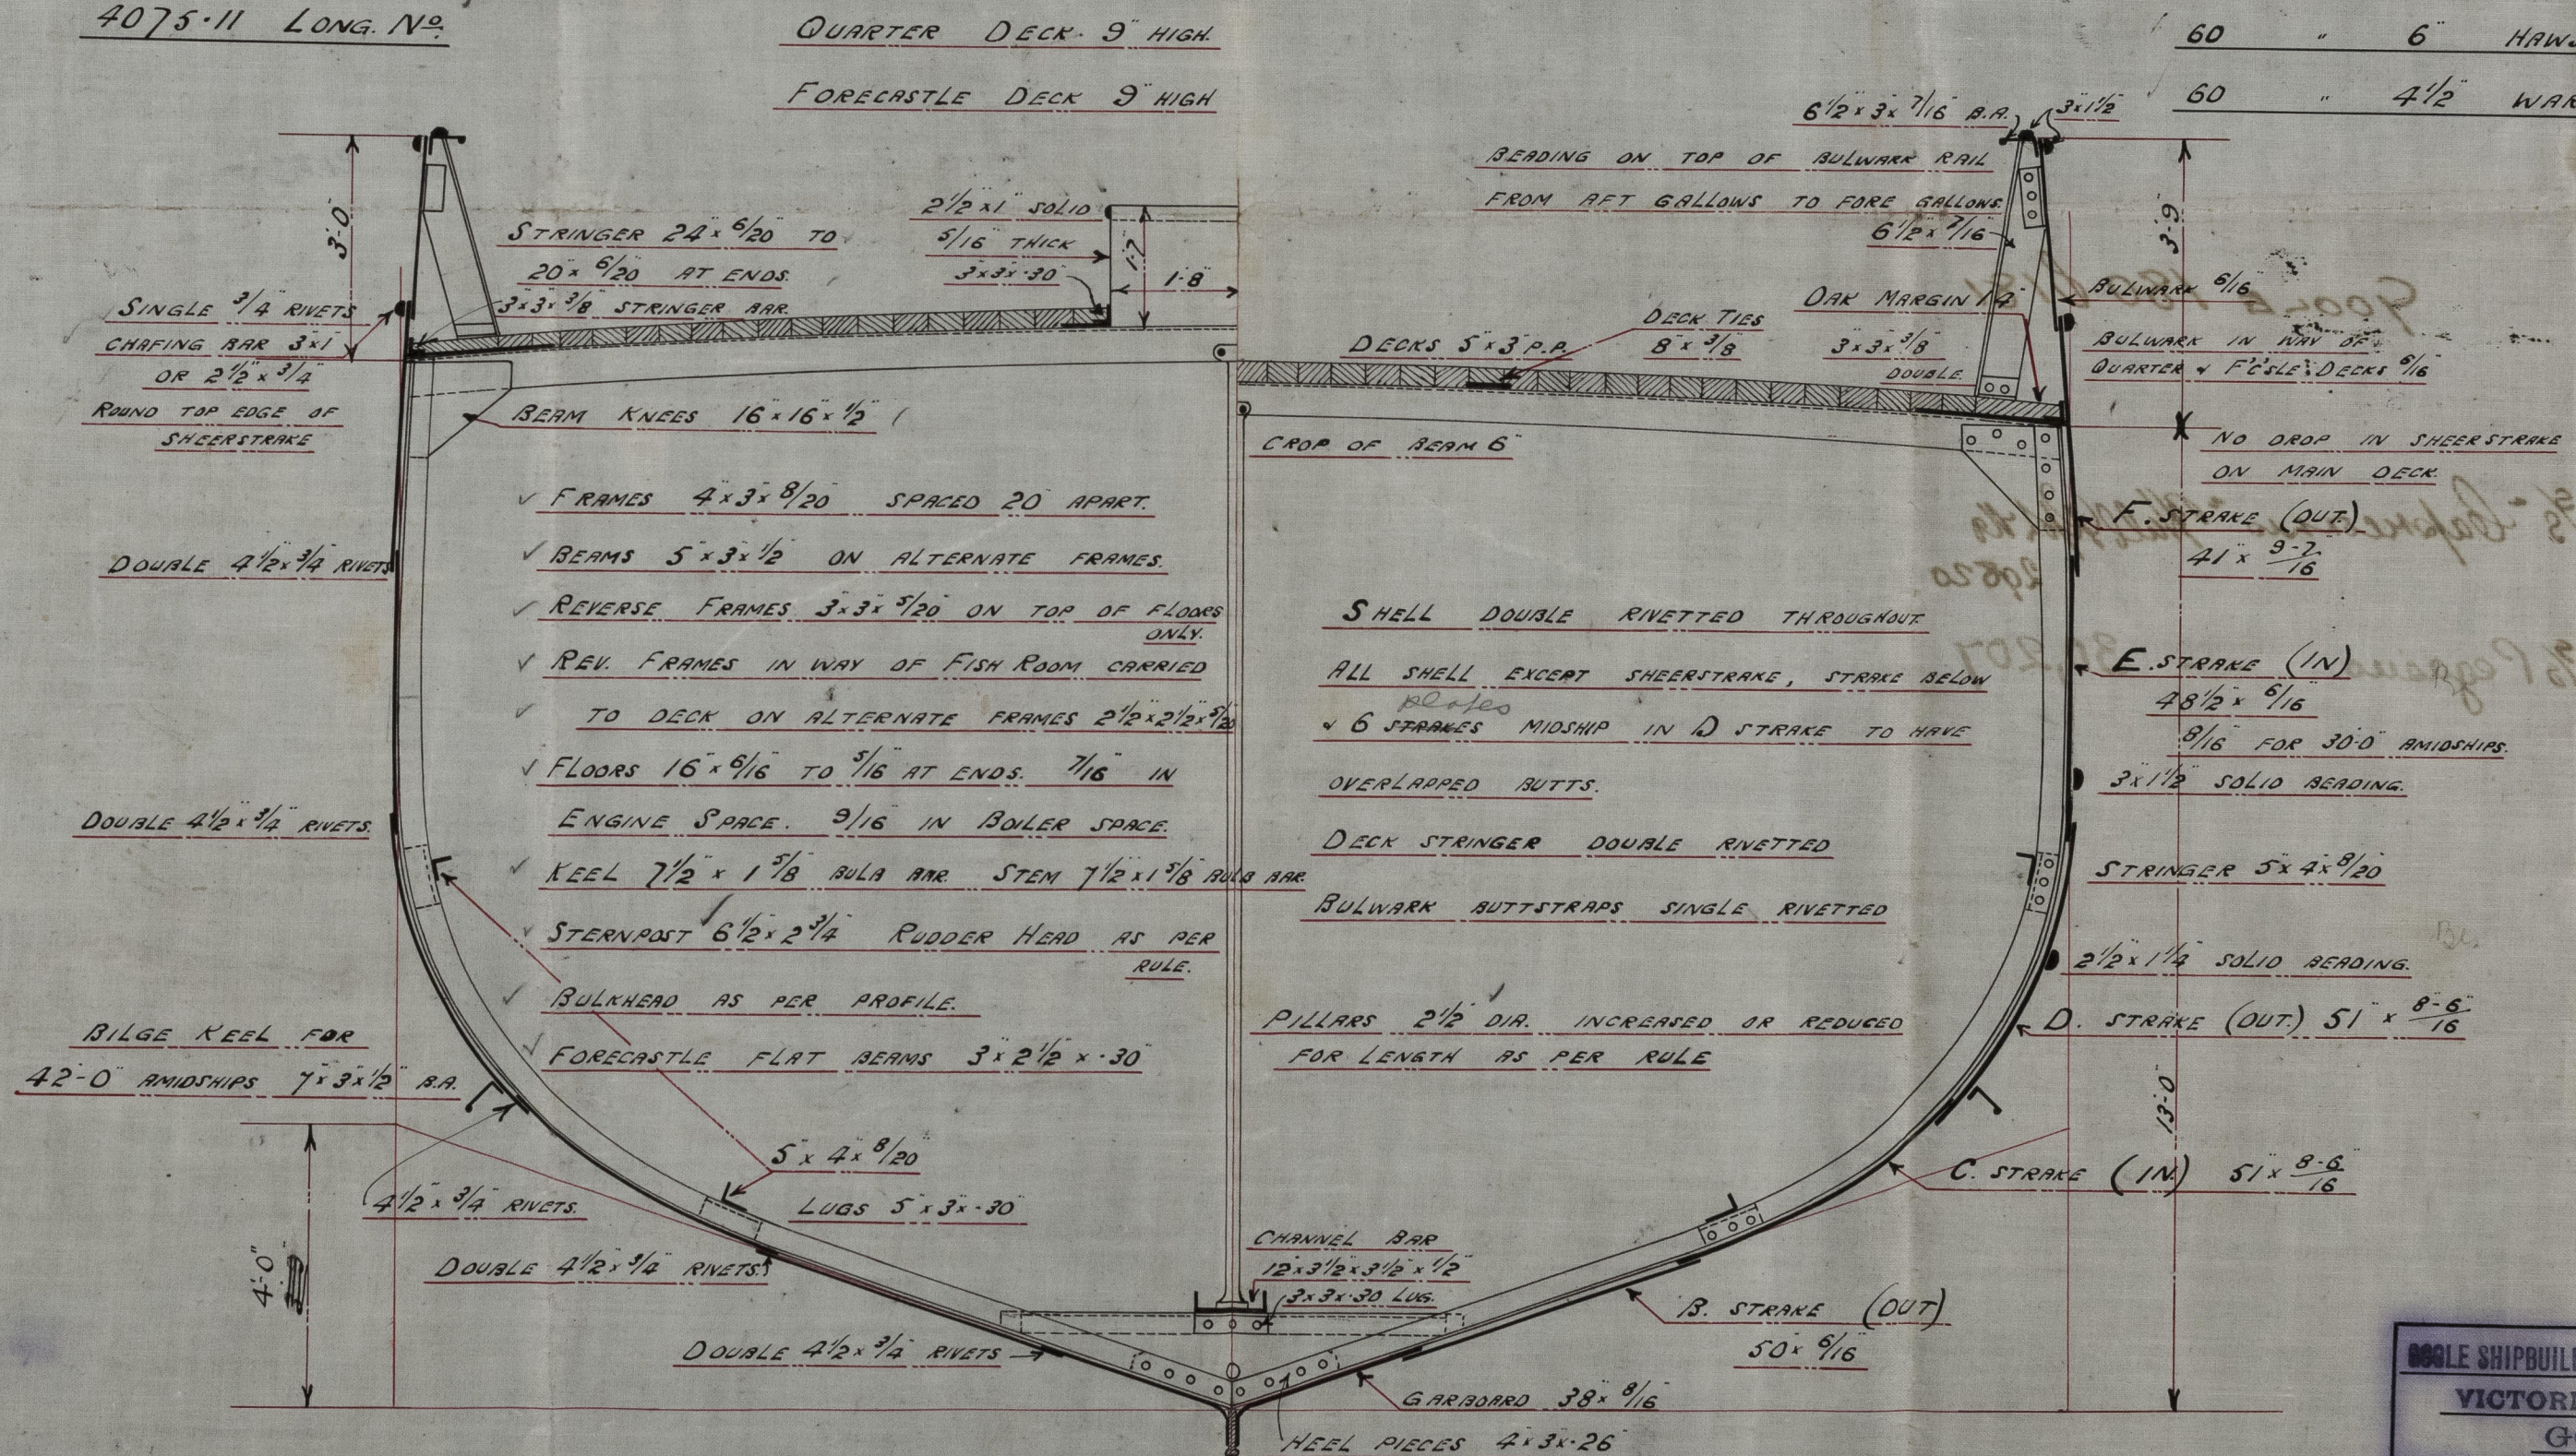

GOOLE SHIPBUILDING & REPAIRING Co. Ltd.
VICTORIA SHIPYARD,
GOOLE.

Drawing No. 614

Made by S.H. Checked by H.W.


Date 4-1-15

GOOLE 180 0181

29820

5/3 Pegasus - - 30,207

GOOLE SHIPBUILDING & REPAIRING CO. LTD.	
VICTORIA SHIPYARD.	
GOOLE.	
Drawing No.	614
Made by	Checked by
Date	4-1-12

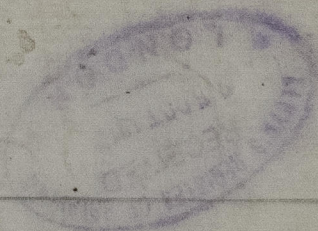

© 2021

Lloyd's Register
Foundation

006140-006147-0113