
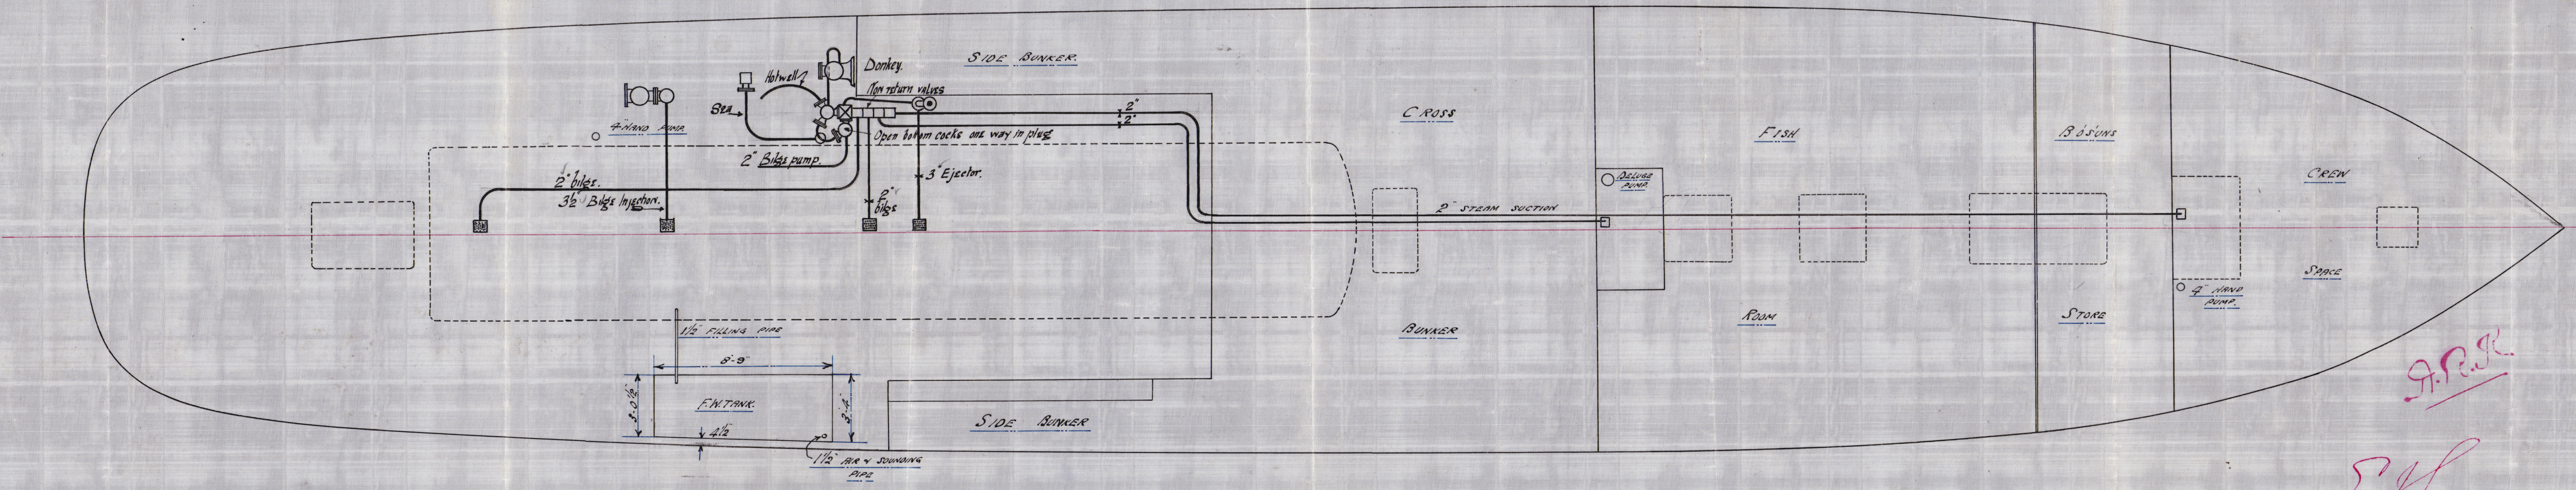


- N<sup>o</sup>. 180-1. -  
 - PUMPING PLAN. -  
 - Scale 1/4" = 1 FOOT -

13/10/15

GOOLE SHIPBUILDING & REPAIRING Co. Ltd.  
 VICTORIA SHIPYARD,  
 GOOLE.  
 Drawing No. 921  
 Made by J.H. Checked by HOD  
 Date Sept 24/15

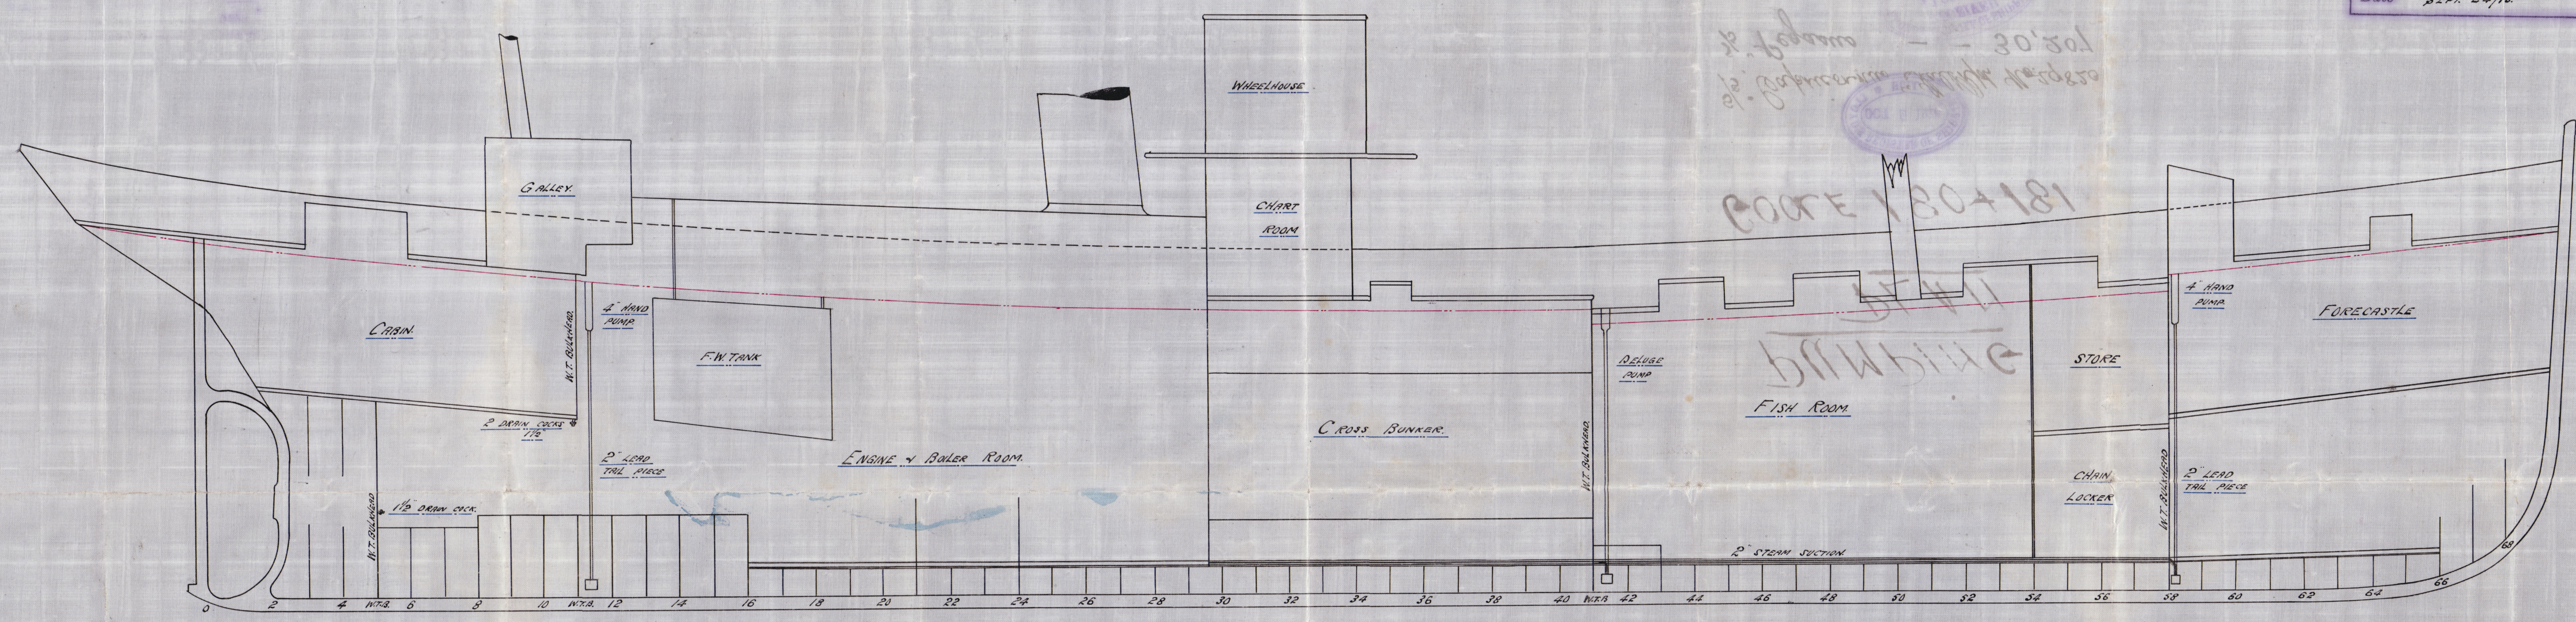


*J.P.R.*  
*S.P.*  
 11.10.15



PUMPING  
PLAN

GOOLE 180+181

$\frac{5}{8}$ " Capricornus Hall Rm No. 29820  
 $\frac{5}{8}$ " Pegasus - - 30,207

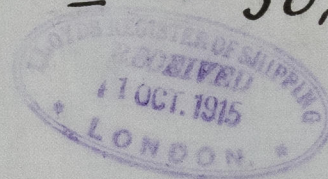

19/12/12



© 2021

Lloyd's Register  
Foundation