
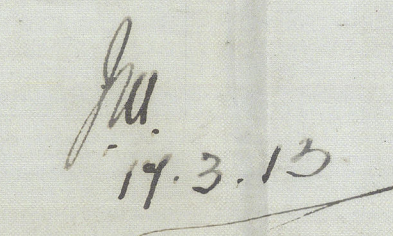


Caroline & John
 No 521, 522, 523, 524
 Caroline & John

FILE NO. 2644
 ENCLOSURE TO
 Messrs Lloyds Surveyors
 Hull FROM
 LLOYD & SONS, LTD.
 CHIMBULDER, SELBY
 DATE 12/3/13

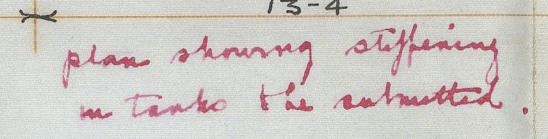

Cochran & Sons. Ltd
Nos 561, 562, 567, 568.



Profile & Decks

• Bradington Hull Rpt No: 26774

• Spector " " " 26818

• Penbland " " " 27395

• Darnwell " " " 27436

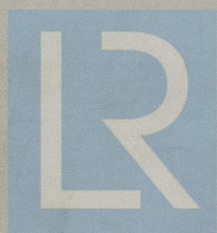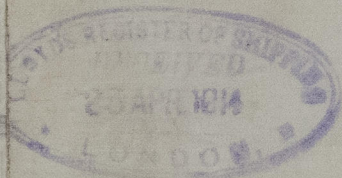

© 2021

Lloyd's Register
Foundation

006148-006159-0097