

18.3.13.
12.4.13.

MIDSHIP SECTION


STEEL SCREW FLEETERS

N^o 561-2-587-8

DIM^s 112'-0" B.P. * 22'-6" M.L.O. * 13'-2" M.L.O.

SCALE 1/2" INCH

TO CLASS 100A1 FOR FISHING PURPOSES. DECK PLATED OVER
IN WAY OF MACHINERY SPACE. ENGINE & BOILER CASING AS
PREVIOUSLY APPROVED

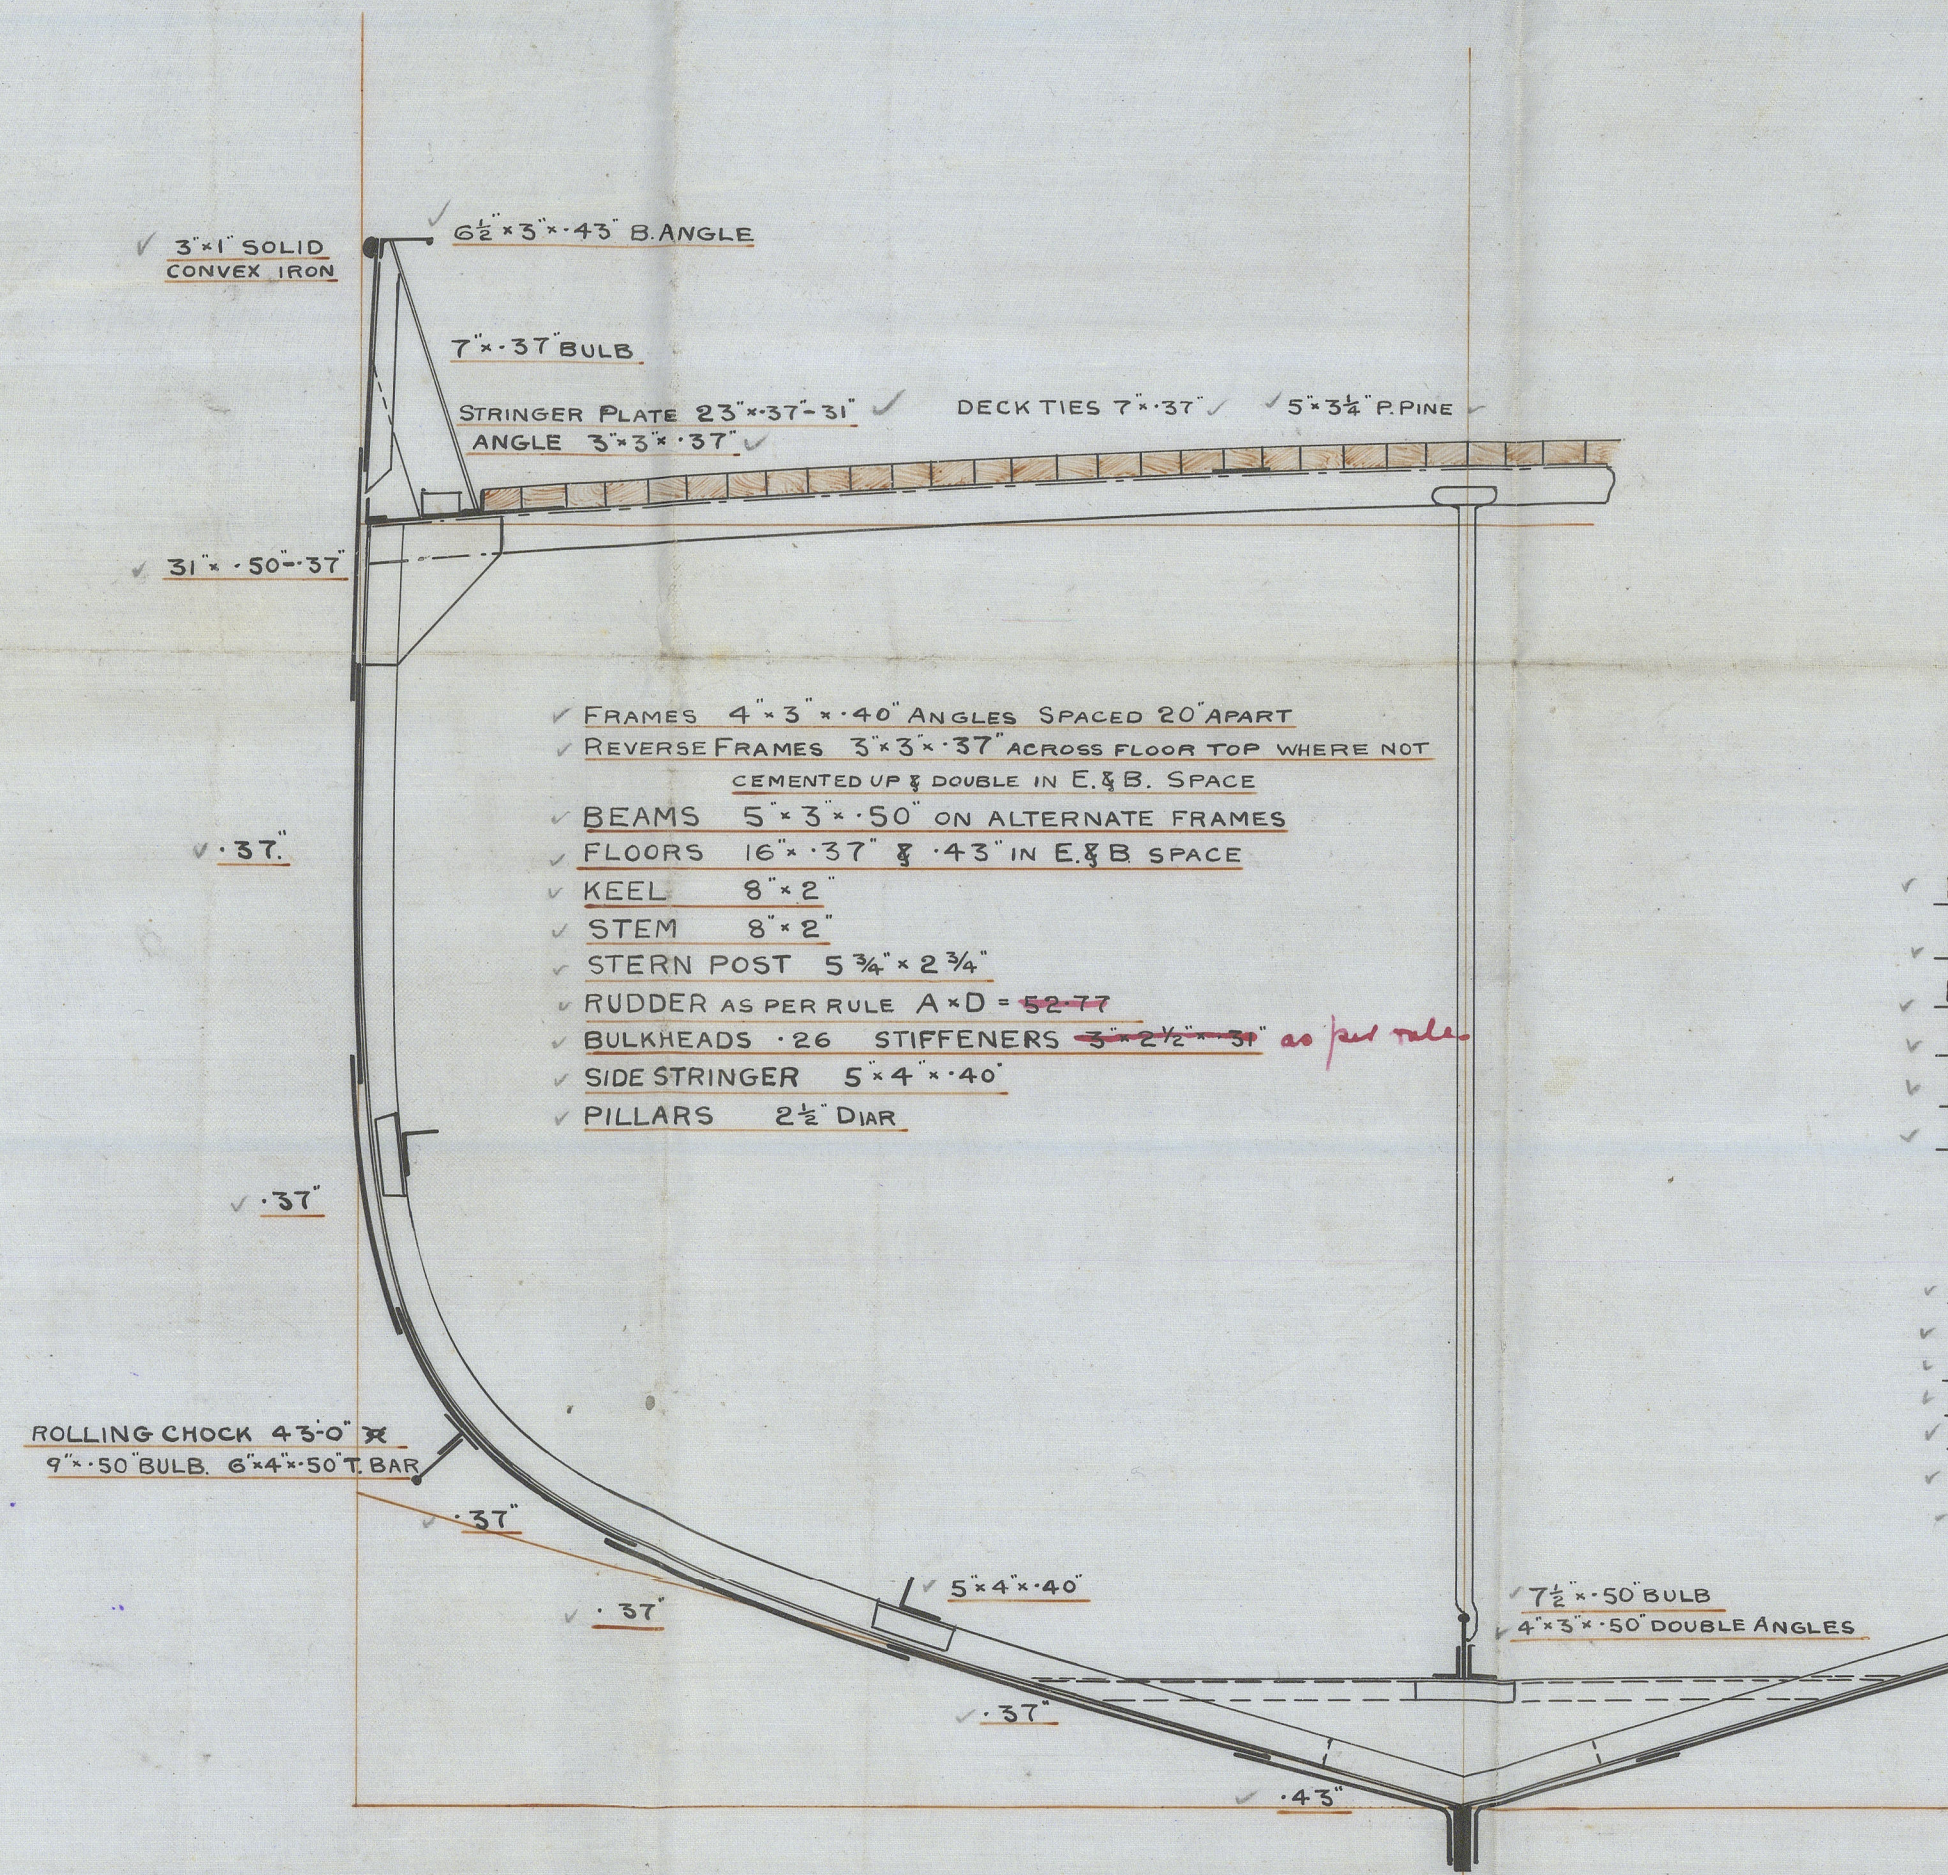

NUMERALS

B+D-----35.53
L x (B+D)-----3979.36

PROPORTIONS

L/D-----8.51
L/B-----5.006

EQUIPMENT

✓ 1ST BOWER ANCHOR 5 CWTs EX STOCK

✓ 2ND " " 4 1/2 " " "

✓ KEDGE " 2 1/2 " " "

✓ 90 FATHOMS 1" CHAIN

✓ 60 " 5 1/2" HAWSER

✓ 60 " 4" WARP

RIVETING

✓ BUTTS OF SHELL PLATING TO BE LAPPED & DOUBLE

✓ RIVETED EXCEPT GARBOARD & SHEERSTRAKE WHICH ARE TO BE STRAPPED & DOUBLE RIVETED

✓ ALL SINGLE RIVETED LANDINGS EXCEPT LOWER

✓ EDGE OF SHEERSTRAKE & TOP EDGE OF GARBOARD WHICH ARE DOUBLE RIVETED

✓ BULWARKS SINGLE RIVETED


17.3.13.

Cochrane & Sons Ltd

Nº 561. 562. 587. 588.

Midship Section

* Bridlington Hull Rpt No: 26444
* Spector ⁵⁶¹ " " " 26818
* Penblans ⁵⁶² - - - 27395
* Dammitt ⁵⁸⁷ " " " 27436
 ⁵⁸⁸

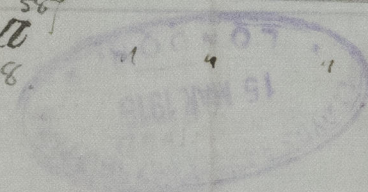

8402

18-8-51 10/10/51 12/8/51



© 2021

Lloyd's Register
Foundation

006148-006159-0098