

and 1 moulton
 .500 + .500
 moulton moulton

MIDSHIP SECTION

S.S. NOS 366-7

STEEL SCREW TRAWLERS

TO BE CLASSED 100 A.1 AT LLOYDS

DIMENSIONS 125' 0" x 22' 0" x 13' 3 1/2" 12' 6" HOLD

SCALE 1/2" = 1 FOOT

E & B CASING AS PREVIOUSLY APPROVED

DECK PLATED OVER AT SIDES OF CASING

NUMERALS AS PER RULES

1/2 BREADTH	10 95
1/2 GIRTH	20 33
DEPTH	13 70
	44 38 1/2"

LENGTH AS PER RULES 125' 0"
 5571 6726 1"

PROPORTIONS

DEPTH TO LENGTH	9 04 ✓
BREADTH TO LENGTH	5 16 ✓


EQUIPMENT

1 ST BOWER ANCHOR	5 1/2 CMTS EX STOCK
2 ND " "	5 " " "
3 RD " "	2 3/4 " " "
105 FATHS	1 1/2" SHORT LINK CABLE
60 "	6" HAWSER
60 "	4" WARP

COCHRANE & SONS

SHIPBUILDERS

SELBY

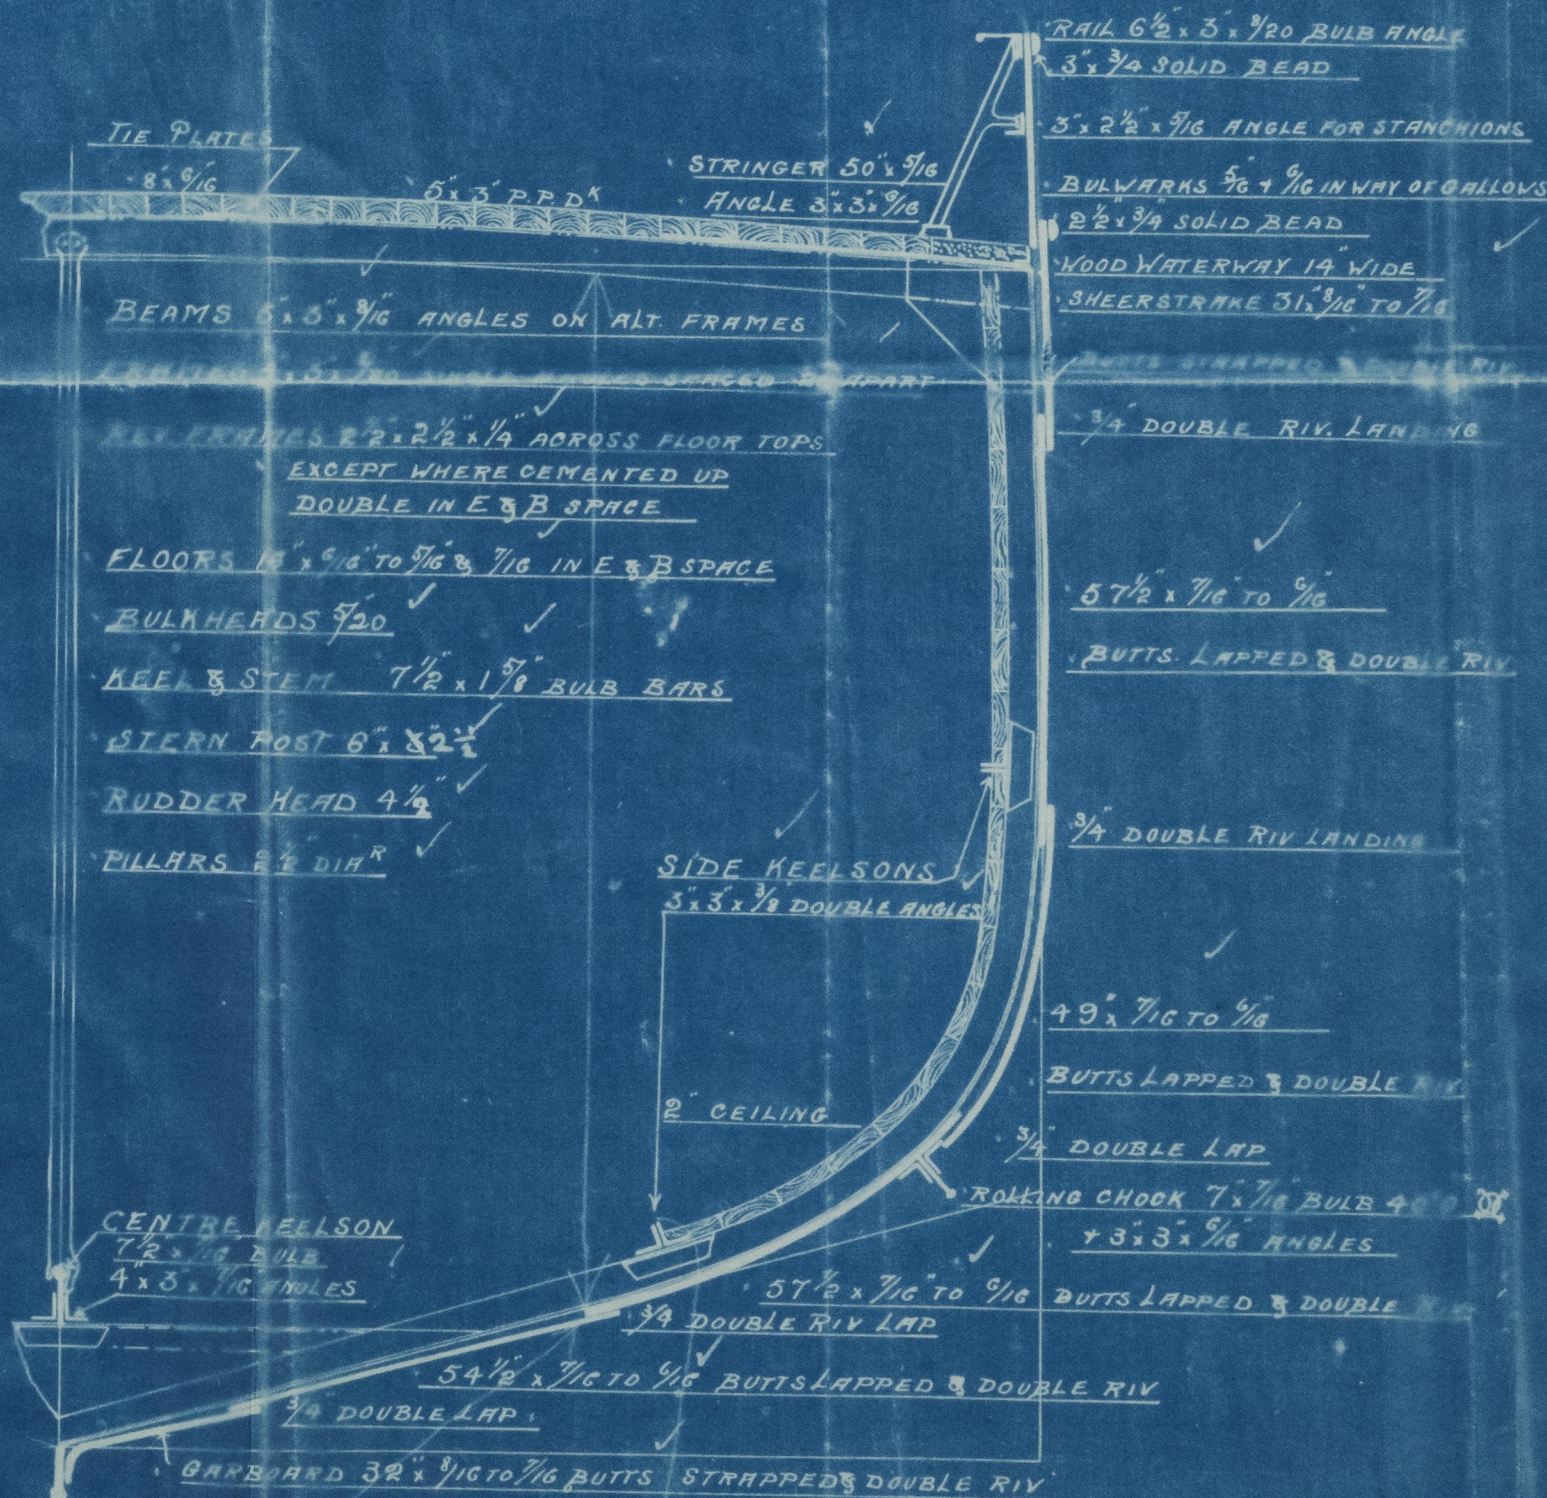

Line attached taught over top of this keelson and the amount of curve on the bottom noted before launching and verified

B.C. Landing point when measurements from beam to shell were taken after the launch.



Lloyd's Register Foundation

Cochrane & Sons

No. 366 & 367

1 Duplicate
Midships Section

s/s "Ormonde"

Hull Report No 18435



© 2021

Lloyd's Register
Foundation

006148-006154-0108