

18.3.13
12.4.13

MIDSHIP SECTION


STEEL SCREW FLEETERS

N^o 588

DIMS 112'-0" B.P. * 22'-6" MLO * 13'-2" MLO

SCALE 1/2 INCH

TO CLASS 100A1 FOR FISHING PURPOSES. DECK PLATED OVER
IN WAY OF MACHINERY SPACE. ENGINE & BOILER CASING AS
PREVIOUSLY APPROVED

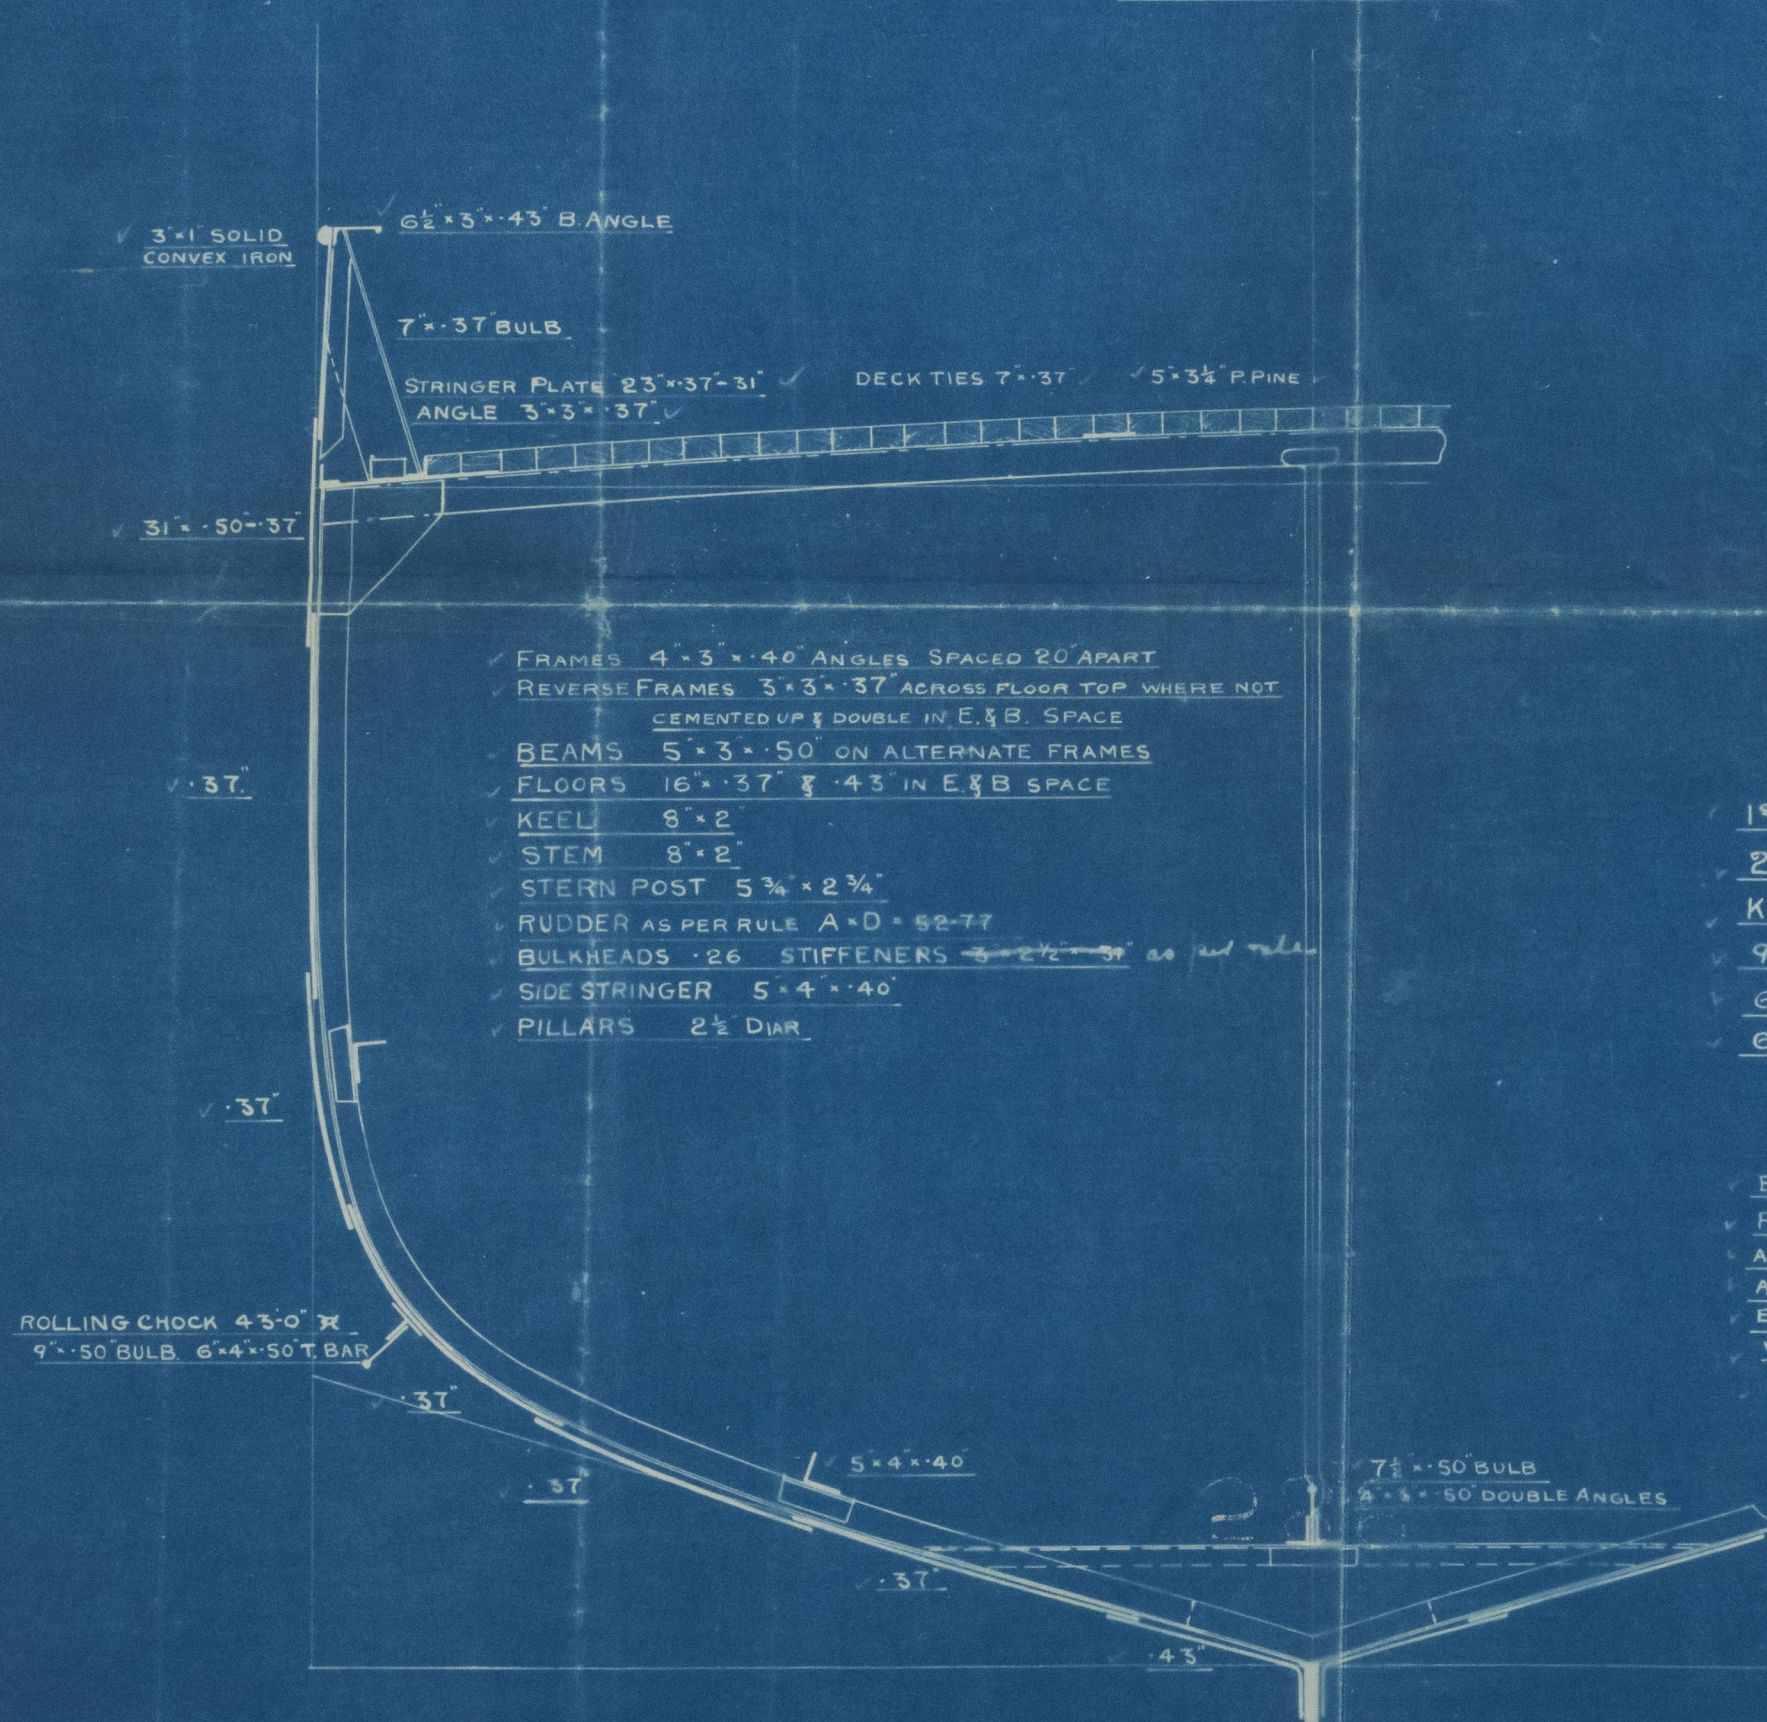

NUMERALS

B+D-----35.53

L x (B+D)-----3979.36

PROPORTIONS

B-----31

B-----5.006

EQUIPMENT

1ST BOWER ANCHOR 5 CWTs EX STOCK

2ND 4

KEDGE 2 1/2

90 FATHOMS 1" CHAIN

60 5 1/2" HAWSER

60 4" WARP

RIVETING

BUTTS OF SHELL PLATING TO BE LAPPED & DOUBLE

RIVETED EXCEPT GARBOARD & SHEERSTRAKE WHICH

ARE TO BE STRAPPED & DOUBLE RIVETED

ALL SINGLE RIVETED LANDINGS EXCEPT LOWER

EDGE OF SHEERSTRAKE & TOP EDGE OF GARBOARD

WHICH ARE DOUBLE RIVETED

BULWARKS SINGLE RIVETED

17.3.13



Lloyd's Register
Foundation

006148-006159-0230

Cochran & Sons, Ltd.

N^o ~~561. 562. 564.~~ 588.

Duplicate
Midship Section.

s/s "Dunnet"

Hull Rpt No. 27436

