


AFTER END OF PLATE TO GO TO HERE

INSET WITH WHITE LEAD

ELECT WELD

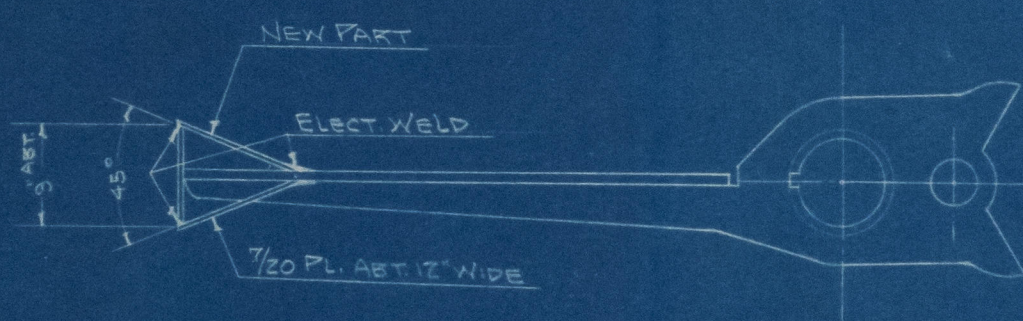


THE ELECTRIC WELDING MUST BE DONE WITH AN
APPROVED ELECTRODE, AND THE REQUIREMENTS
OF THE SOCIETY'S RULES FOR THE APPLICATION
OF ELECTRIC ARC WELDING FOR SHIP
CONSTRUCTION MUST BE CARRIED OUT.



"MONTEVIDEO"
BAL. REPORT No. 6808

The electric welding must be done with an
approved electrode, and the requirements of the
Society's RULES FOR THE APPLICATION
OF ELECTRIC ARC WELDING FOR SHIP
CONSTRUCTION must be carried out.

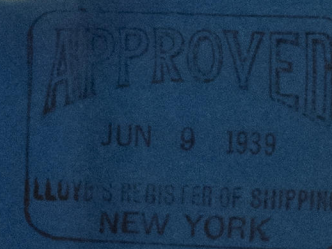

FRAMNAES MEKANISKE VERKSTED

SCALE 3/4"=1'-0" FEB 5, 1933

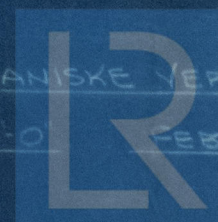

006175-006188-0171

M.S. MONTEVIDEO

Bal. Report No. 6808

Rudder Plan



© 2021

Lloyd's Register
Foundation

006175-006188-0171