


BURMEISTER
& WAIN,
COPENHAGEN,

NEW BUILDING
No. 547.

M/S. "SUD PACIFICO."

Cm. Rep. 7769.
u. n. "Montevideo".

LONGITUDINAL SECTION.
(as ship built).

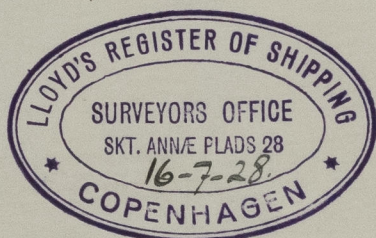


SISTER VESSELS:

1) BURM. & WAIN No. 543,
M/S. "SUD ATLANTICO"

Copenhagen Report: 7690.
29-4-1928.

2) BURM. & WAIN No. 550.
(Building).

006175-006188-0173

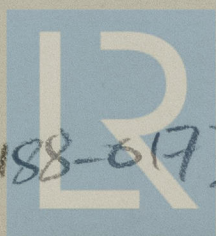

© 1921

Lloyd's Register
Foundation