

1.3.12

"S.S. Venban No 82."

Stern-Post & Rudder.


1/10

Material for stern-post = cast-steel, or wrought-iron.


" " for rudder = wrought-iron.

Speed under 10 knots.


1. Arm with Stopps.

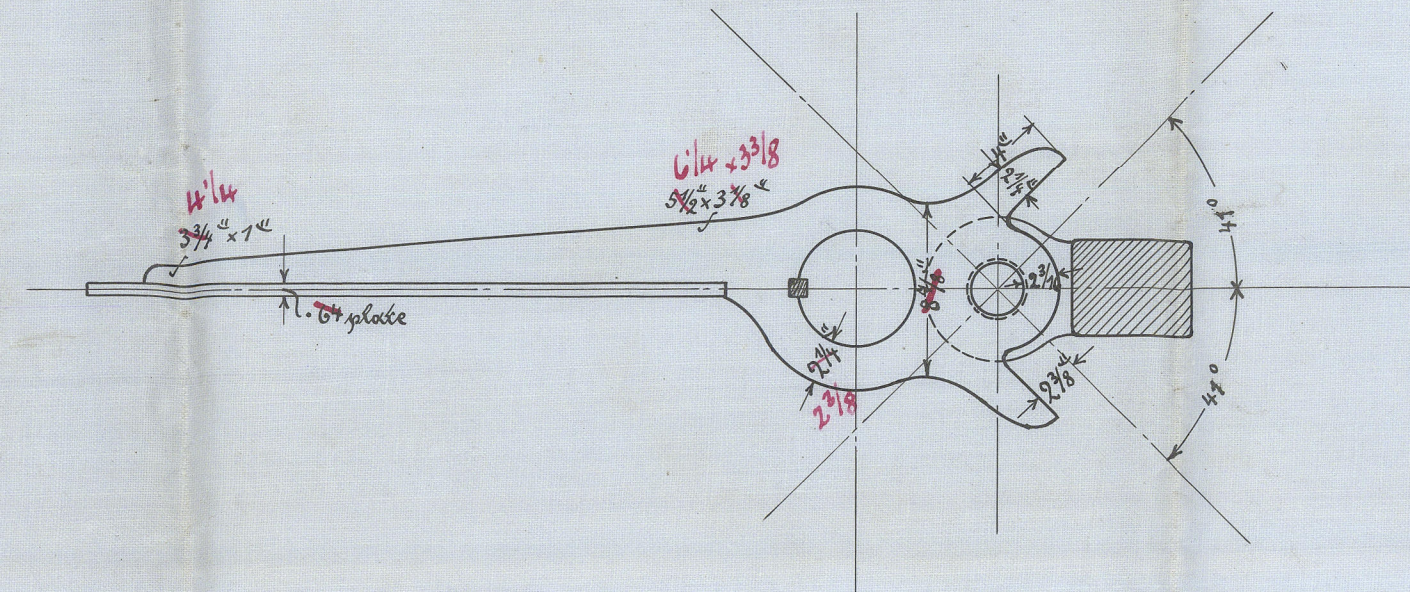

Sight of the Boss.

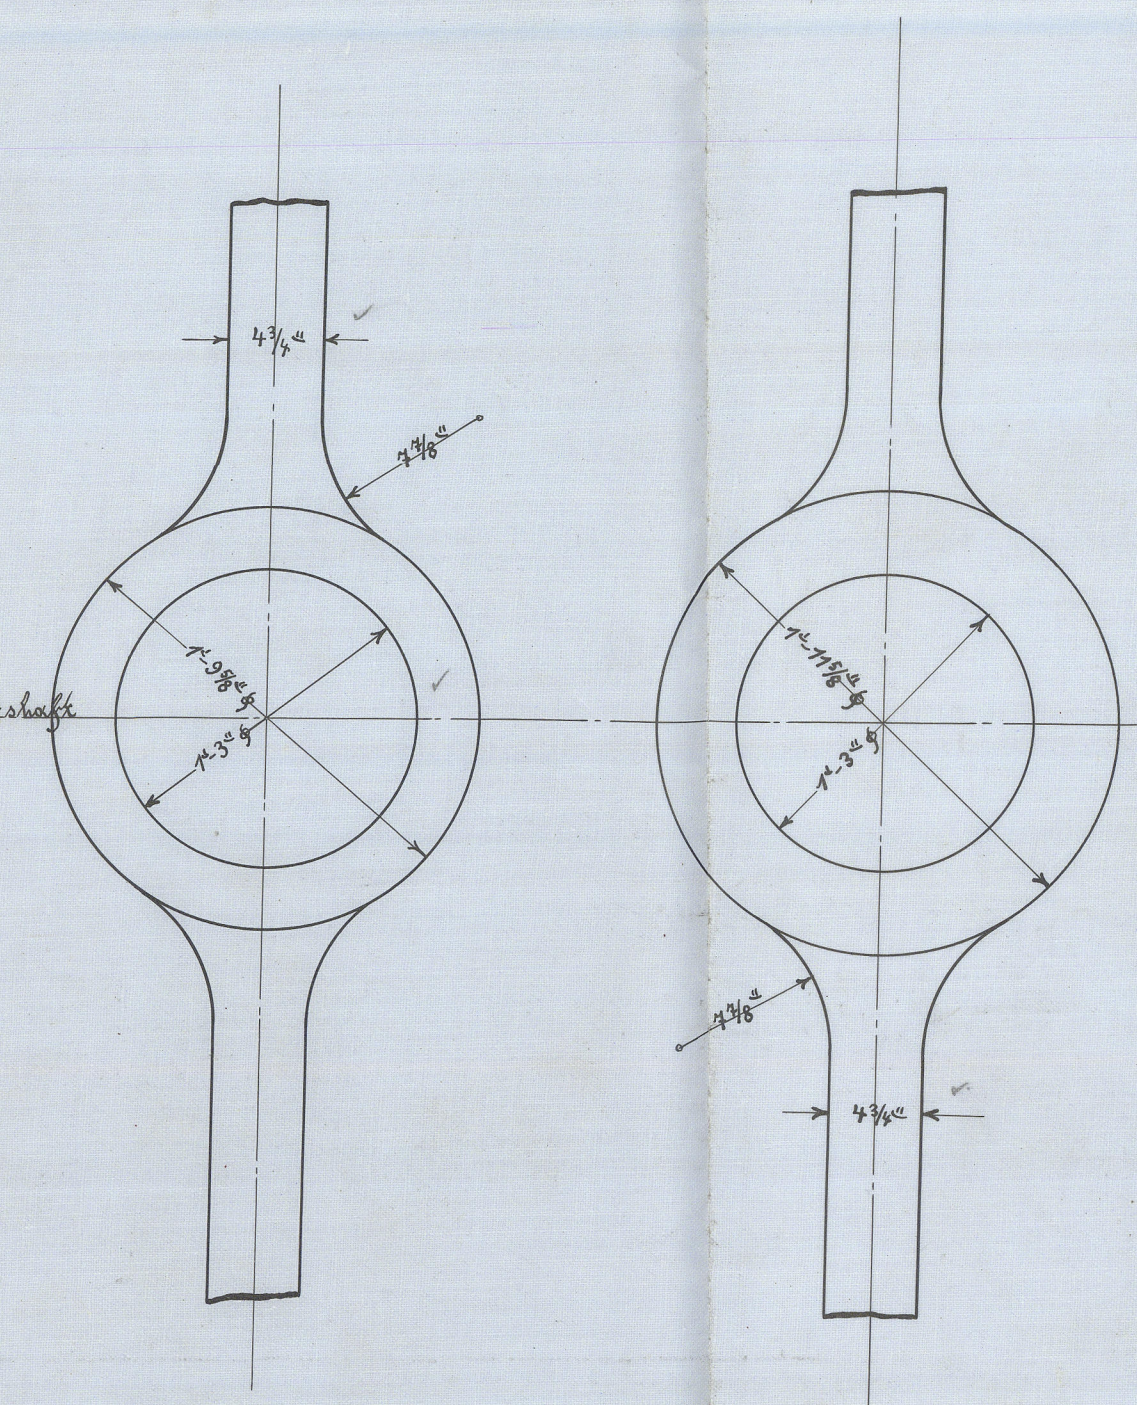

1. Arm.

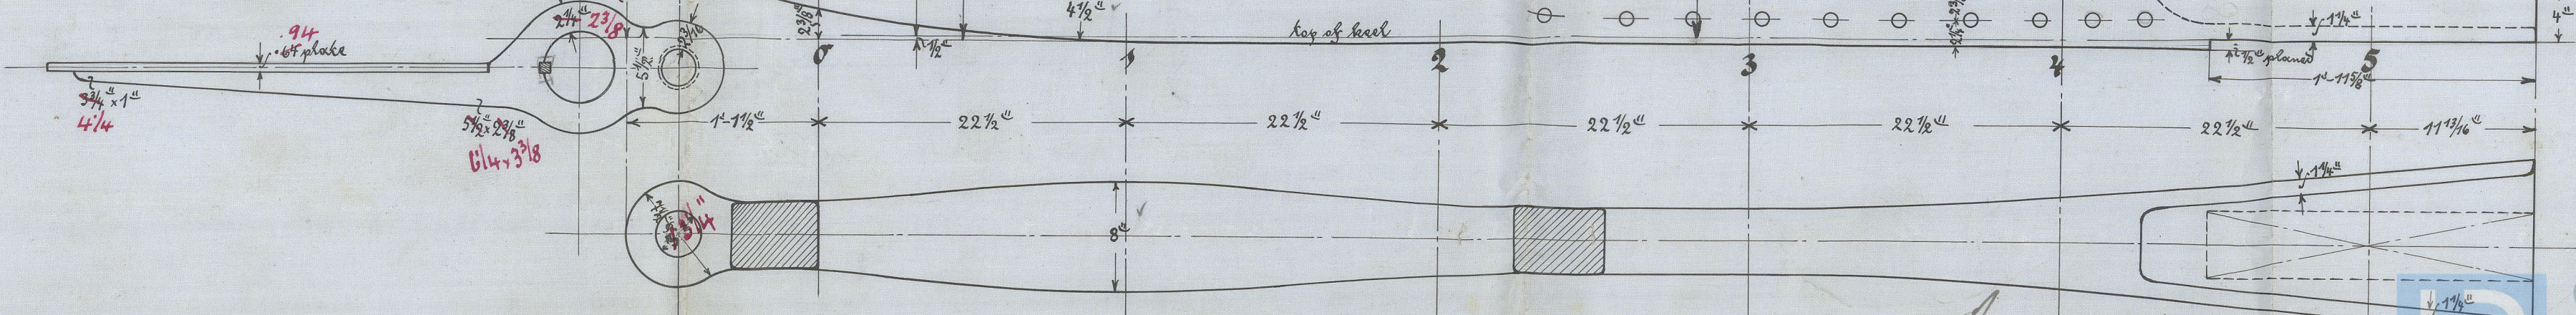


006189-006203-0098








Lloyd's Register
Foundation