
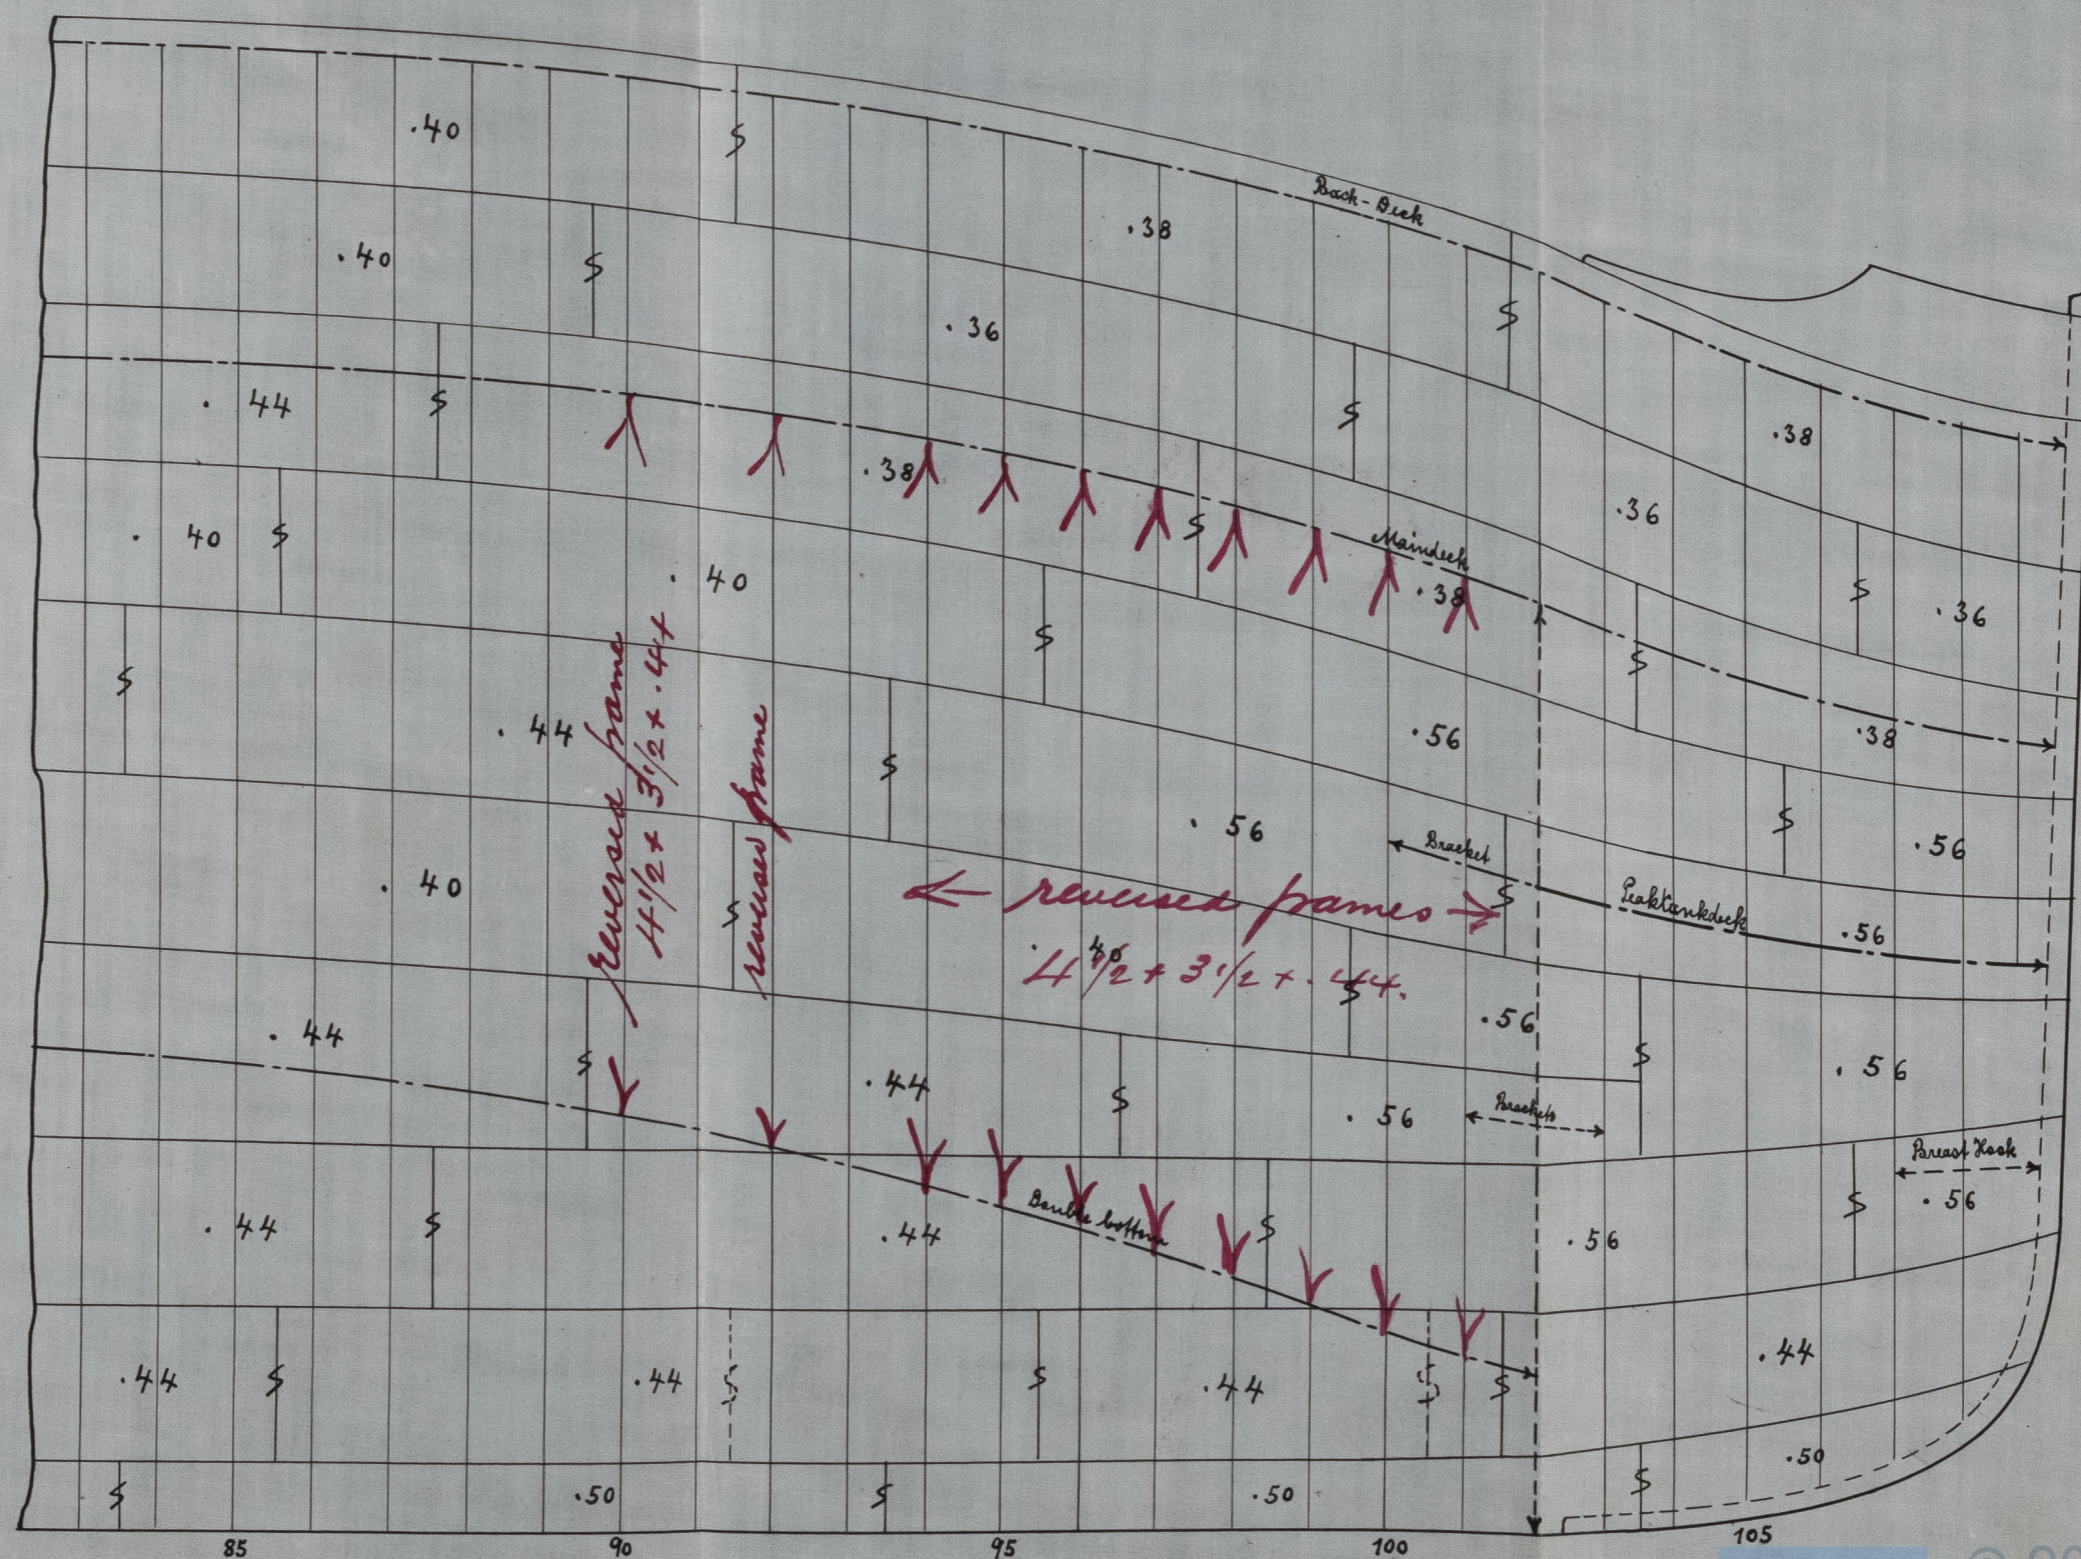


instead of Panking Skinger. No. 22.

1:50.

Schiffbau-Gesellschaft
Unterweser
m. b. H.
Lehe-Bremerhaven.

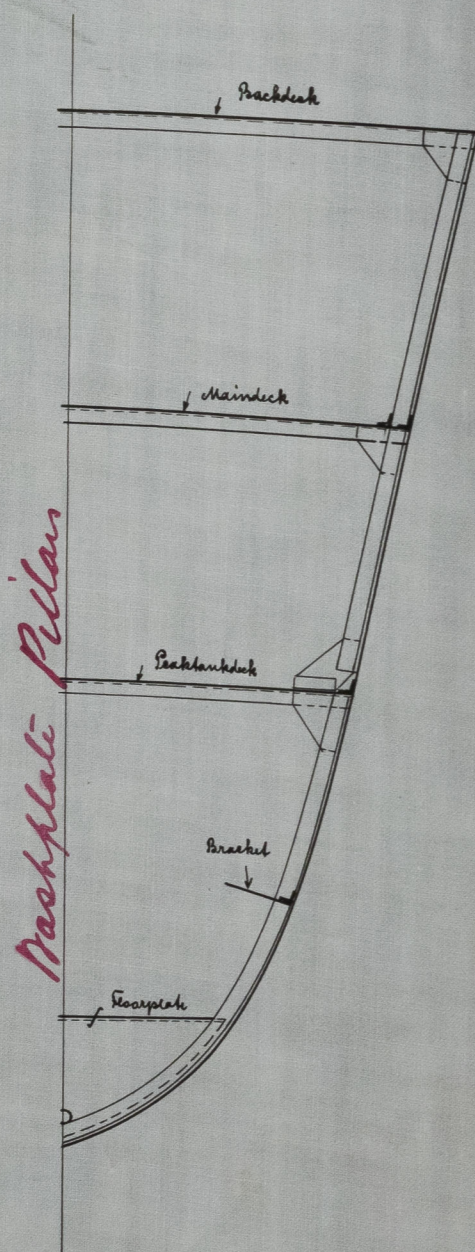

C.B.
15.3.12

© 2021
Lloyd's Register
Foundation
Accounting # 287.

006189-006203-0099

St. Pisador - Penn. 1849

Lloyd's Register
Foundation