


# LONGITUDINAL SECTION S.S. N<sup>o</sup> 142.

— DIMENSIONS —  
 LENGTH B.P. 355'-0"  
 BREADTH EXT. 50'-0"  
 DEPTH MLD. 26'-4"  
 — SCALE 1/8" = 1 FOOT —

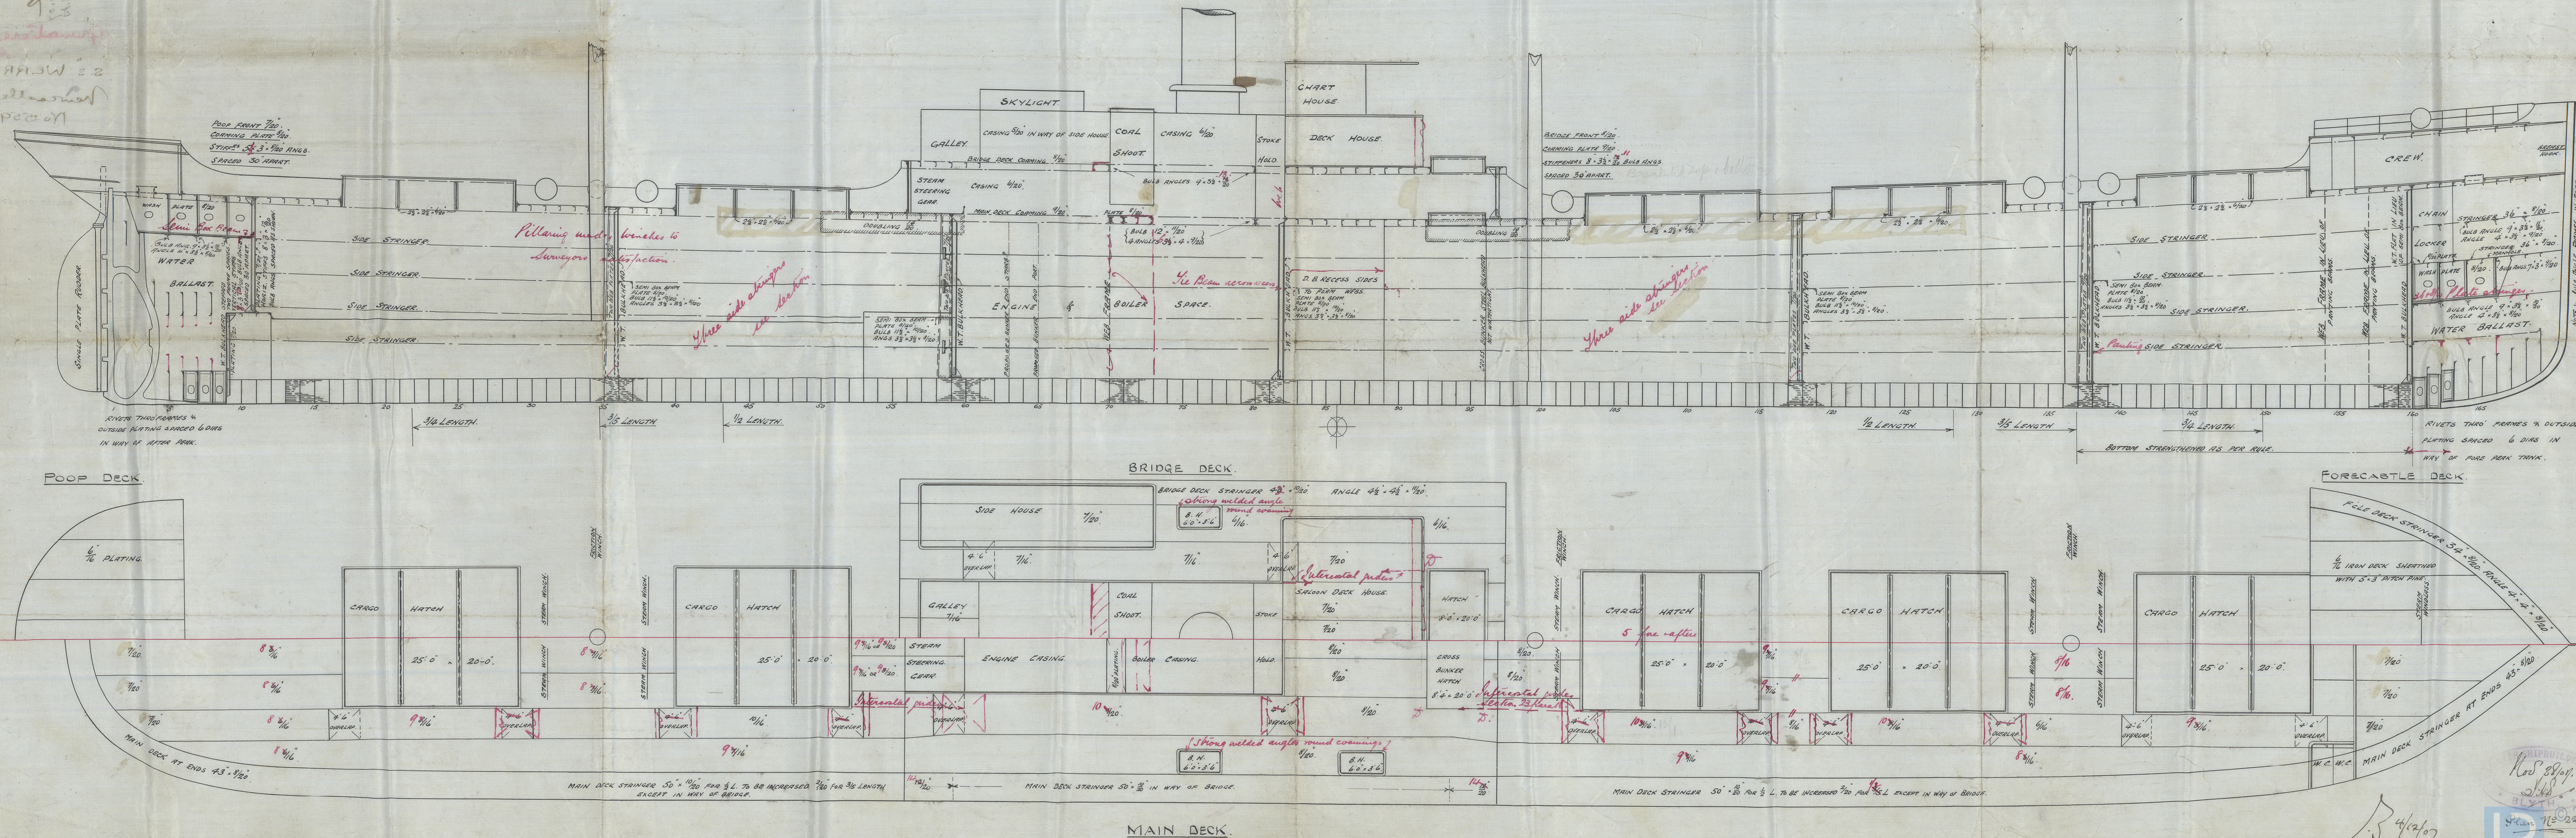

NOTE - ALL WIRE FRAMES IN POOP  
 TRAIL CHAINED TO BOTTOM OF FLOOR.



"GRANATIERE PAGULA"

✓ M/M 6201

Newcastle - on 7 yrs

13th Sept 1907  
S.S. No. 142  
Profile  
30-11-07  
P.A.B.

Granatiere Padula

ex

S.S. WERRIBEE

Newcastle Report

No. 55991

006189-006203-0313

© 2021



Lloyd's Register  
Foundation