
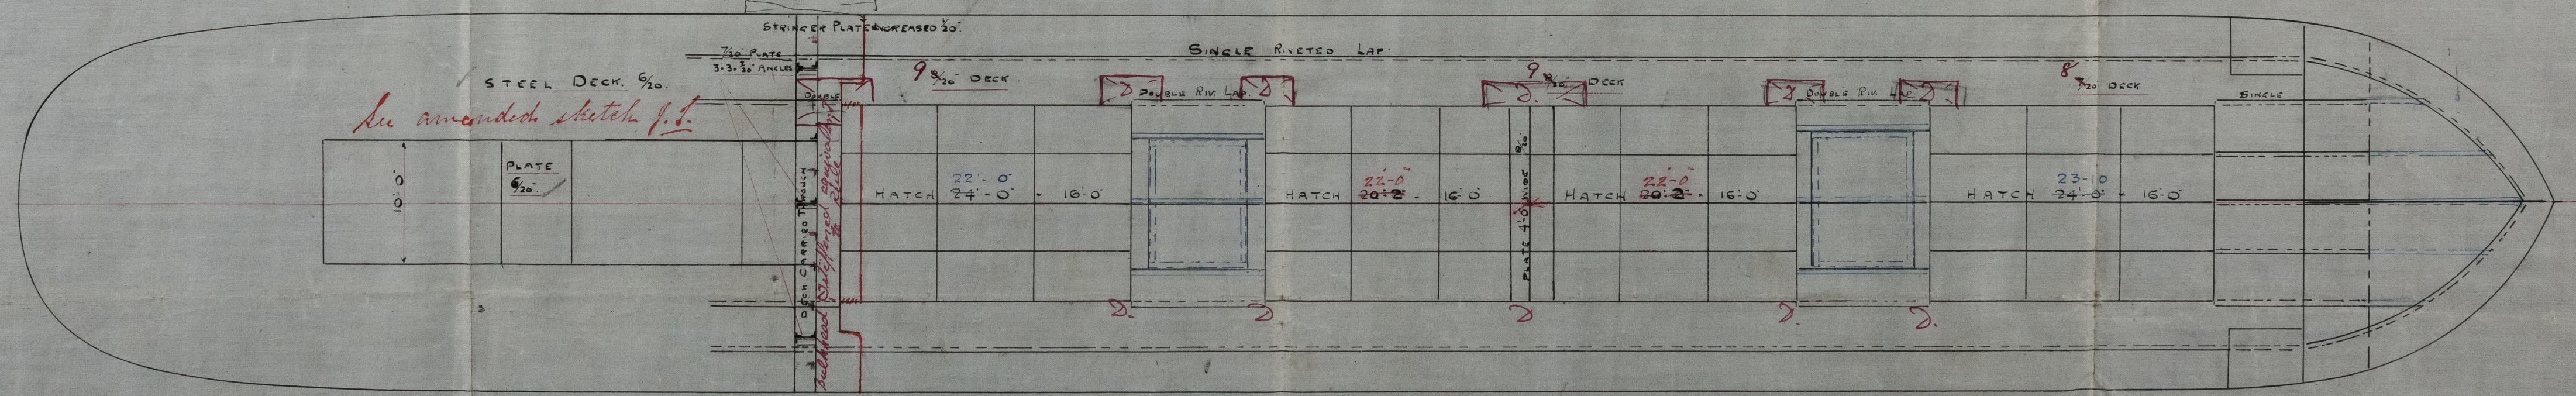


2.12.01
1.5.02



— N^o 47 —
— STEEL SCREW STEAMER —
— 200'-0" - 32'-0" - 14'-8" MLD. —
TO CLASS 100 A1 LLOYDS
SCALE 8" = 1 FOOT.

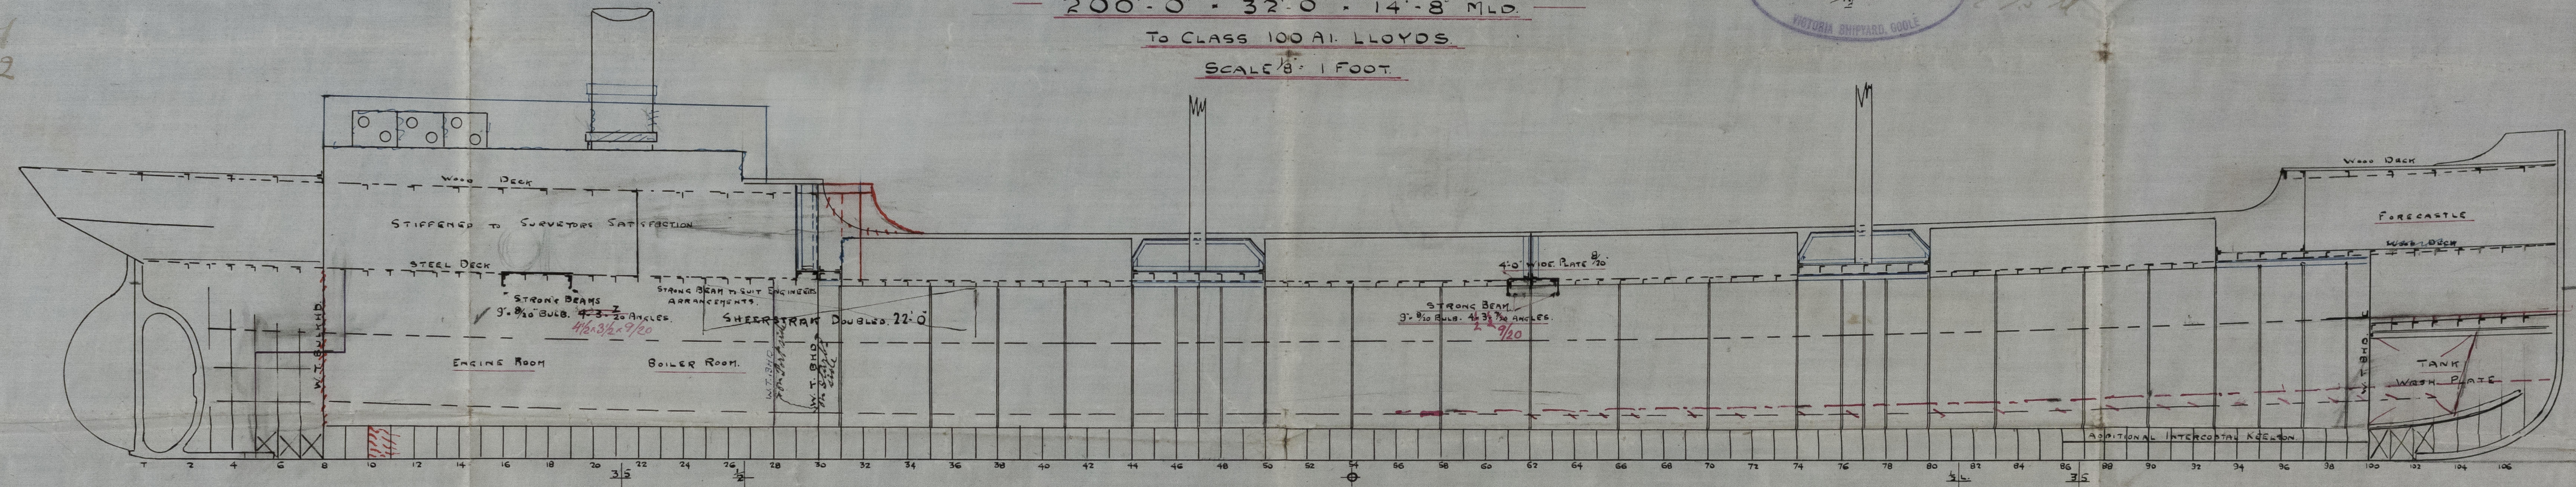

Good ss Rbn. 47

s/s Bea

Stull Report No. ~~14834~~
14820

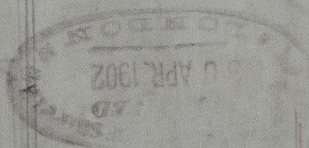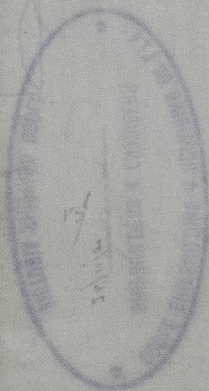

© 2021

Lloyd's Register
Foundation