


— Do Class 100.01. at Lloyd's. —

Equipments:

- Lloyd's Numbers —

Length of Quarter Deck.  $64' 6" \times 12"$  ✓  
" " " " " "  $21' 8" \times 15"$  ✓

Depth to Length	9.29 ✓
Breadth to Length	5.5 ✓

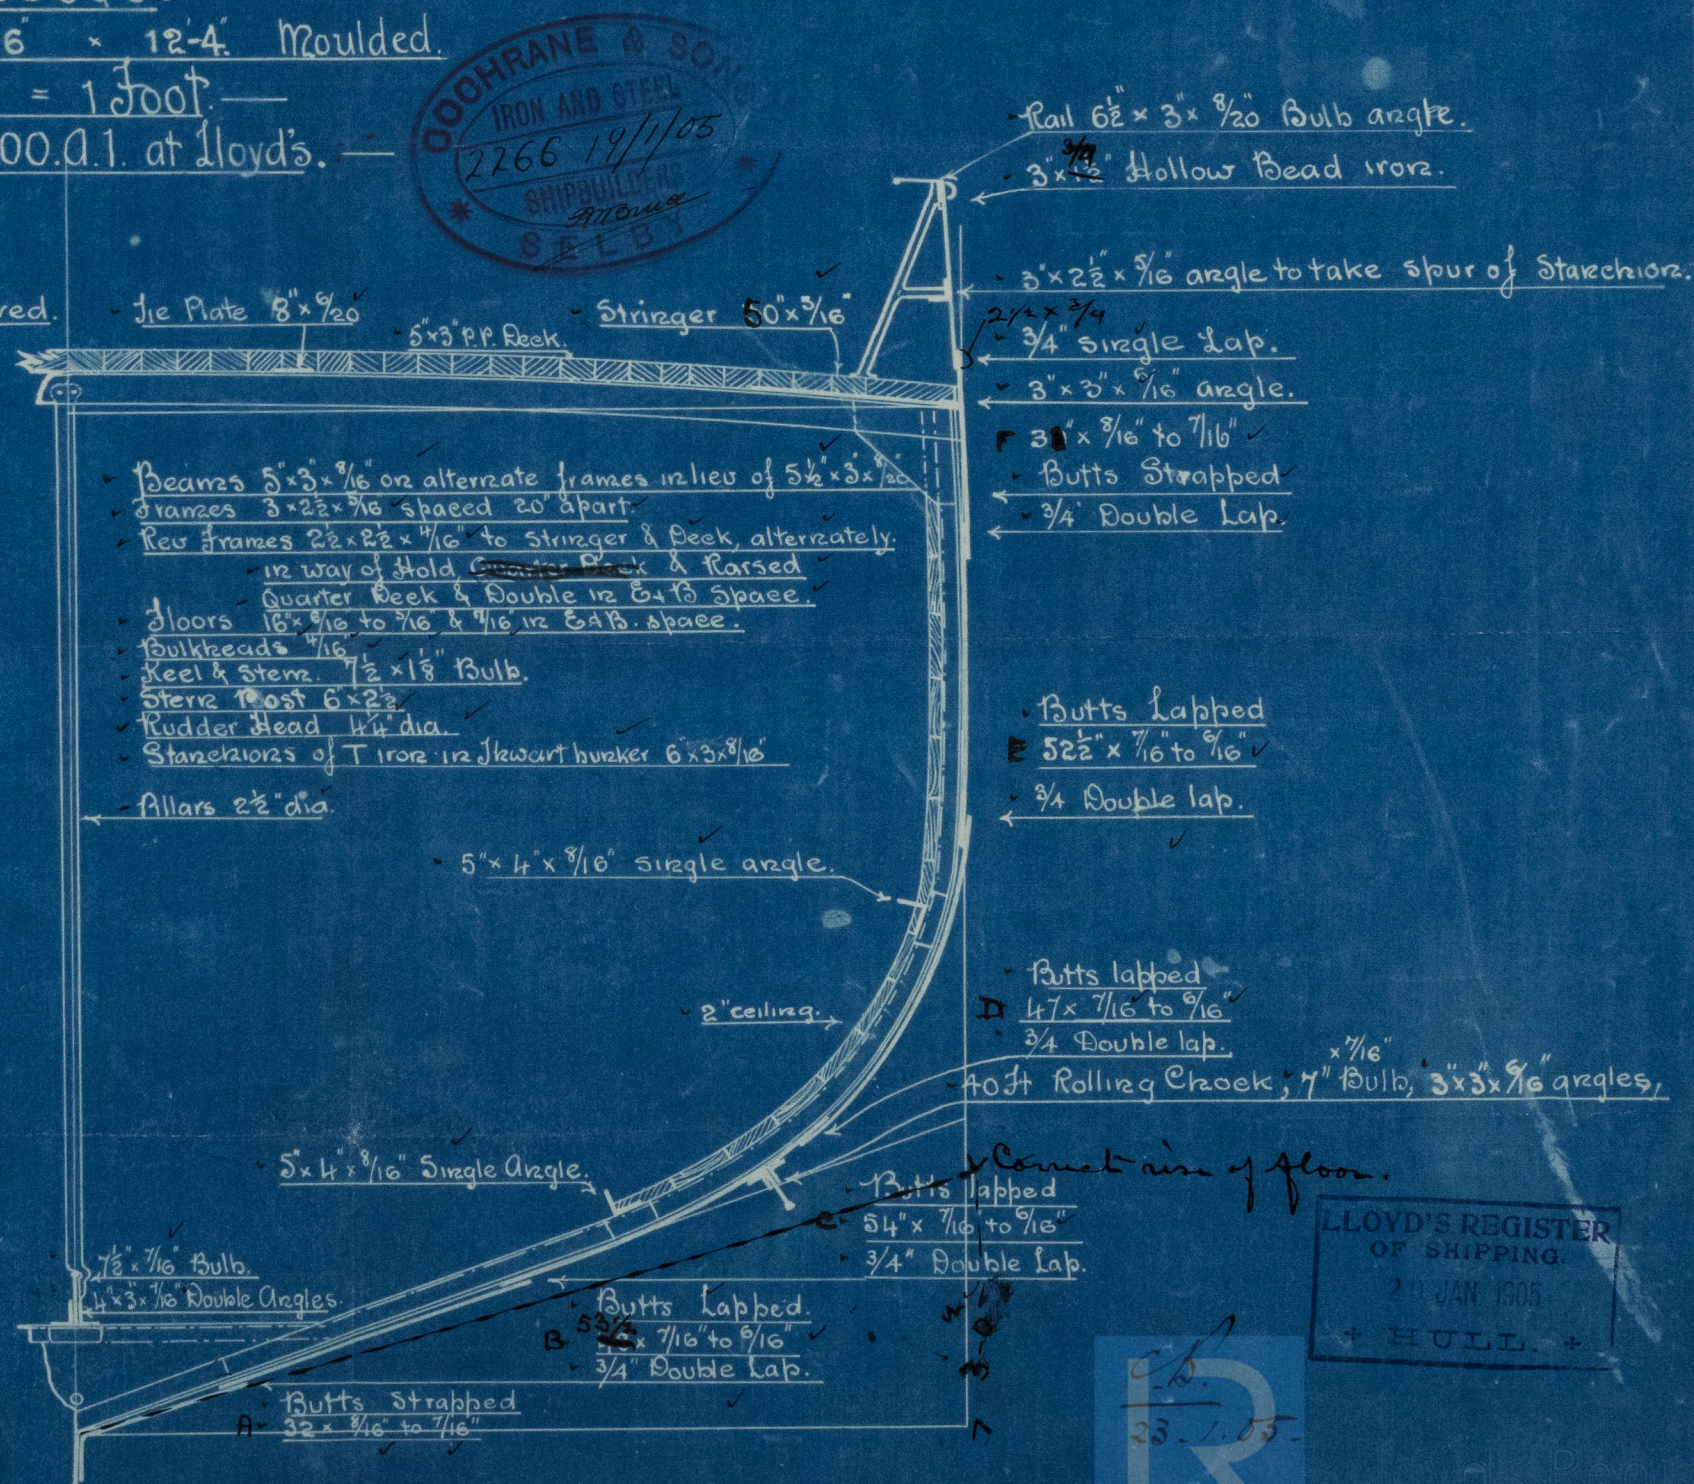


LLOYD'S REGISTER  
OF SHIPPING  
+ HULL +

23.1.55



Cochrane & Sons  
No 3384 g.  
Mudship Section

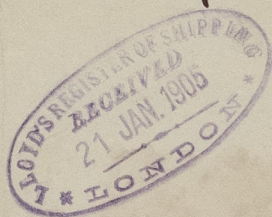

s/s Viola  
Hull Report No. 16955

s/s Orpheus  
Hull Report No. 17035



© 2021

Lloyd's Register  
Foundation

006204-006220-0215