

— NUMERALS. —

LENGTH 120

BREADTH 21.83

DEPTH 12.50

$B+D = 34.33$ $L \times (B+D) = 4119.6$

$\frac{L}{B} = 5.6$ $\frac{L}{D} = 5.43$

— No 504. —

— MIDSHIP SECTION —

— STEEL SCREW TRAWLER "VICTORIA" —

DIMENSIONS: 120' 0" B.P. x 22' 0" EXT x 12' 6" MLO.

TO CLASS: 100 A.1 LLOYD'S (STEAM TRAWLER)

SCALE $\frac{1}{2}$ " = 1 FOOT.

EQUIPMENT.

1 ORDINARY ANCHOR 54 CWTs.


1 " " 4 $\frac{3}{4}$ "

1 " " 2 $\frac{1}{2}$ "

30 FATHOMS 1" STUD LINK CABLE

60 " 2 $\frac{1}{4}$ STEEL WIRE

60 " 1 $\frac{3}{4}$ " "

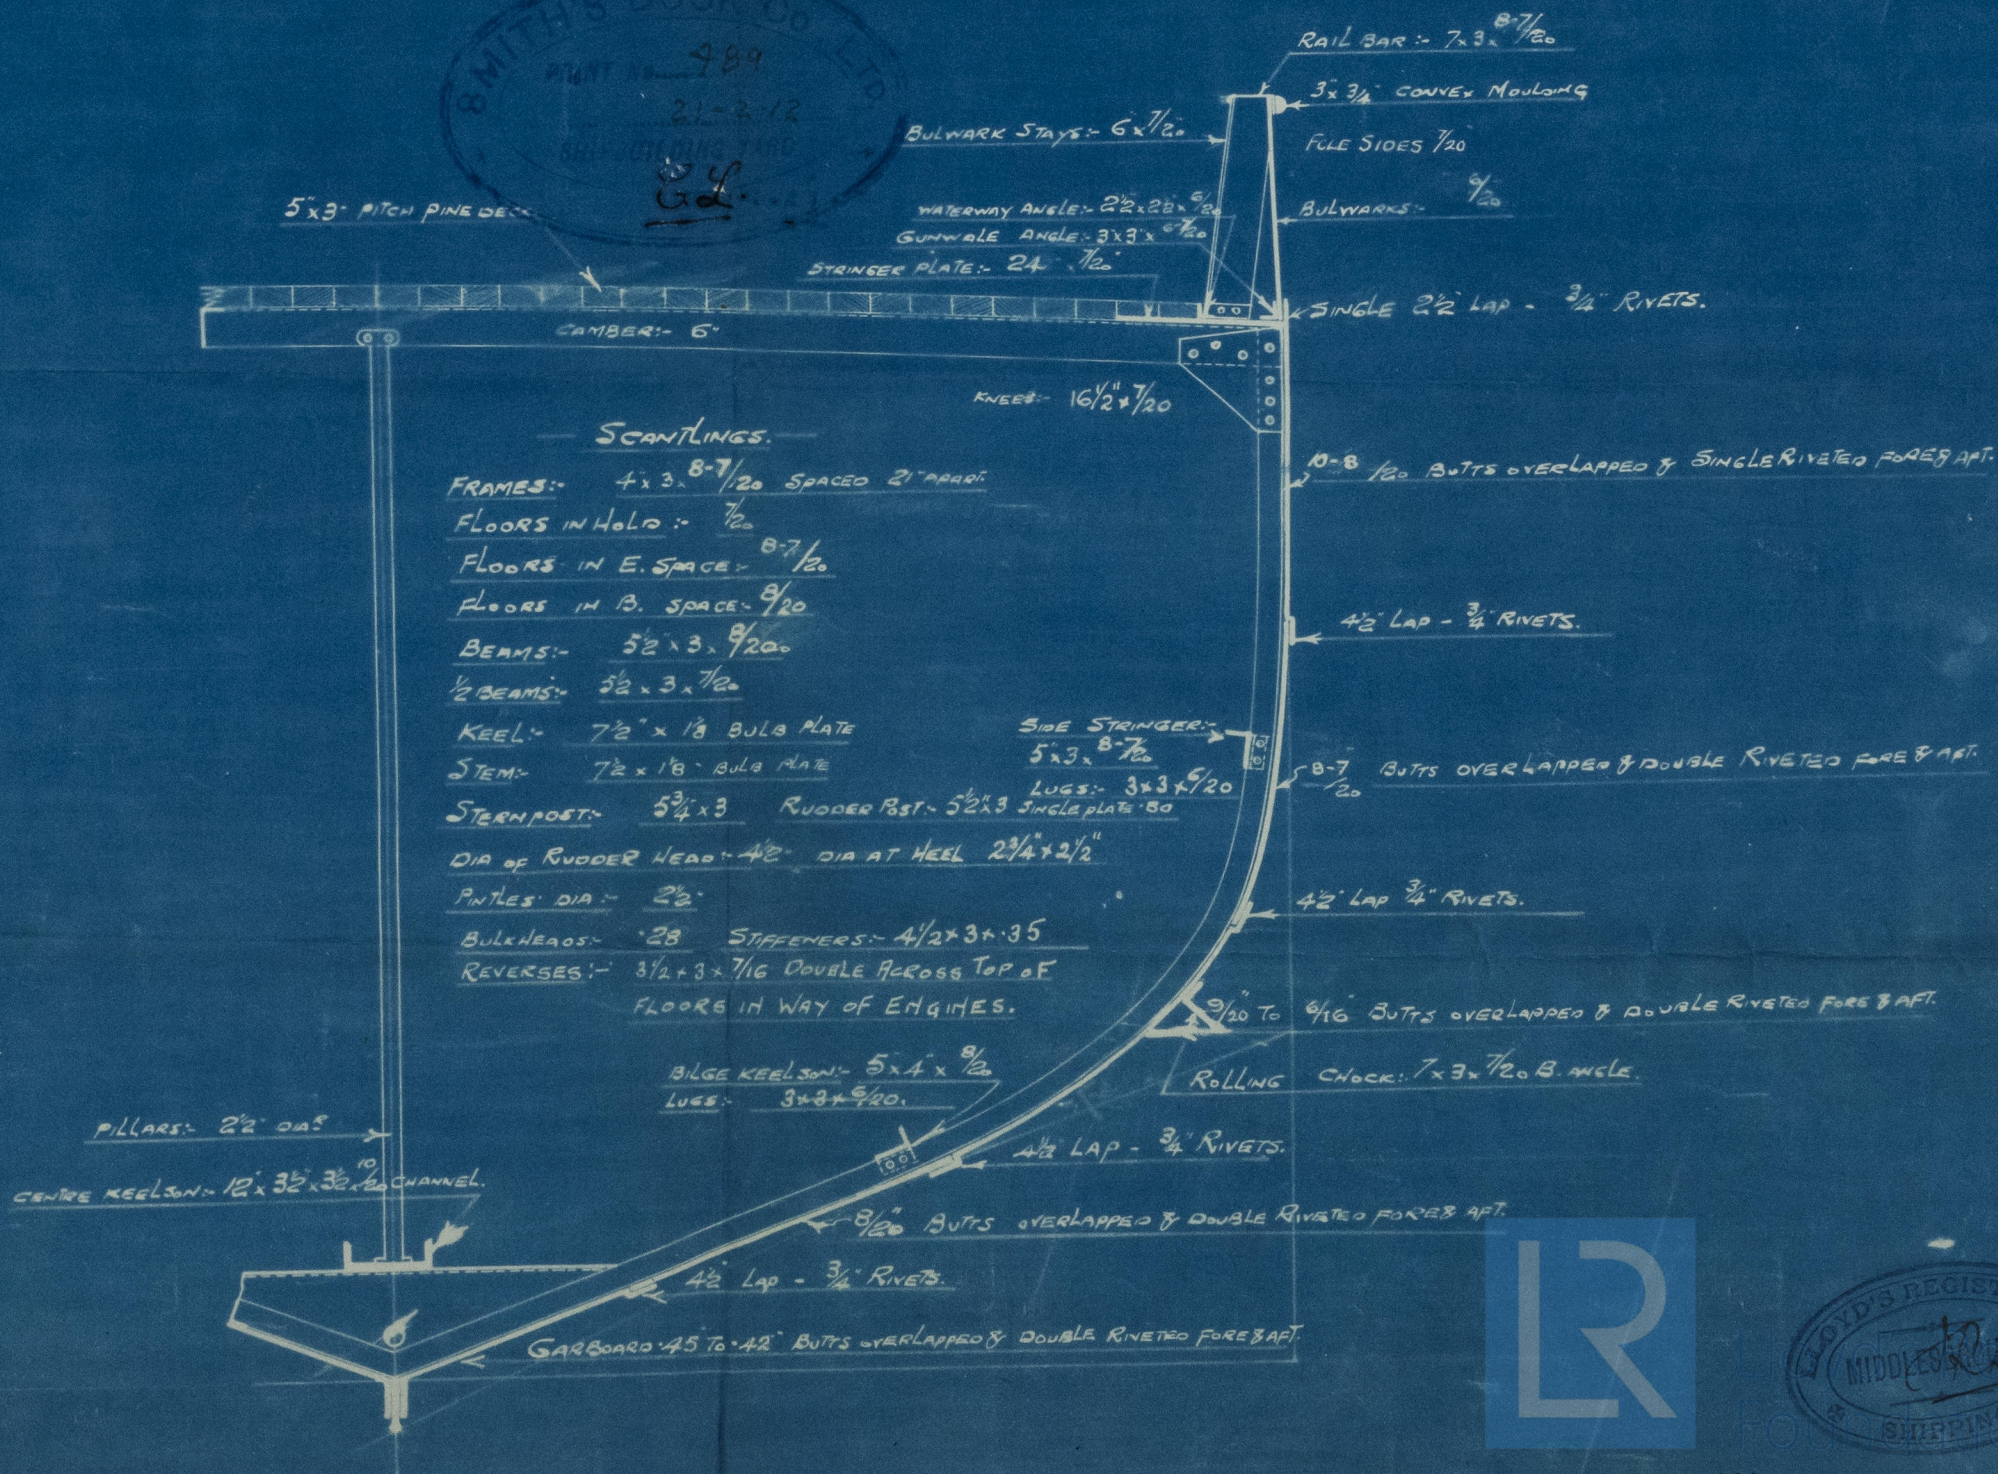

West Smith Dock 6⁰ 2⁵

No 504

S.S. "VICTORIA"

Mar. Rpt. No. 9/244

Marship Section

(as ~~built~~)

© 2021

Lloyd's Register
Foundation

006204-006220-0224