



26.4.11
31.5.11
21.6.11

No 504
ELEVATION.
STEEL SCREW TRAWLER.
DIMS. - 120'-0" BP x 22'-0" EXT. x 12'-6" MLD.
SCALE 1/4" = 1 Foot.
TO CLASS 100 ALL LOYDS. *Steam Trawler*

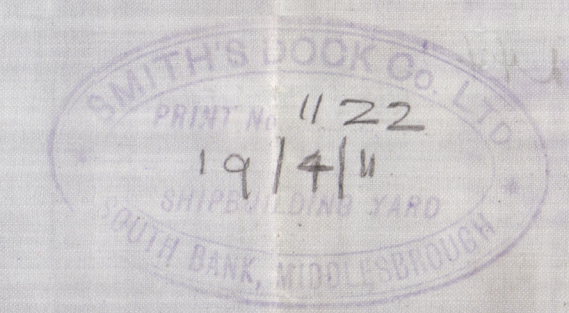

2.2
od 19.2.11

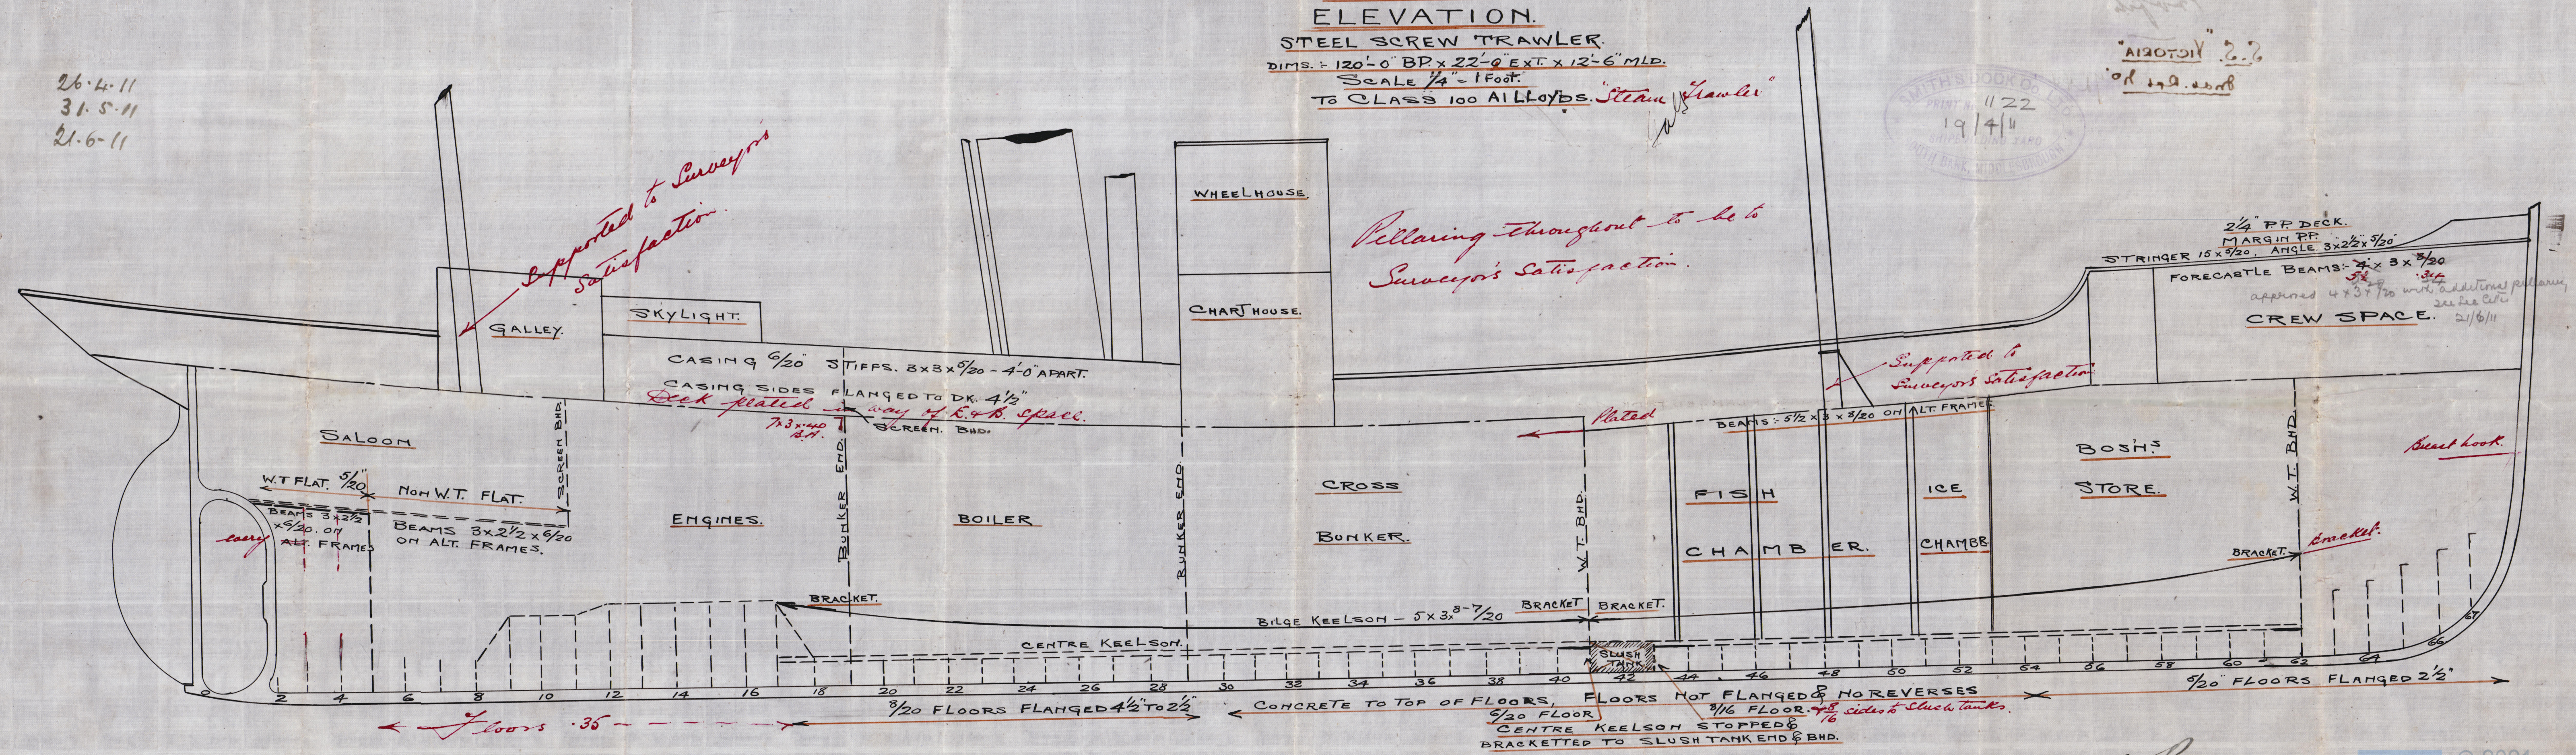

C.B.
26.4.11.

Mass^h Smith Dock Co^d

In 504.

Profile

S.S. "VICTORIA"

Draw. No. 1044



© 2021

Lloyd's Register
Foundation

006204-006220-0225