


ALTERATIONS		
NO.	DESCRIPTION	APPROVED DATE
1	ANCHORS TO KEEL MADE 6" DIA. INSTEAD OF 5" DIA.	10/10/1916
2	PLATING AND TRANSVERSE ALTERED TO SUIT HATCHES INSURED FOR 18" TO 24" FEET WIDE	10/10/1916
3	EQUIPMENT MATERIAL CHANGED BY LIGHTENING THE DECK. GROUND NO. NOT CHANGED	10/10/1916
4	REVISED TO SUIT PRINT APPROVED	10/10/1916
5	UNDER DECK PLATING PLATE CHANGED TO EQUIPMENT NO. CHANGED FROM 11" TO 12" AT ALL CORNERS AND BRIDGE HOUSE	10/10/1916
6	BY ALT. BRIDGE HOUSE	10/10/1916

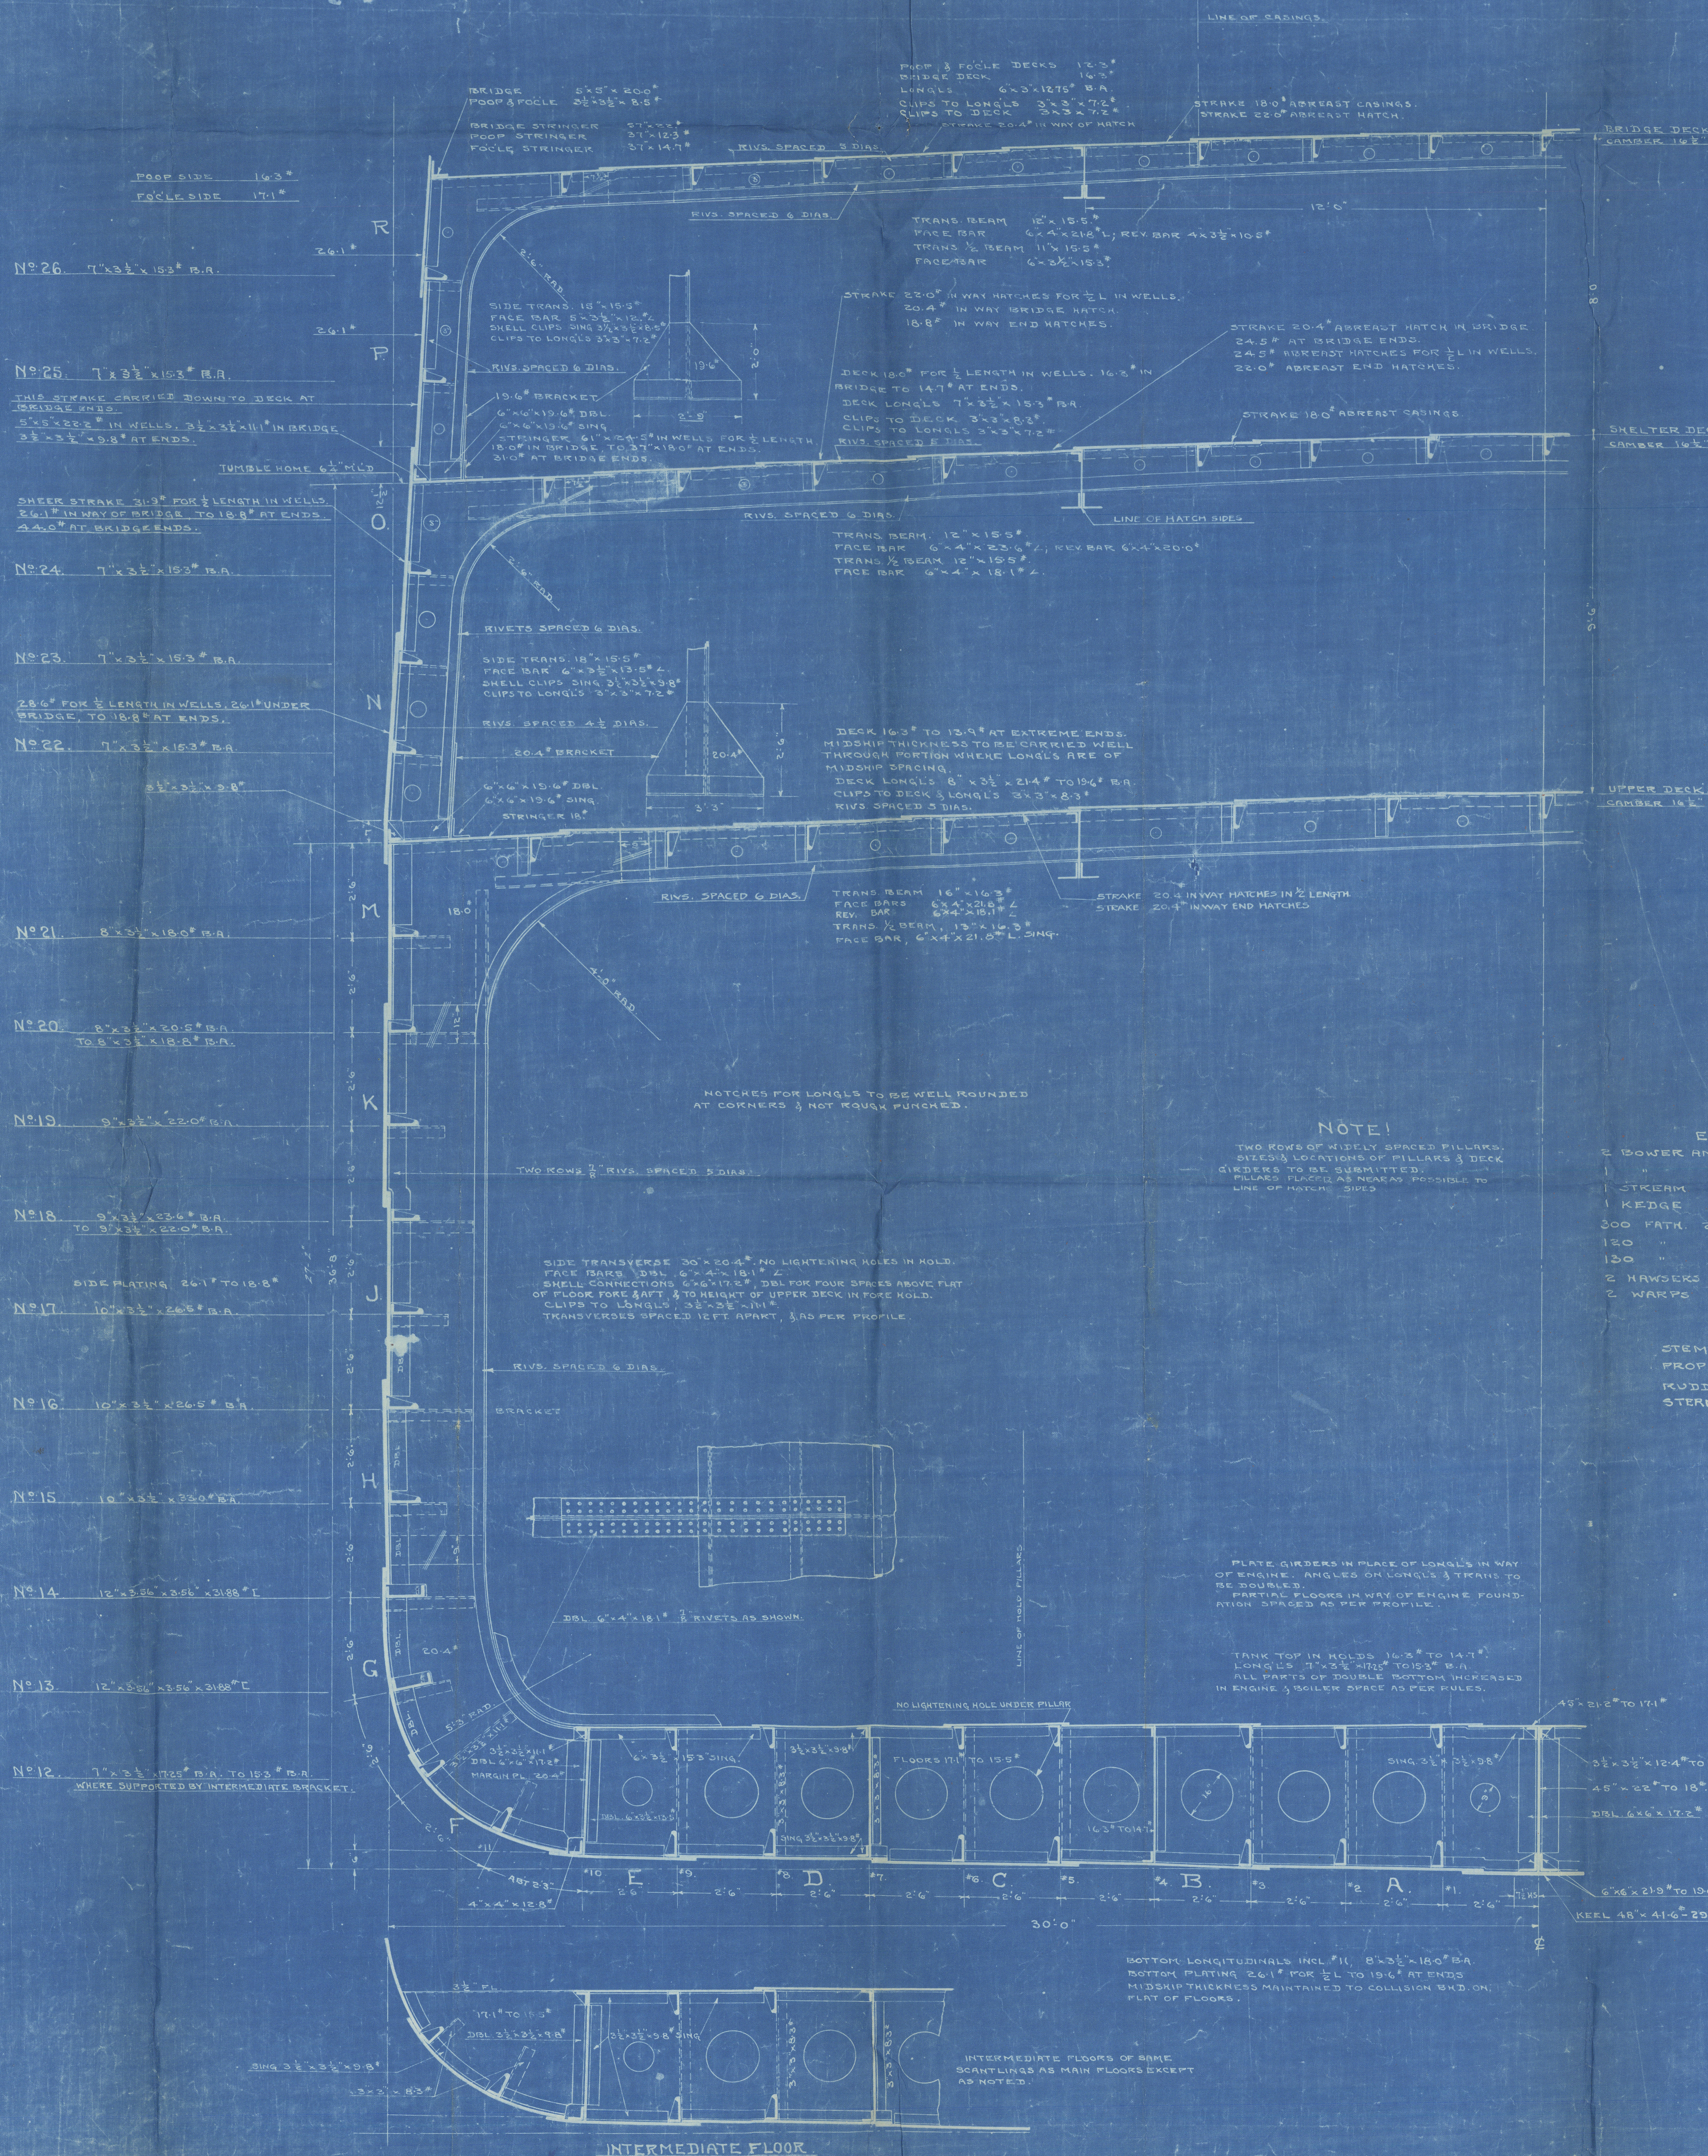

RIVETING NOTES.

ITEM.	NO. OF RIVETS	DIAM. OF RIVET	SPACING	TYPE	LOCATION
ELSEWHERE TO BE ACCORDING TO RULES.					

NOTE:-
TWIN SCREW FOR CONT. CUT
SINGLE SCREW FOR ALL OTHERS


LENGTH LLOYDS	430'6"
BREADTH MLD	60'0"
DEPTH SHUTTER DECK	36'8"
SHUTTER DECK TYPE	
INCREASED FOR DEEP LOADING	
LLOYDS NUMERALS	
BREADTH	60'0"
DEPTH FOR RULE ONLY (36'0"-5'0")	28'6"
TRANS. NO.	28'6"
LENGTH	430'5"
LONG. NO.	28'6"
SHUTTER DECK 430'5" x 6' x 3/4"	2607
PL. & F. (430'5" x 3' x 1/4") x 6' x 3/4"	1329
BRIDGE HOUSE (340'250' x 75' x 1/2")	216 - C7016
" (440'225' x 75' x 1/2")	220 - C7016
" (520'225' x 75' x 1/2")	228 - C7016
EQUIP. NUMERAL	43161 - C7016
"	43168 - C7016
"	43200 - C7016
1/2 SHUTTER DECK	1198
1/2 BRIDGE DECK	584

THIS PLAN HAS BEEN CORRECTED TO AGREE WITH AMENDMENTS SHOWN ON PRINT APPROVED BY LLOYDS AUG. 24, 1916, & WITH PERMISS. APPROVED BY LLOYDS 11 OCT. 1916

Contract No. C-1738, Structure No. 201
Name MIDDY SECTION
S.S. SHUTTER DECK CARCO STEAMER
430'6" x 60'0" x 36'8" (SH. DR.) MLD.
Scale 1" = 1' FT. Date 10-1-1916
Made by Q245, Traced by Q245, Checked by Q245
PENNSYLVANIA SHIPBUILDING CO. GLOUCESTER, U.S.A.
Lloyd's Register Foundation

Midship Section.
Hull 17. Motorship "William Penn"
Pasny & Jones Co.
Gloucester, N.J.

Phl 4190

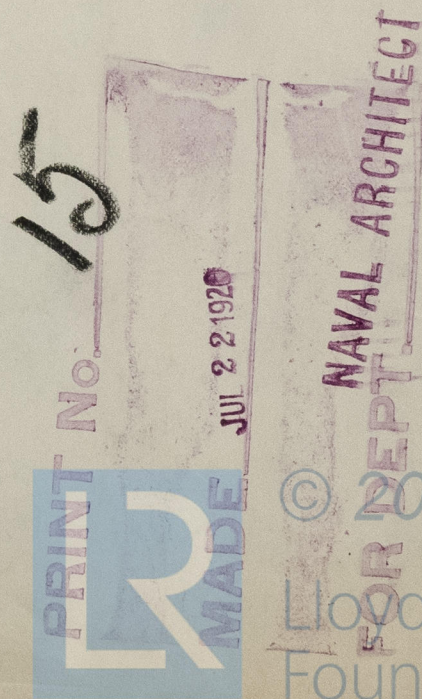

006221-006235-0017

© 2020

Lloyd's Register
Foundation