

# MIDSHIP SECTION

SSN<sup>OS</sup> 385-6

SCALE 1/2" = 1 FOOT

DIM<sup>S</sup> LENGTH 127'0" BREADTH 22'0" DEPTH OF HOLD 11'9" DEPTH M<sup>AP</sup> 12'6"

E & B CASING AS PREVIOUSLY APPROVED  
DECK PLATED OVER IN WAY OF E & B CASING

## NUMERALS AS PER RULES

1/2 BREADTH	10.95
1/2 GIRTH	19.75
DEPTH	12.95
	43.65 1 <sup>ST</sup> NO
LENGTH AS PER RULE	125.87
	54942255.2 <sup>ND</sup> NO


## PROPORTIONS

BREADTHS TO LENGTH	5.70
DEPTH " " "	9.7

## EQUIPMENT

1 <sup>ST</sup> BOWER 5 1/2" EX STOCK	7-1-0	Stockless
2 <sup>ND</sup> BOWER 5 " "	7-1-0	fitted
3 <sup>RD</sup> BOWER 2 3/4 " "		
105 FATHOMS 1 1/8" SHORT LINK CABLE		
60 " 6 " HAWSERS		
60 " 4 1/2" WARP		

COCHRANE & SONS  
SHIPBUILDERS  
SELBY

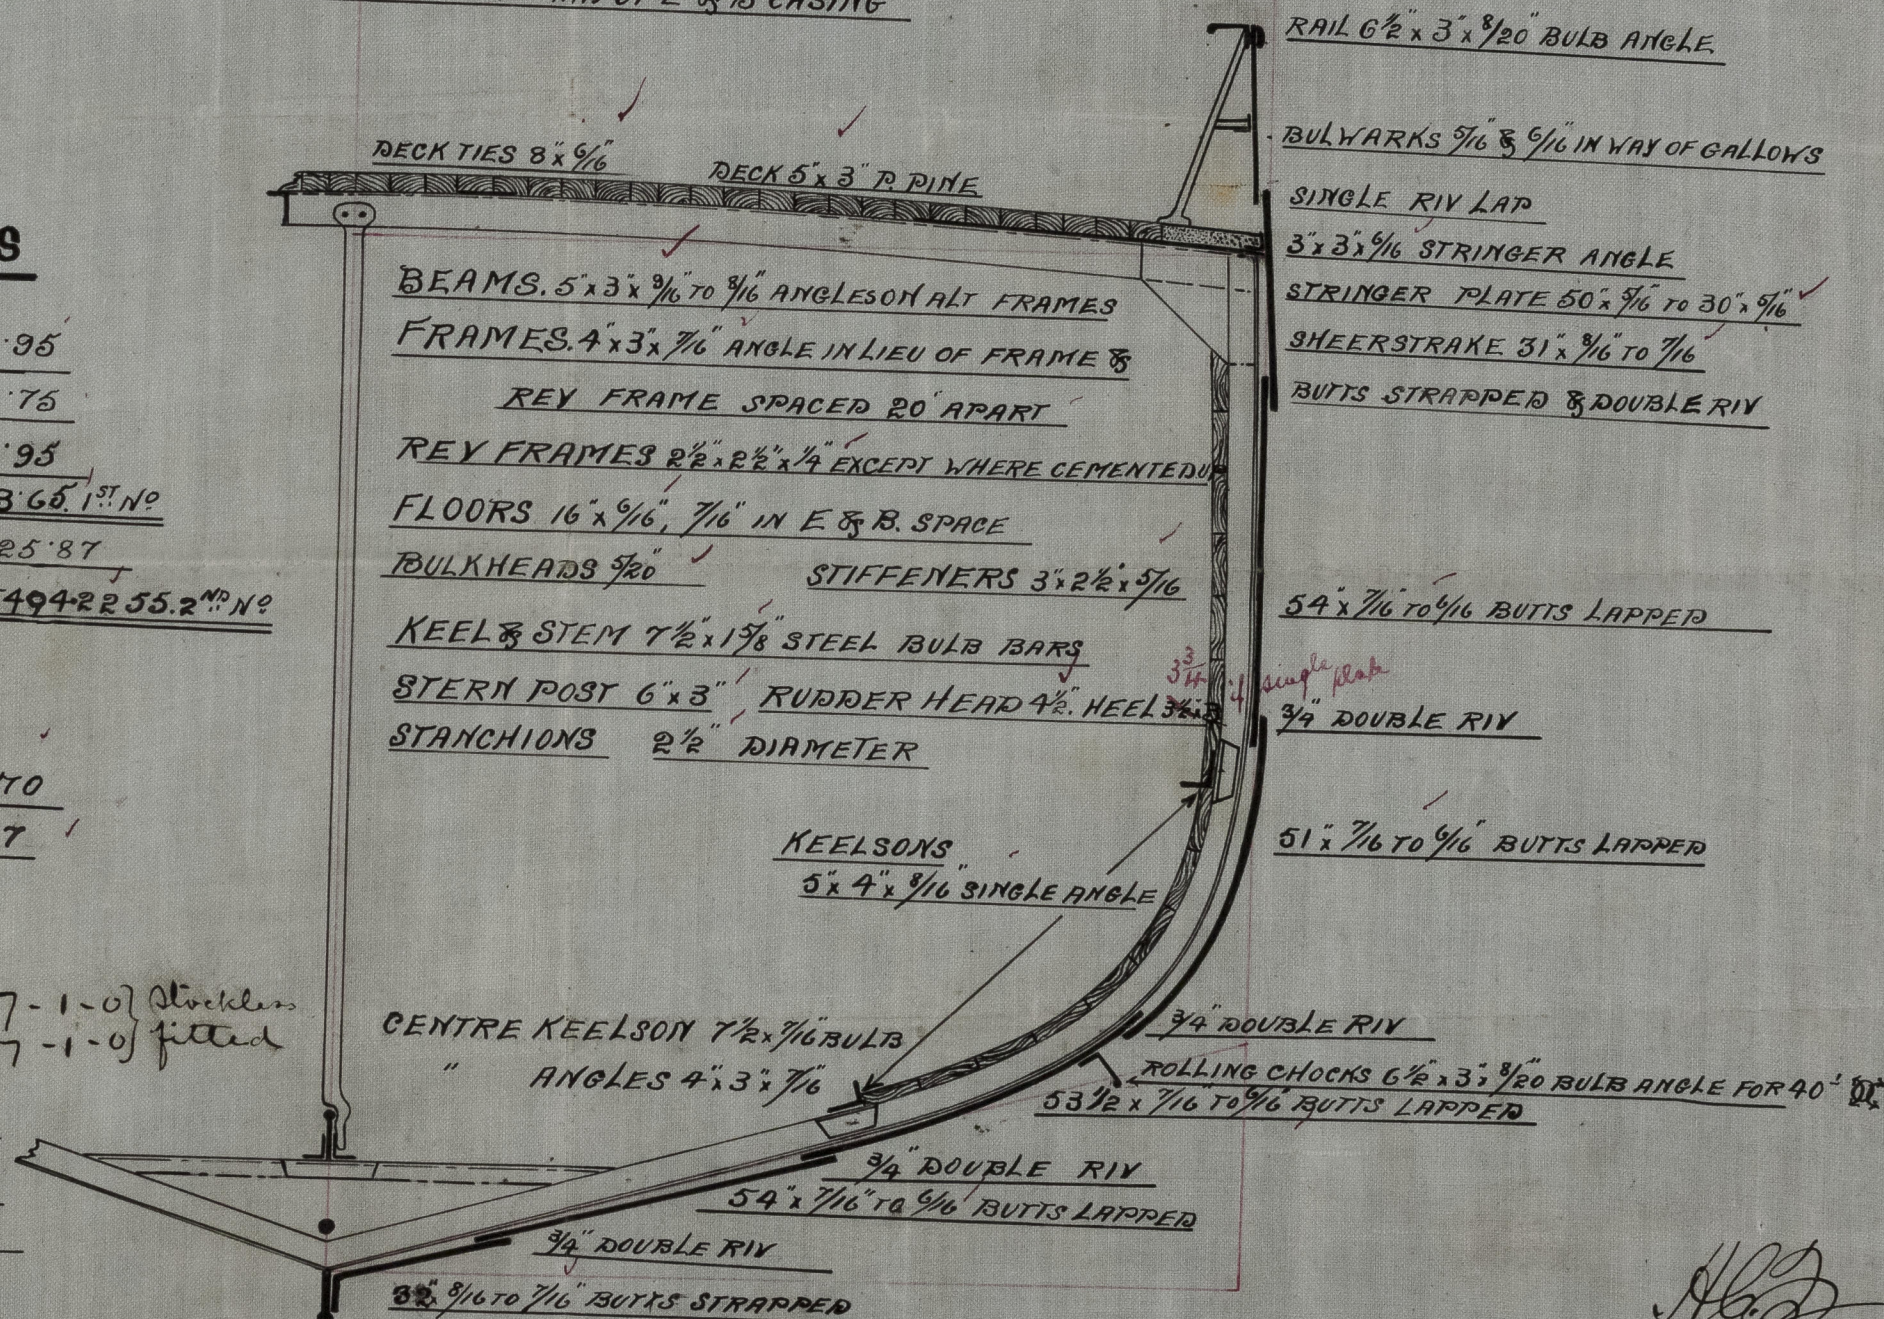

25.7.06

LLOYD'S REGISTER  
OF SHIPPING  
HULL



Midship Section

Cochran & Sons

s/s. No. 385 & 6.

s/s Volante

Hull Rpt No. 18783

s/s Ugadale

Hull Report No. 18795

















© 2020

Lloyd's Register  
Foundation

2010-552900-0102

