
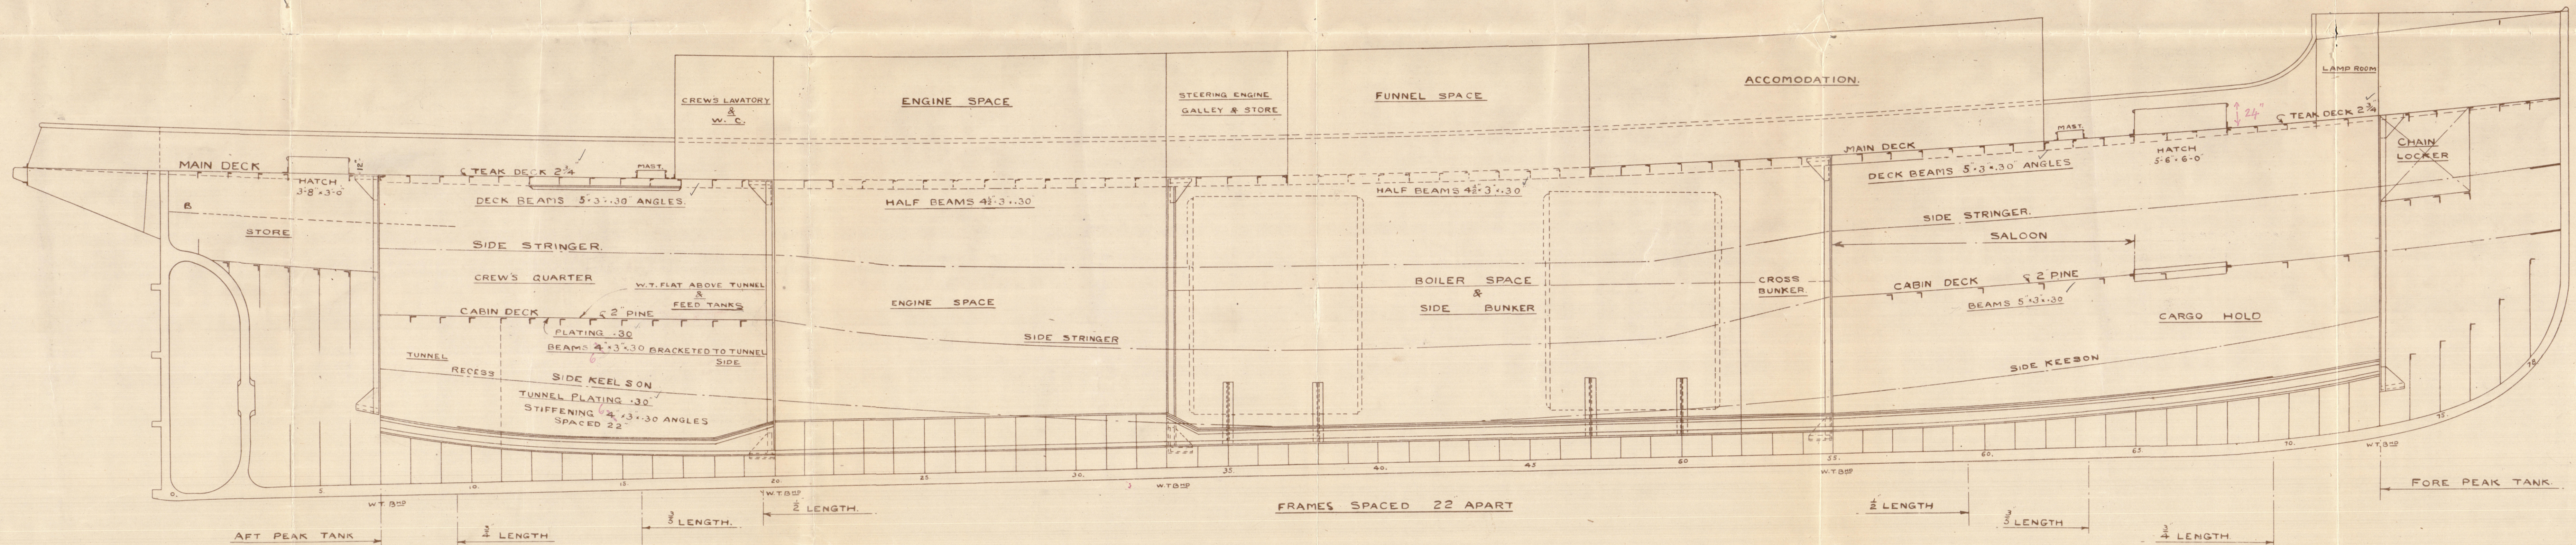


24.9.15

DECK STRINGER PLATES 30" x 3/8" TO 15" x 3/8"
BUTTLAPS 5" x 3/4" RIVETS
2 1/8" PITCH FOR 1/2" LENGTH 4 1/4" & 3/8" RIVETS 2 1/4" PITCH AT ENDS
DECK TIE PLATES 8" x 3/8" DOUBLE RIVETED BUTTLAPS
DECK PLATING .25" DOUBLE RIVETED BUTTLAPS FOR 1/2"
& SINGLE AT ENDS EDGE LAPS 2 1/4"

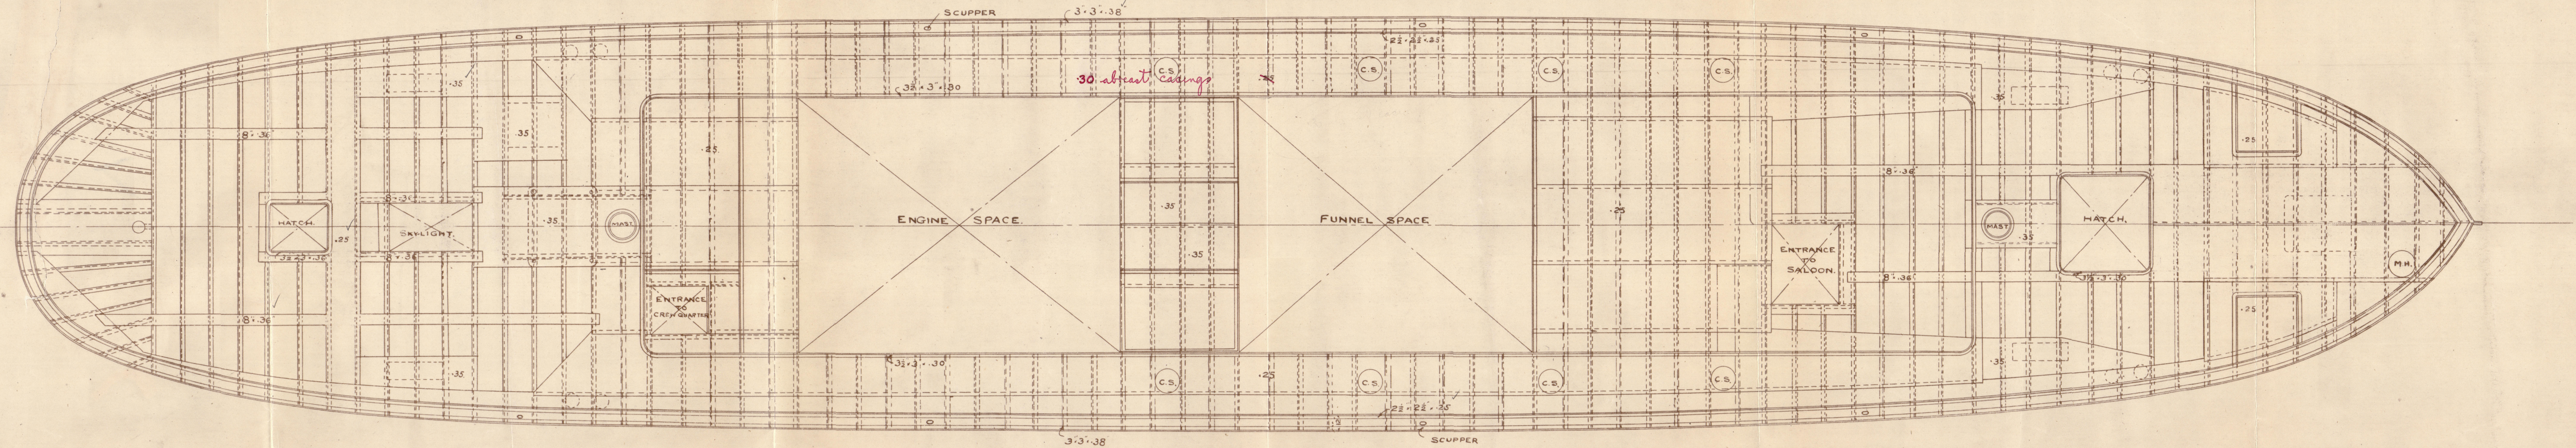


RECEIVED

25 OCT 1915

ANSWERED Noted & returned

26.10.15 THE SHANGHAI DOCK & ENGINEERING CO., LTD.
W. S. S. S. S.

MANAGER

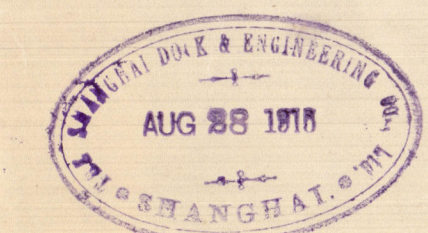

No 1390




PROFILE & DECK PLAN

SCALE 1/4 INCH TO ONE FOOT

THE SHANGHAI DOCK & ENGINEERING Co. Ltd.



308
DRAWING No 15.

for
25.9.15

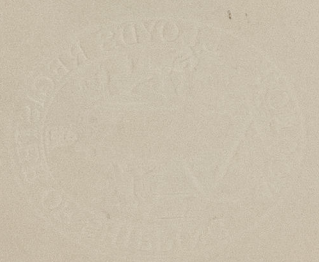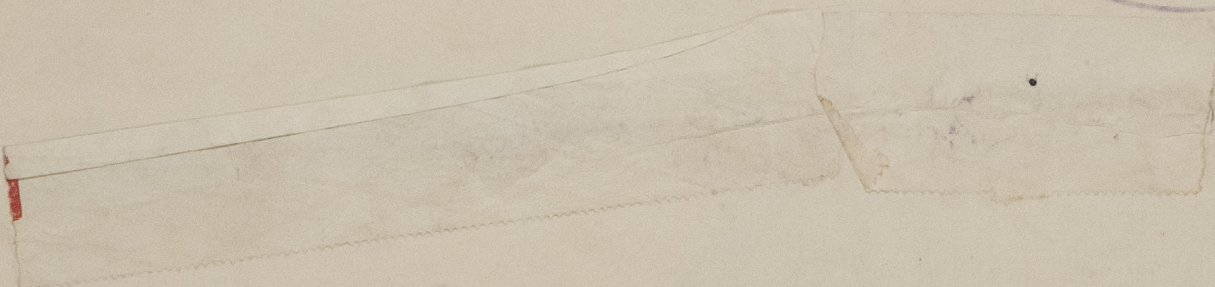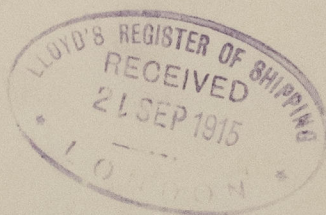

S.S. "Sia Krossomato"
Shi 1593.

Profile + deck plan
No 1390

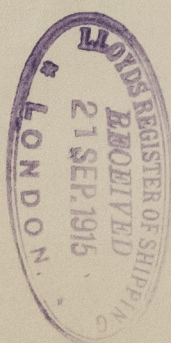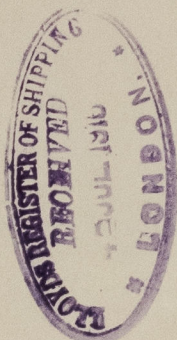

© 2020

Lloyd's Register
Foundation

006236-006247-0042