

23.11.15

CABING TOP 20

SCANTLING NUMBERS

TRANSVERSE $26 + 17 = 43$ $d = 15.70$

LONGITUDINAL $43 \times 196 = 6278$

DEPTH TO LENGTH = ~~823~~ 8.58

EQUIPMENT NO ~~6655~~ ⁶⁶⁴⁸ ERECTIONS ~~85874~~ ²¹⁴⁷²

EQUIPMENT

2 BOWER ANCHORS 10 $\frac{1}{2}$ CWT'S STOCKLESS

1 2 1

1. STREAM

EDGE 12


63		11	

60 76 CHAIN.

75 ----- 72 HEMP OR 22 STEELWIRE

50 52 HAWKERS AND WARPS

N^o 1390.

SINGLE SCREW SEA GOING TUG BOAT

FOR THE

ARTILLERY OF THE FORTRESS

OF VLADIVOSTOCK

DIMENSIONS 146'-0" B. P. X 26'-0" X 17'-0" MLD.

SCALE $\frac{3}{4}$ INCH TO ONE FOOT

THE SHANGHAI DOCK & ENGINEERING CO. LTD.

THE SHANGHAI DOCK & ENGINEERING CO., LTD.

W. B. Bunsell
MANAGER.

121018

RECEIVED

27 DEC 1915

~~ANSWERED~~ noted returns

27. 15 75.

THE SHANGHAI DOCK & ENGINEERING CO., LTD

© 2020


1820

Lloyd's Register **MANAGER**

006236-006247-0043

1390

S.S. "Sia Maoromets"
Shi 1593.

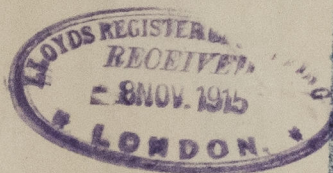

Shi 1390
Midship section



© 2020

Lloyd's Register
Foundation

006236-006247-0043