


23.3.15

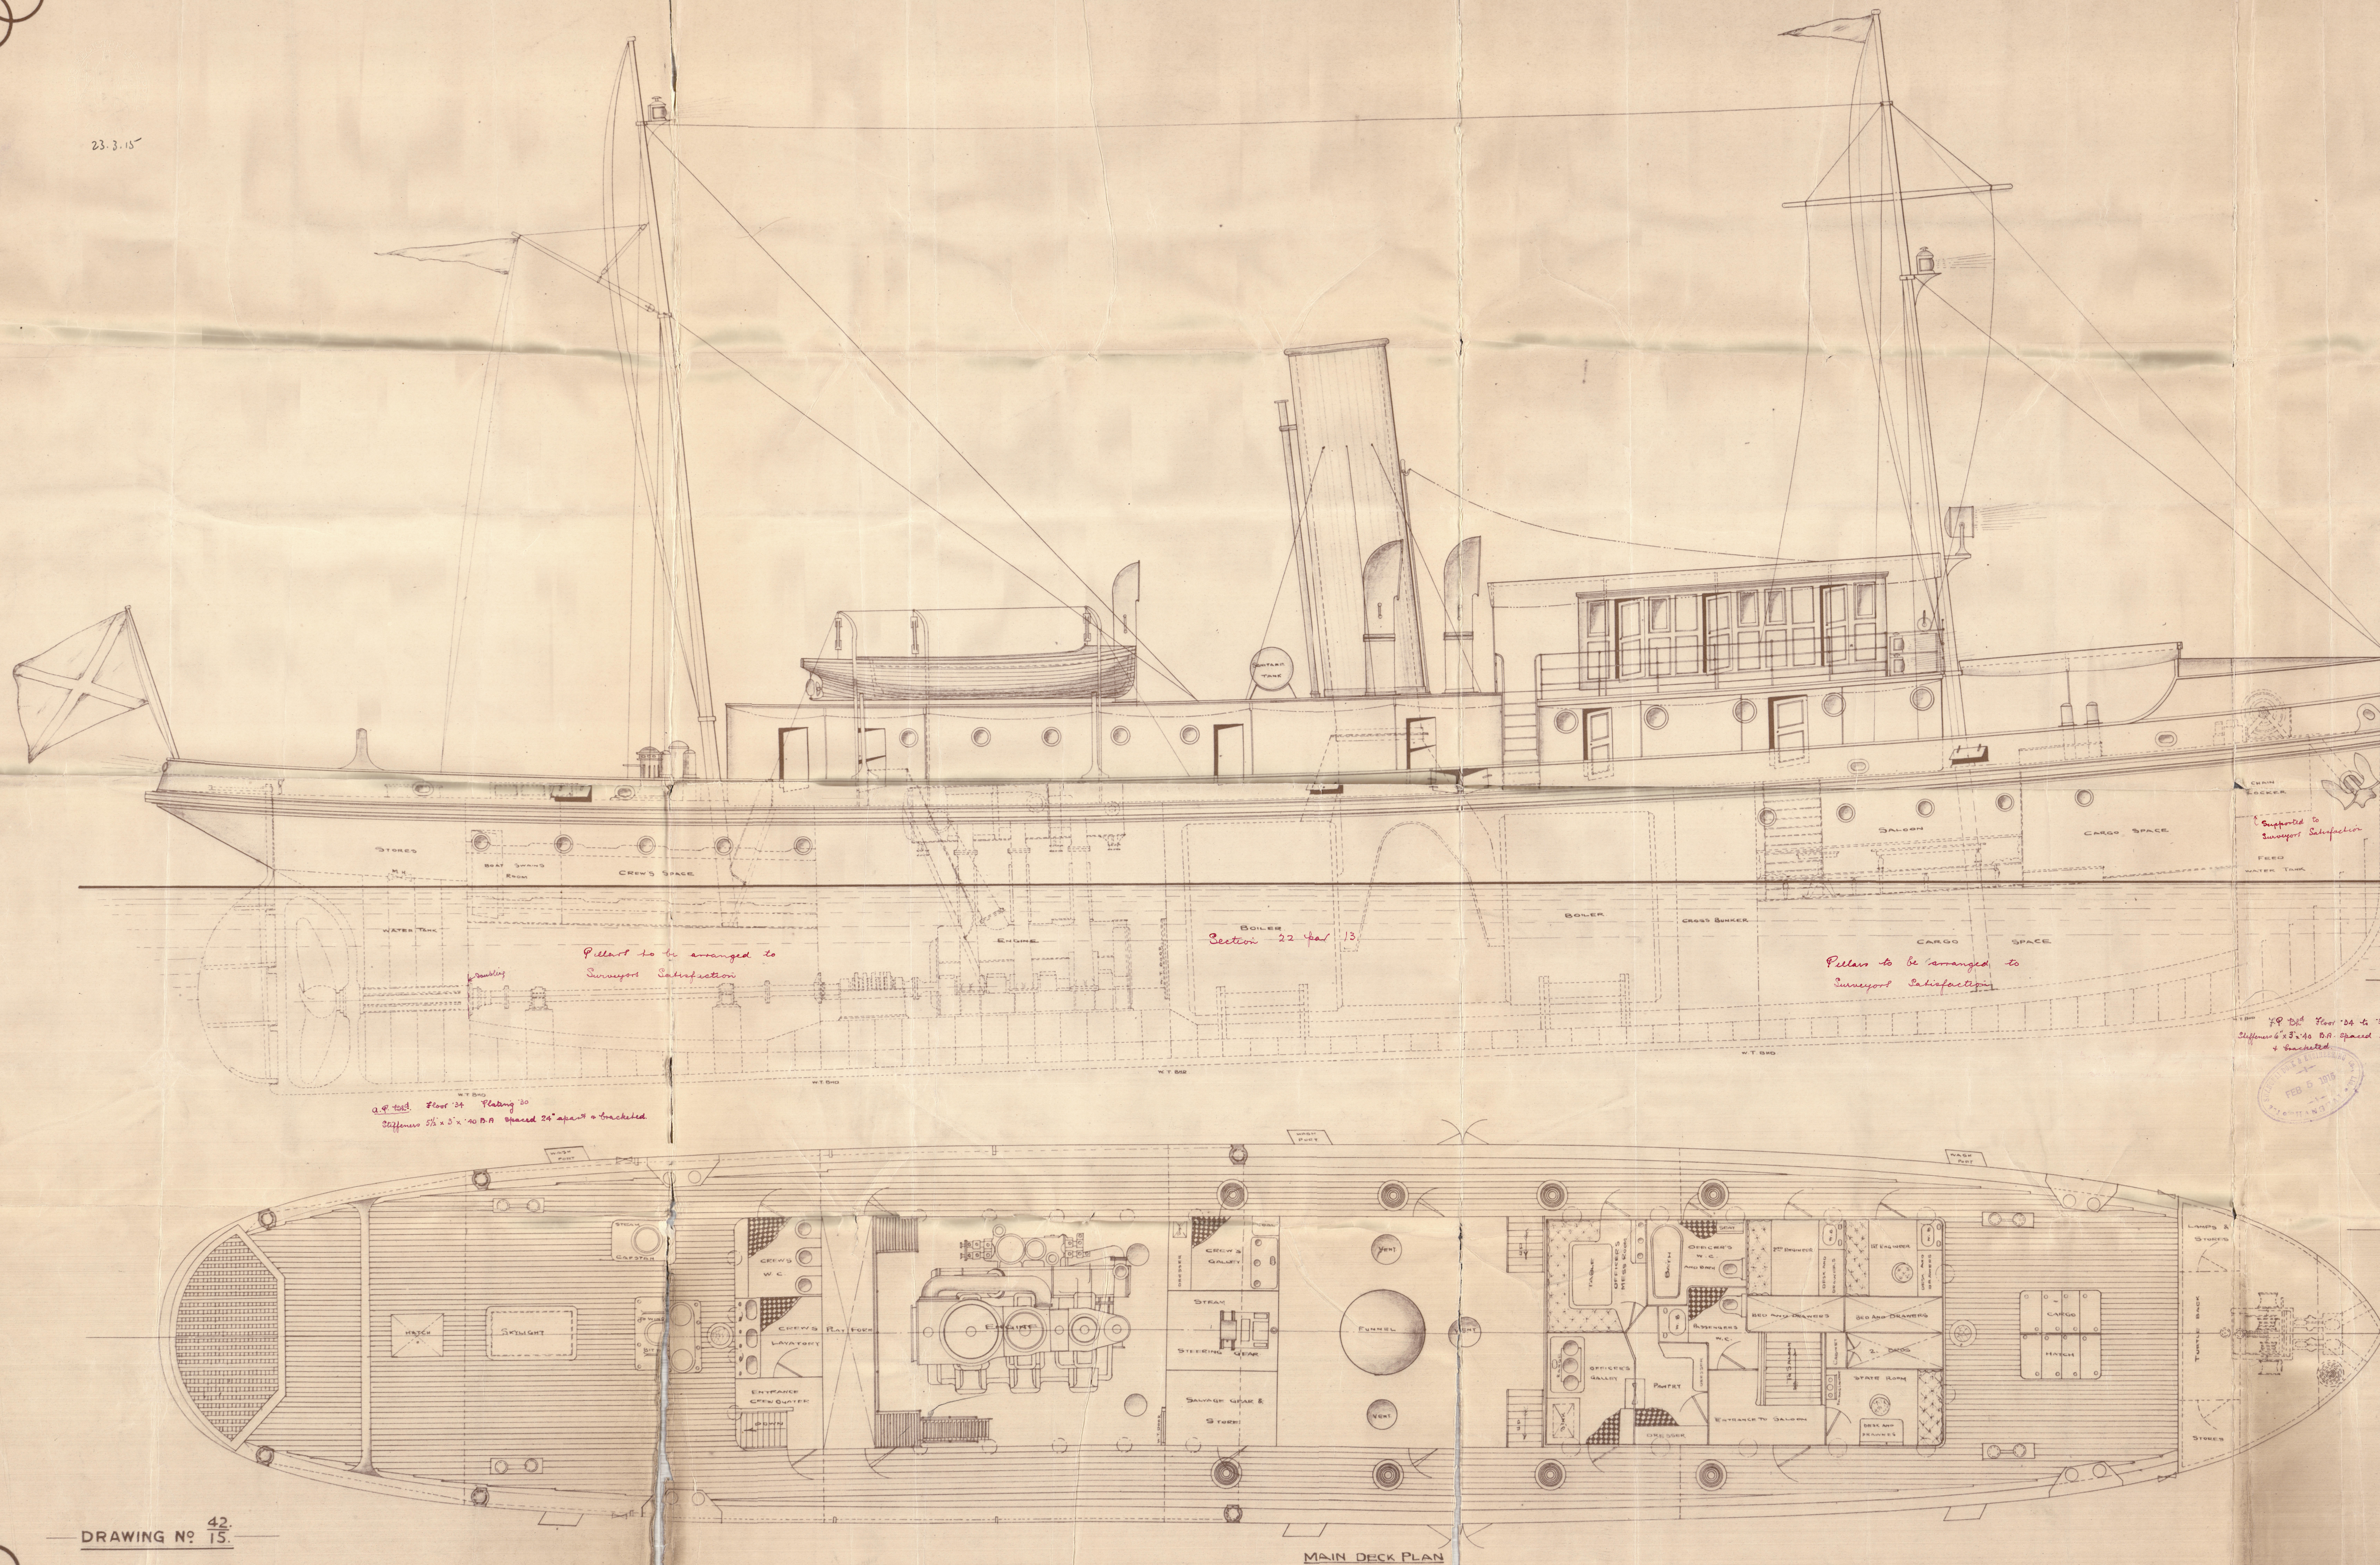

GENERAL ARRANGEMENT.
PROPOSED STEEL TUG BOAT.

DIMENSIONS.

LENGTH O. A.	154'-0"
LENGTH B. P.	146'-0"
BREADTH MLD.	26'-0"
DEPTH MLD.	17'-0"

SCALE $\frac{1}{4}$ INCH TO ONE FOOT.

THE SHANGHAI DOCK & ENGINEERING CO. LTD.


FEB 5TH 1915.

DRAWING NO. 42.
15


H. J. STOCKTON & CO
15, PHILPOT LANE,
LONDON, E.C.

32 MAR 1915
10 MAR 1915

S.S. "Sia Inorometo"
Shi 1595.

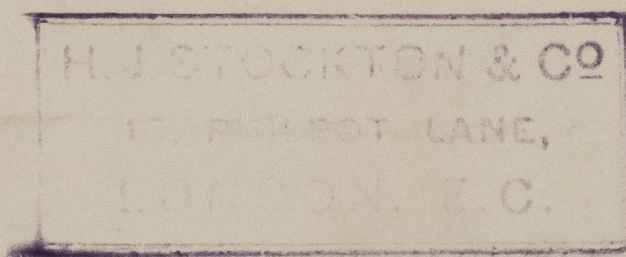

General average
No 1390

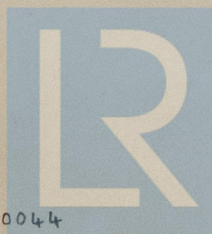

© 2020

Lloyd's Register
Foundation

006236-006247-0044