

— Engl. Floyd: Class ✕ 100 A 1. —




HAMBURG Report 14382

Act. Cas Neptune
Rostock

No 345

Graus verre Pleur
S Constantinos Vasilefs


Ham 14382

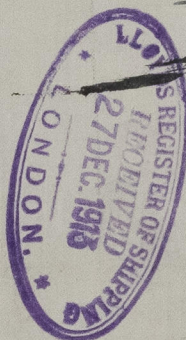

Graus verre Pleur

Rostock No 345

Graus verre Pleur
24/12/13

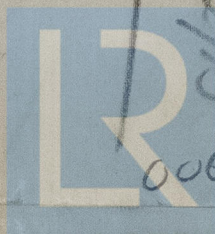

© 2020

Lloyd's Register
Foundation

006248-0-62570060