


8.720

POOP DECK

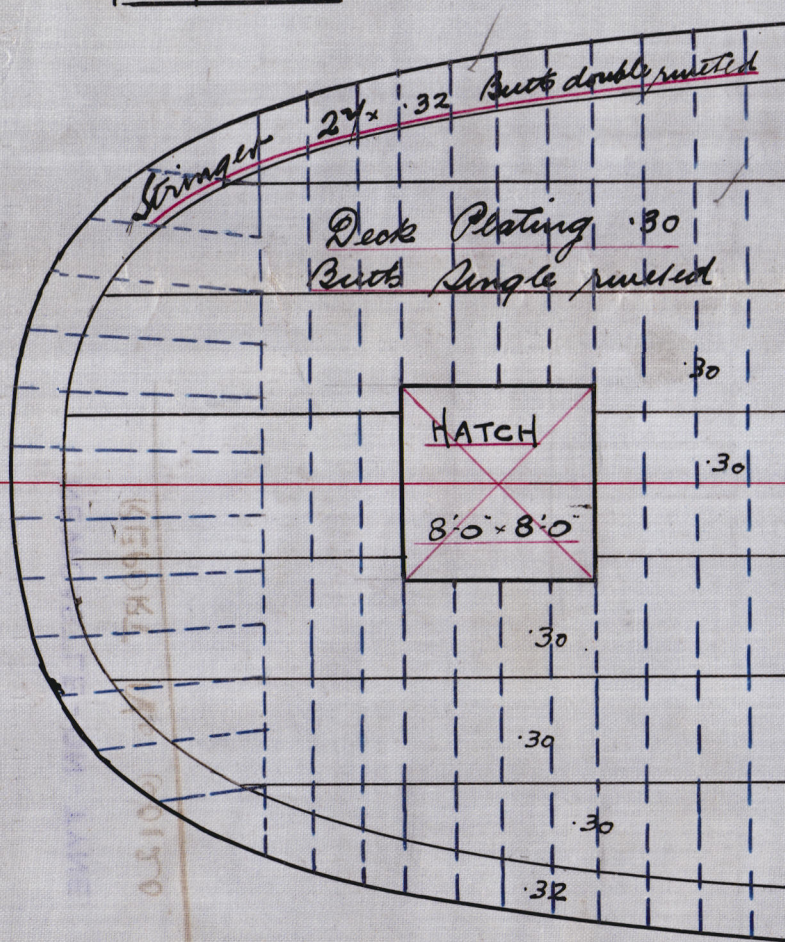


PROPOSED DECK PLANS


OF STEEL SCREW STEAMER

TO CLASS 100A1 LLOYDS.

SCALE 1/8" = 1 FOOT

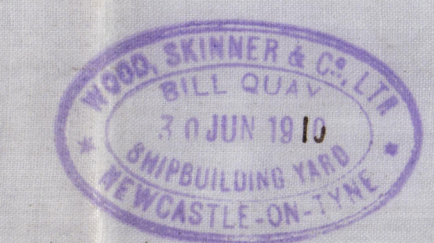

BRIDGE DECK

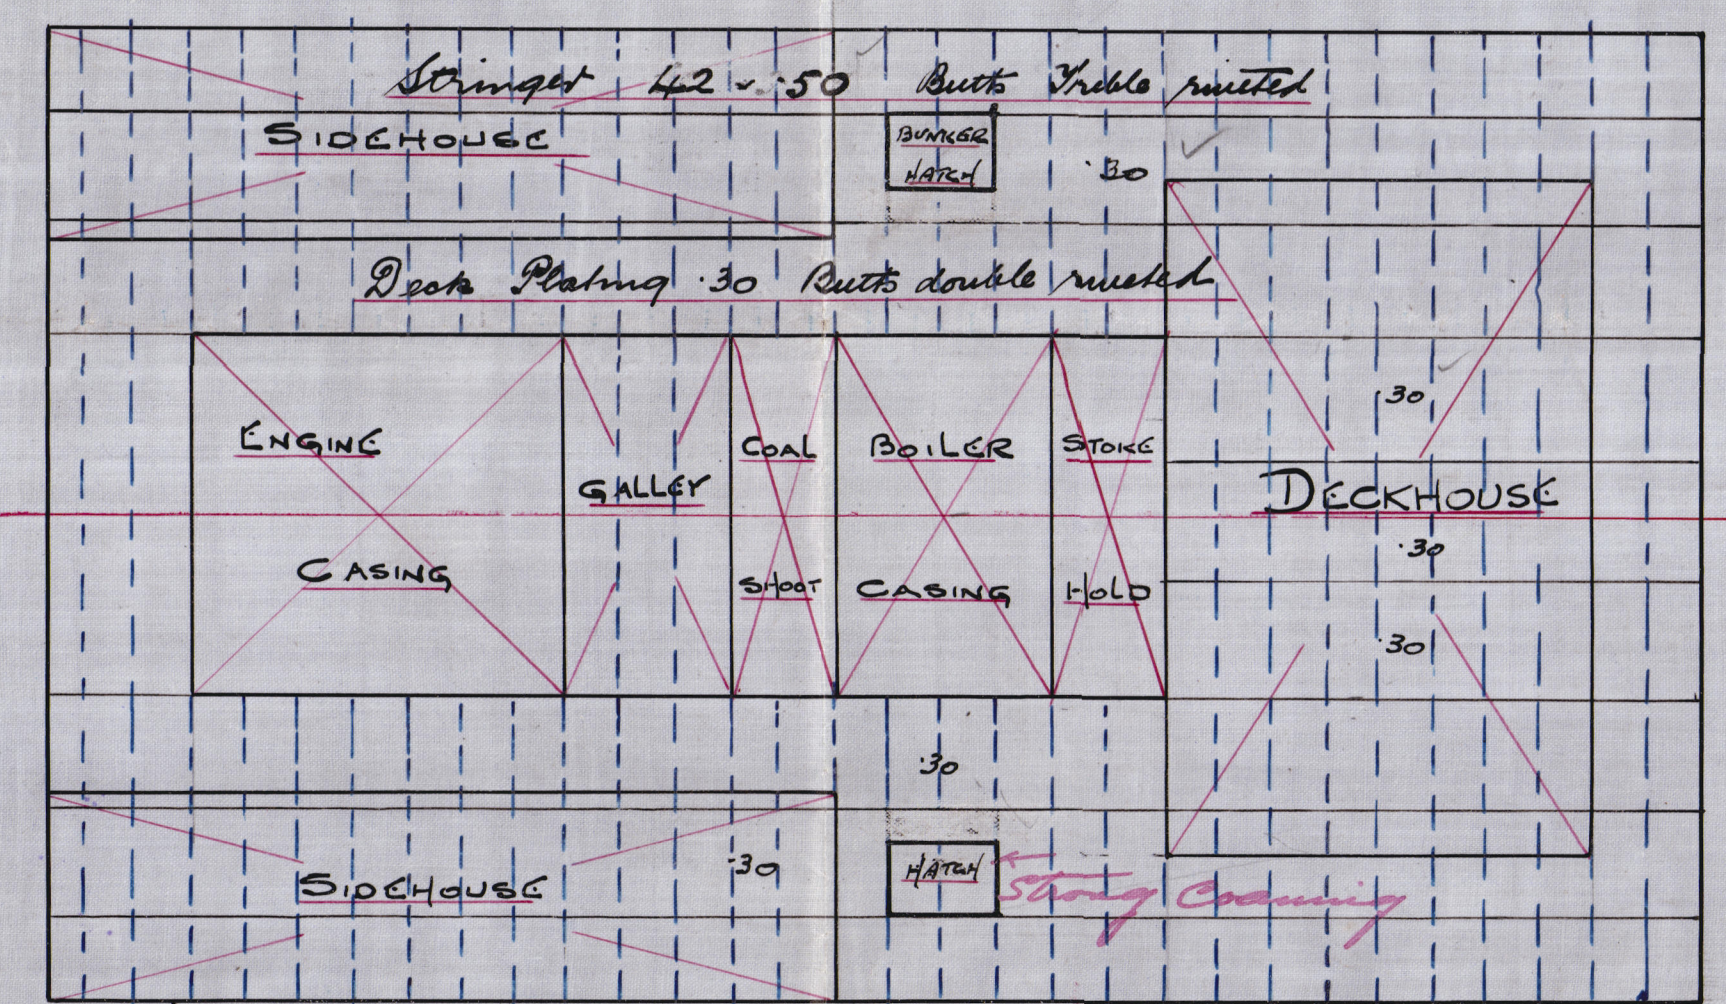

PRINCIPAL DIMENSIONS.


LENGTH B.P. 281'0"

BREADTH MOULDED 42'10"


DEPTH " 21'2"

WOOD SKINNER & CO. LTD.
SHIPBUILDERS
NEWCASTLE ON TYNE

FORECASTLE DECK

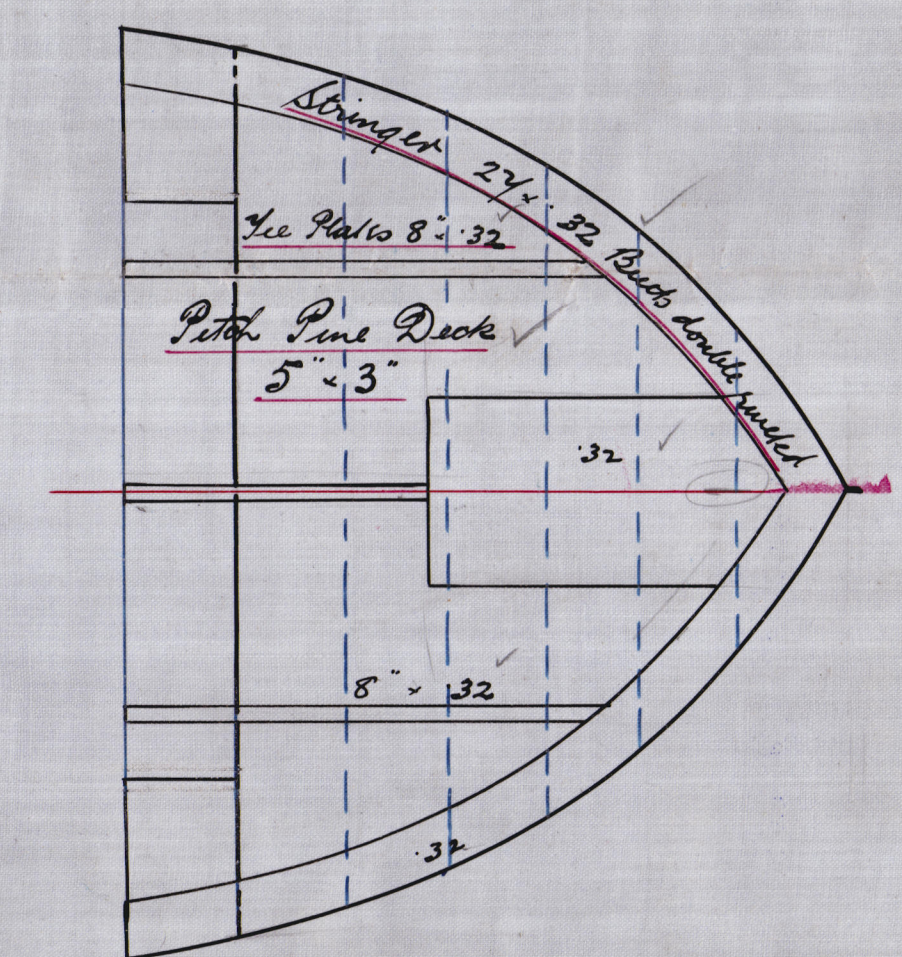

UPPER DECK

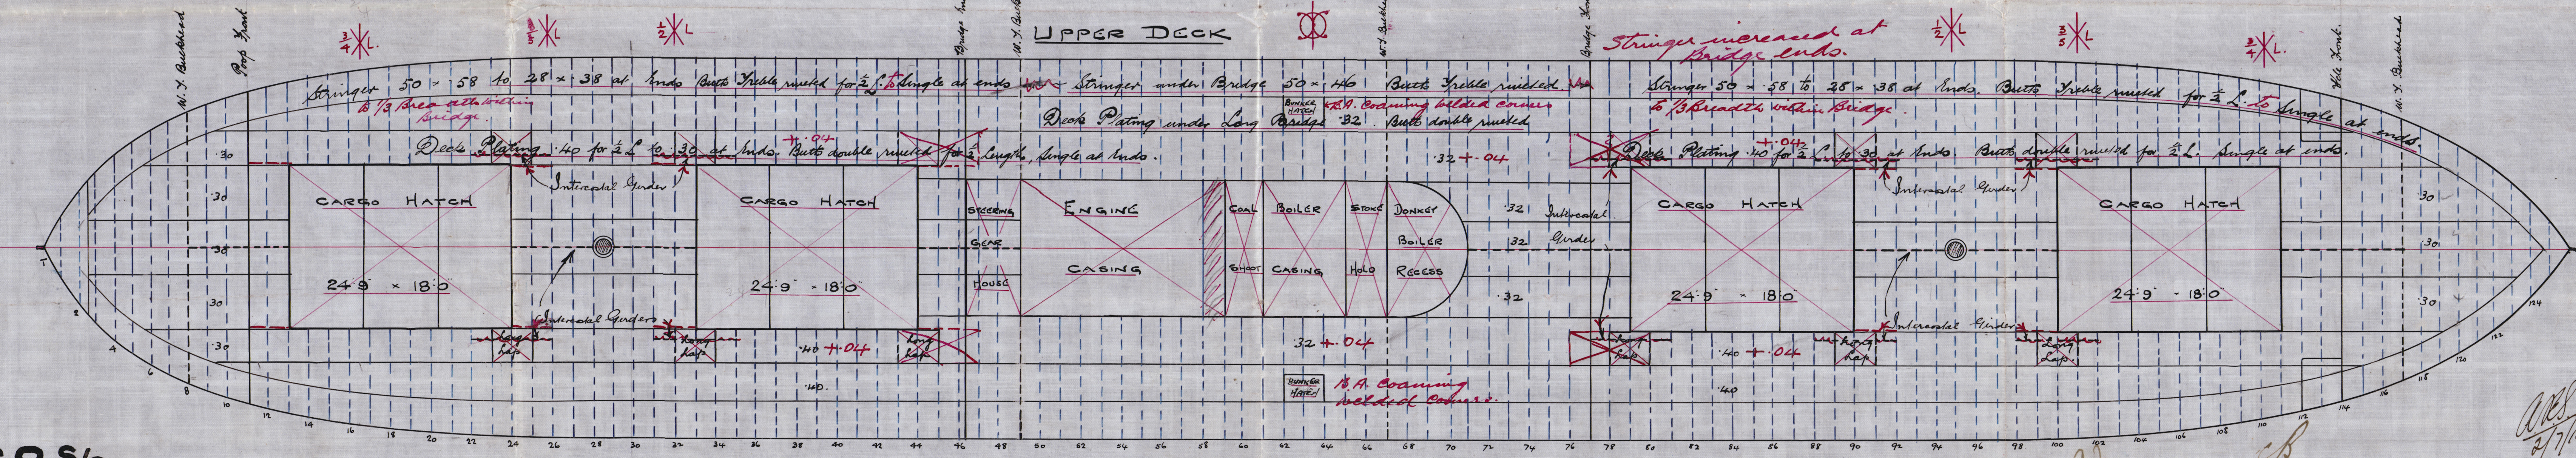

No 168 s/s.

2/7/10.

Wood Skinner & Co


S. S. No. 168.

Deck plan

S. S. "HUNNIA"

NEWCASTLE - ON - TYNE

REPORT No 60120.

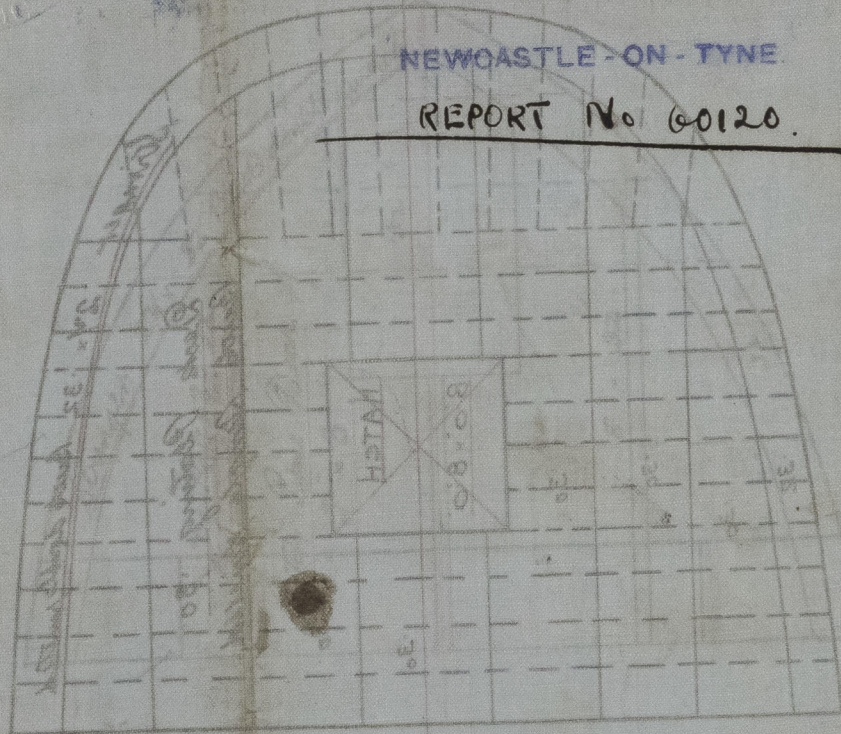

Deck Plan

PROPOSED

OF



© 2020

Lloyd's Register
Foundation