

8. 7. 10

A circular purple ink stamp. The outer ring contains the text "WOOD, SKINNER & CO. LTD." at the top and "NEWCASTLE-ON-TYNE" at the bottom, separated by two small stars. The inner circle contains the text "BILL QUAY" at the top, the date "30 JUN 1919" in the center, and "SHIPBUILDING YARD" at the bottom.


Single Angles to Centre Girder

Top Angles $3\frac{1}{2}^\circ + 3\frac{1}{2}^\circ = 50$ to 46 In Boiler Space 60 and double Angles under Engines


Bottom Angles $4\frac{1}{2} \times 4\frac{1}{2} \times 60$ to 56

Tank Top in Hold 36 to 30 In Engine Space 42 In Boiler Space 52

12 Rivets at Ford
end for $\frac{1}{4}$ L.

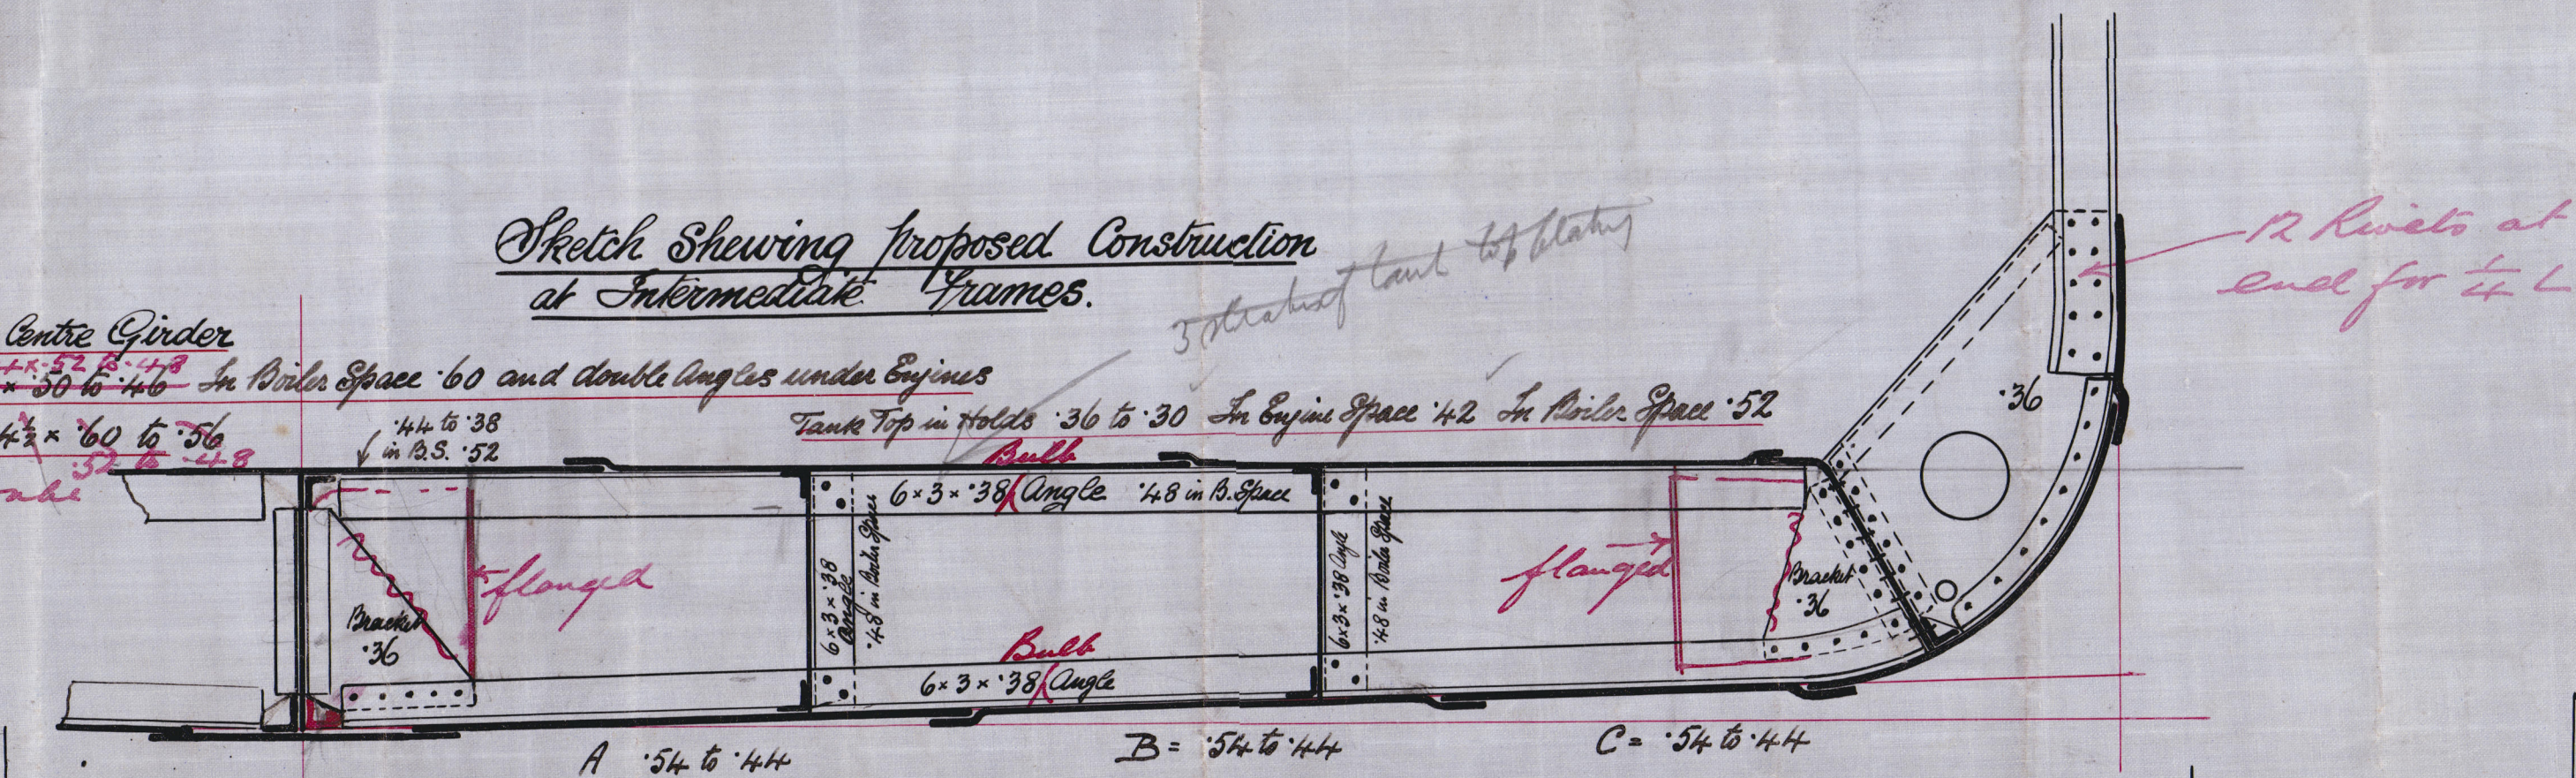

Tank top arranged with three struts of plating there: -

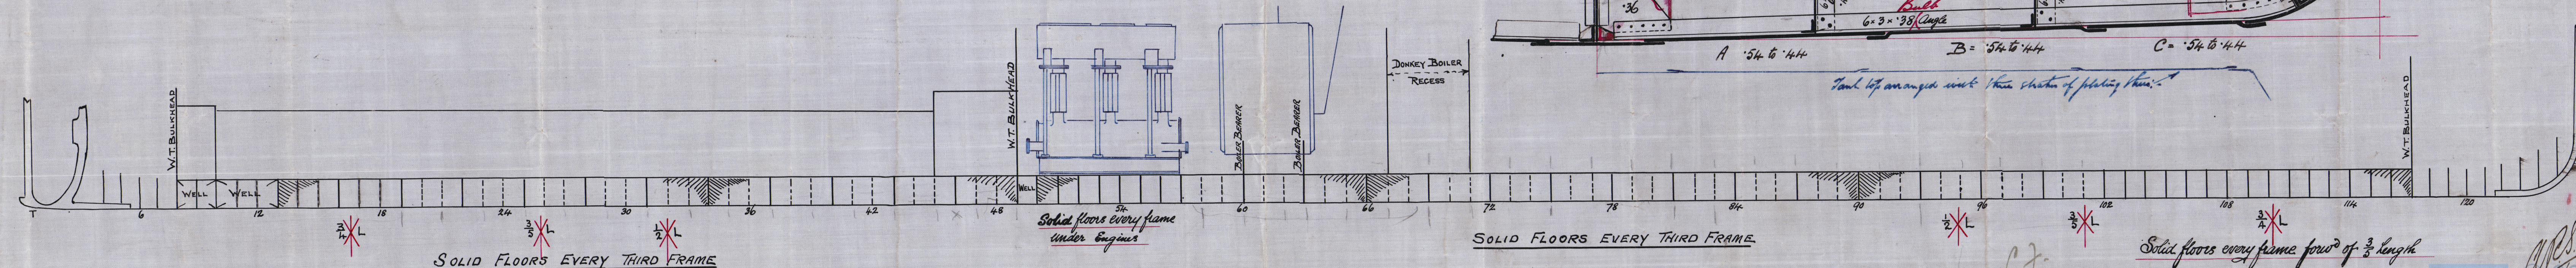

N^o 168 SHIP.

Wood Skinner & Co



P. S. No 68.

Alternative Section & Profile
showing floors in way 3rd frame.

S.S. HUNNYIA

NEWCASTLE-ON-TYNE

REPORT NO 60120.

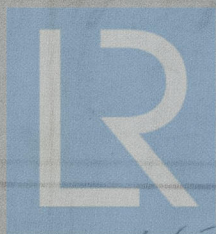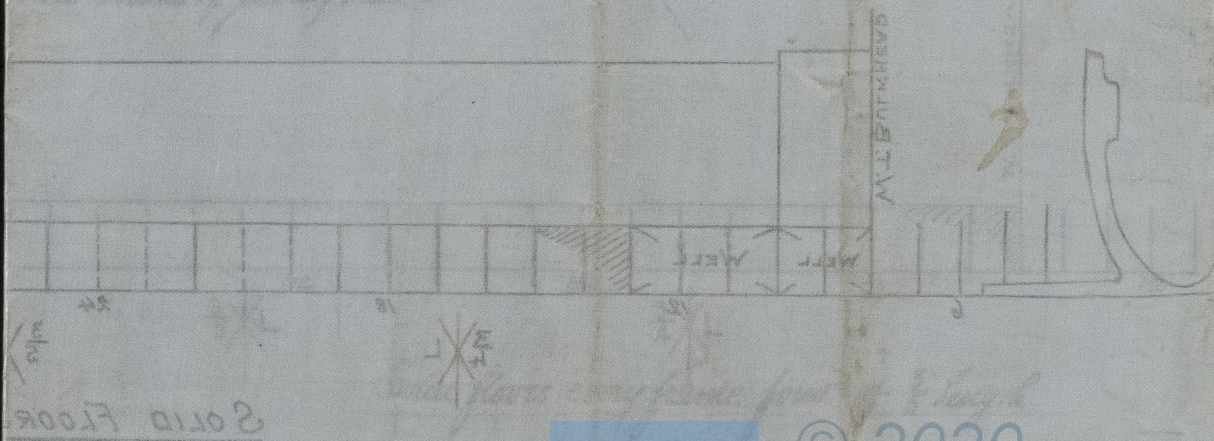

© 2020

Lloyd's Register
Foundation

06248-006251-0153