


BRASS PINTLE BUSHING
FINISH ALL OVER

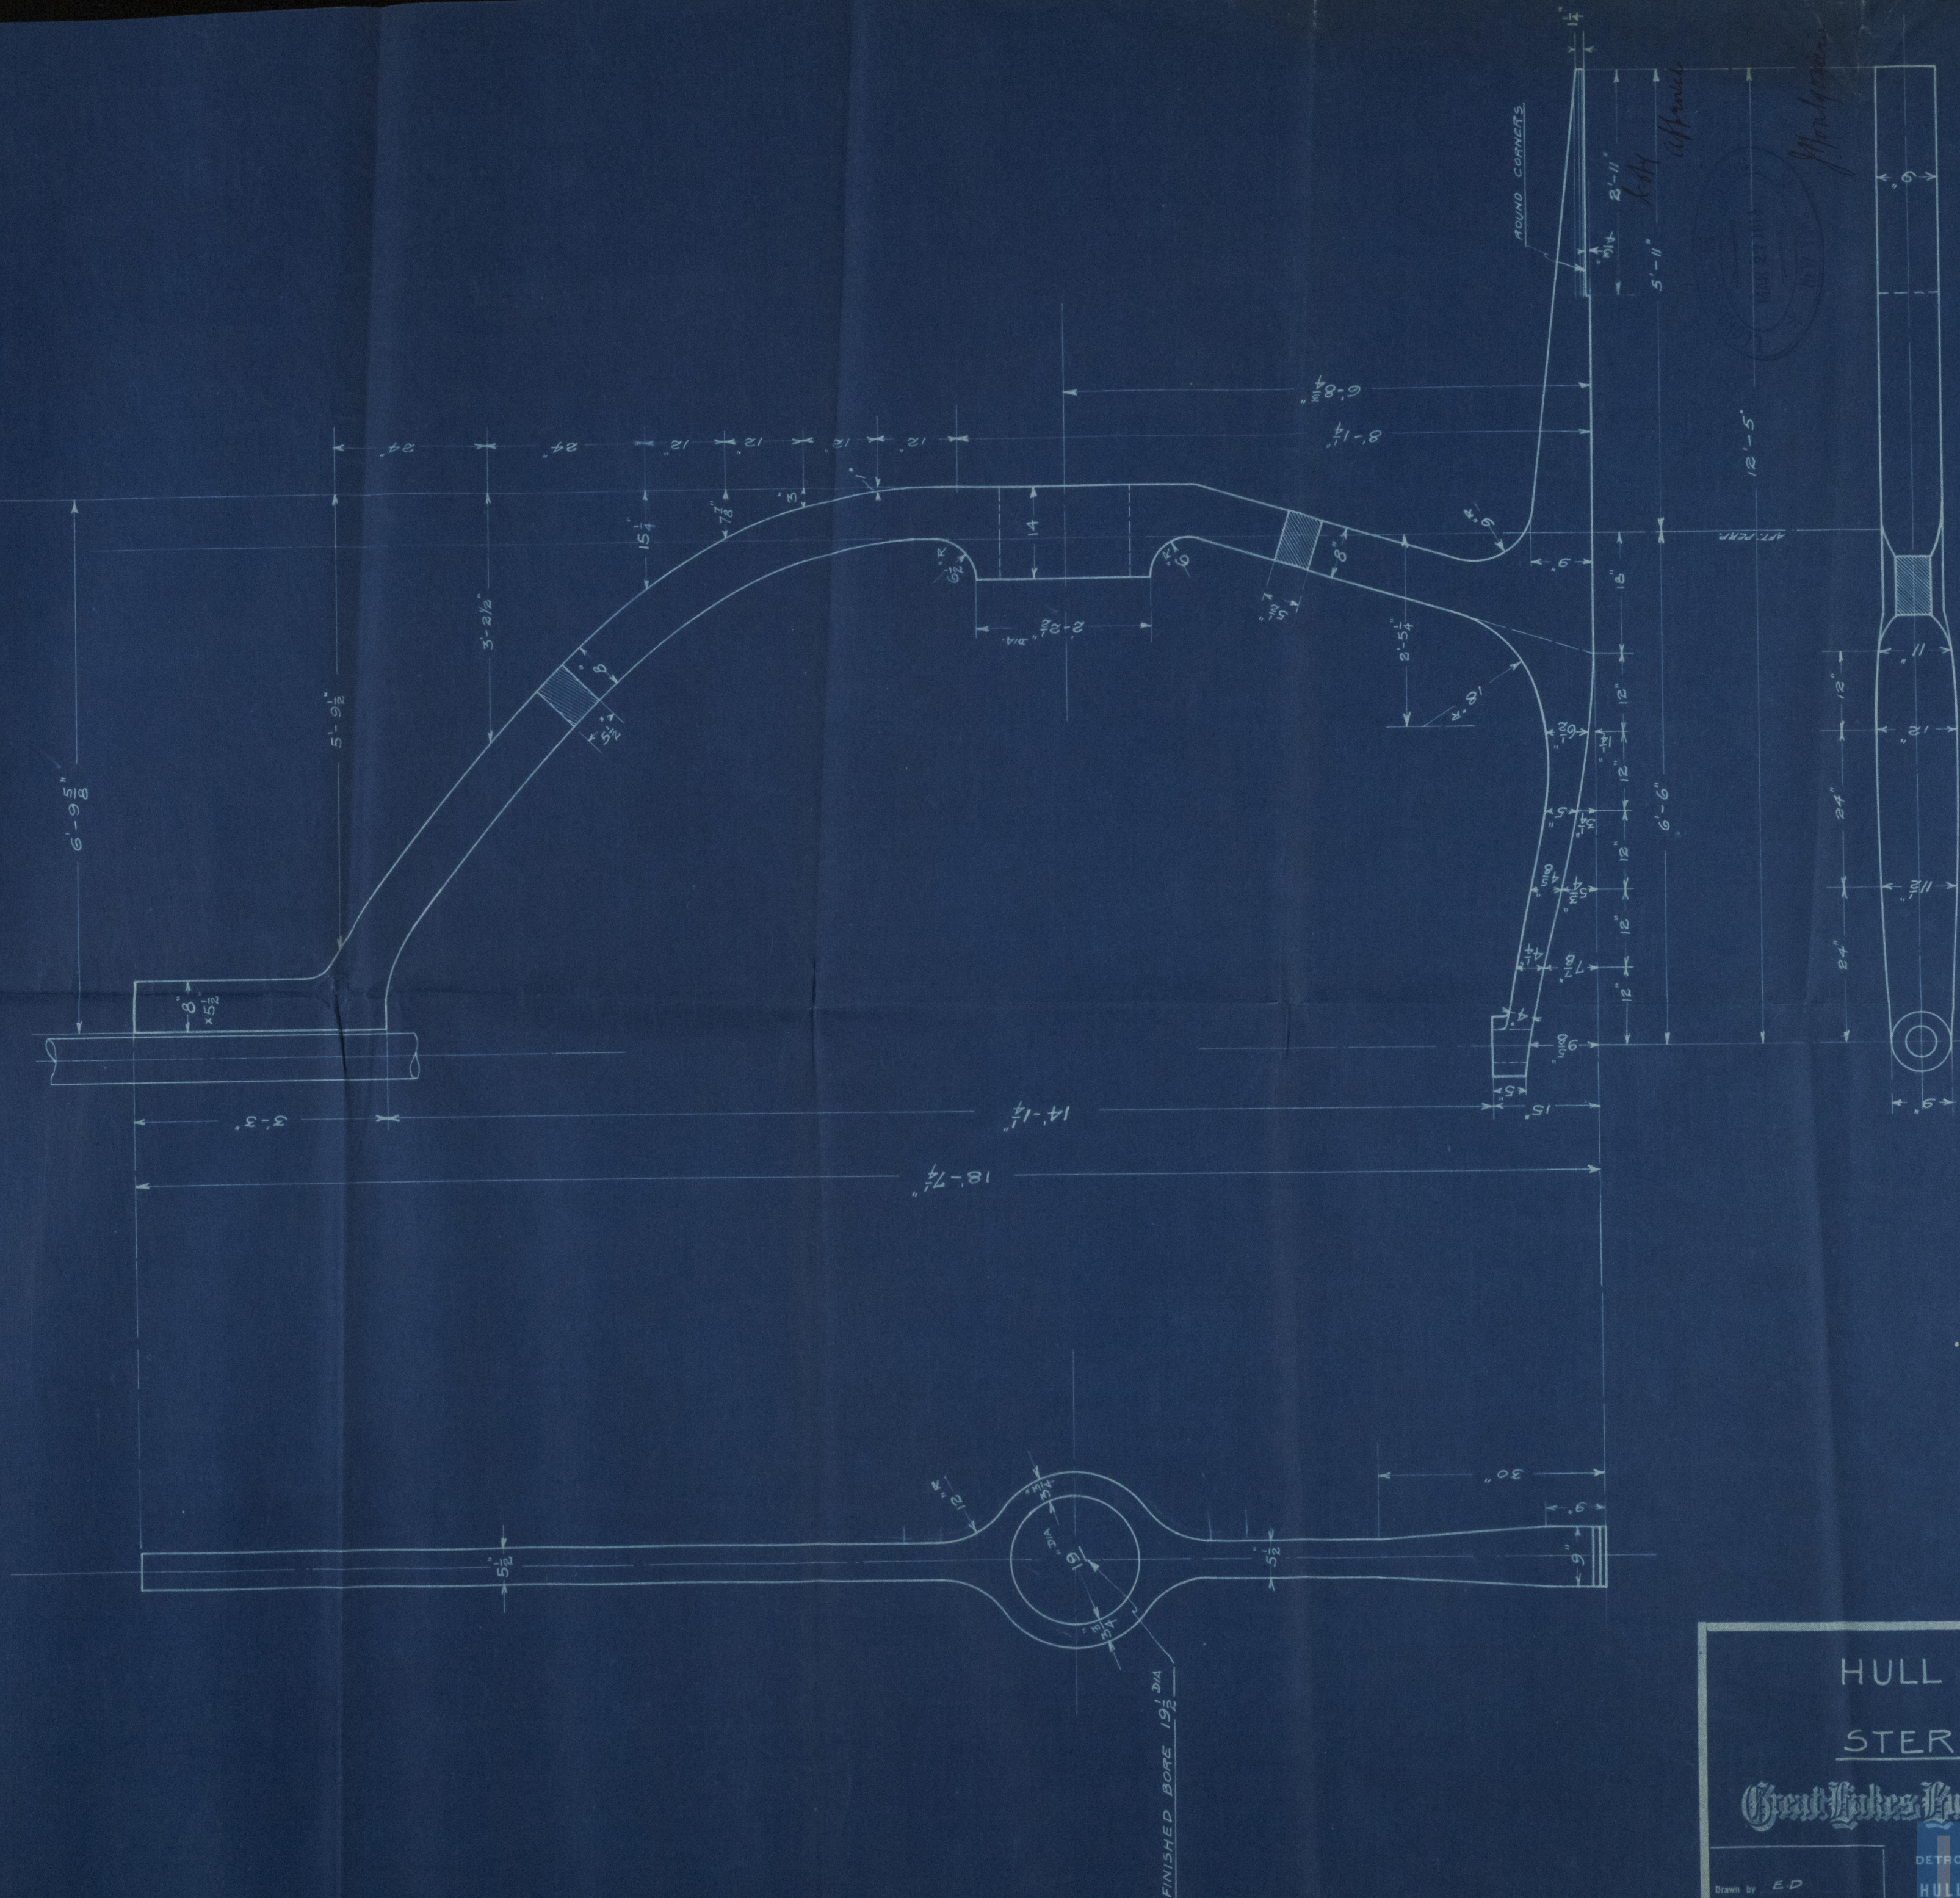

NOTE: BASE LINE 1/4" ABOVE BOTTOM OF POST


HULL No. 135	
STERN POST	
Great Lakes Engineering Works.	
Drawn by E.D.	Checked by H.C.
Traced by E.D.	Date MARCH 19-1914
DETROIT, MICH. HULL DEPT.	
Scale 3/4" = 1' - 0"	

135-302

Clr

MAR 24 1914

STERN
Post

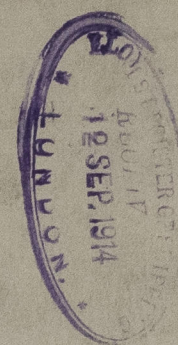

006248-0062570208



© 2020

Lloyd's Register
Foundation