



21.7.13

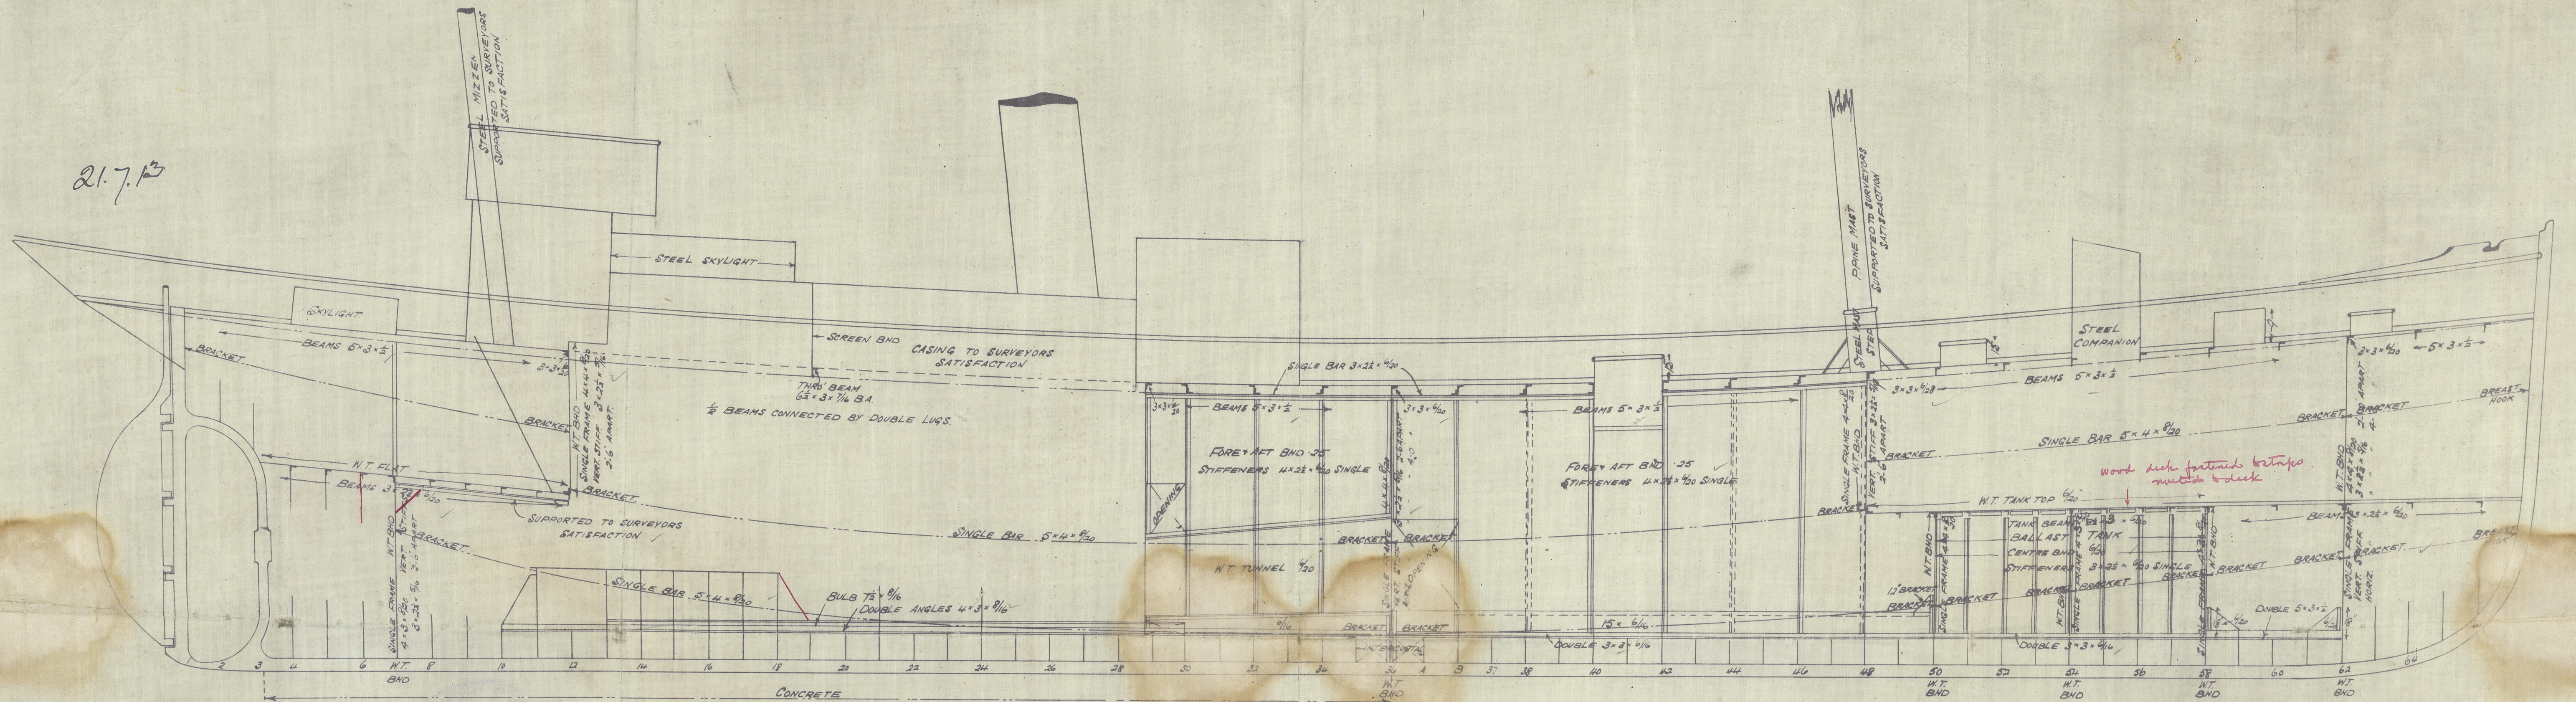

# BEAM ARRANGEMENT.



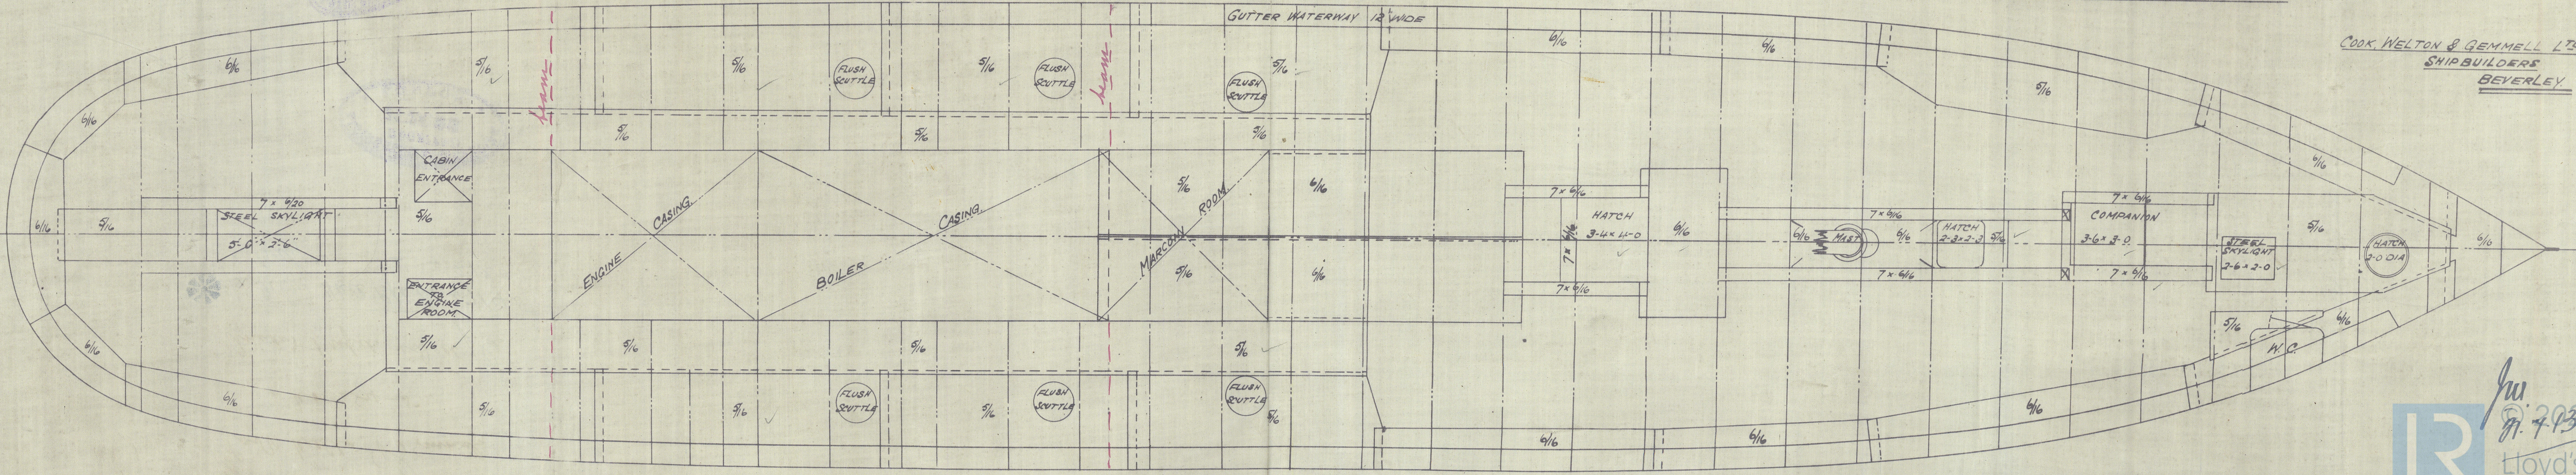



No 254-5

Amended Profile & Deck plan.

\*s/s. Fley Hull Rph No. 27145  
" Beampton - - - 27202



006172-006180-0140

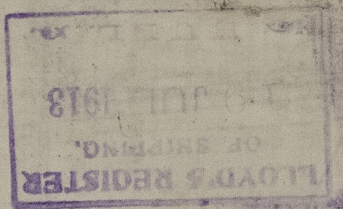

© 2020  
Lloyd's Register  
Foundation

1.28  
5.12

4.32  
12  
98.